

Survey for
John Stang

Village Lots 35-36, Amherst Village


Lorain Co., Ohio.

Oct. 25, 1919. Warden & Laundon.

Scale 1 inch = 50 feet. Engineers

PPN 05-00-024-102-???

MAP PG 5-00-024-A

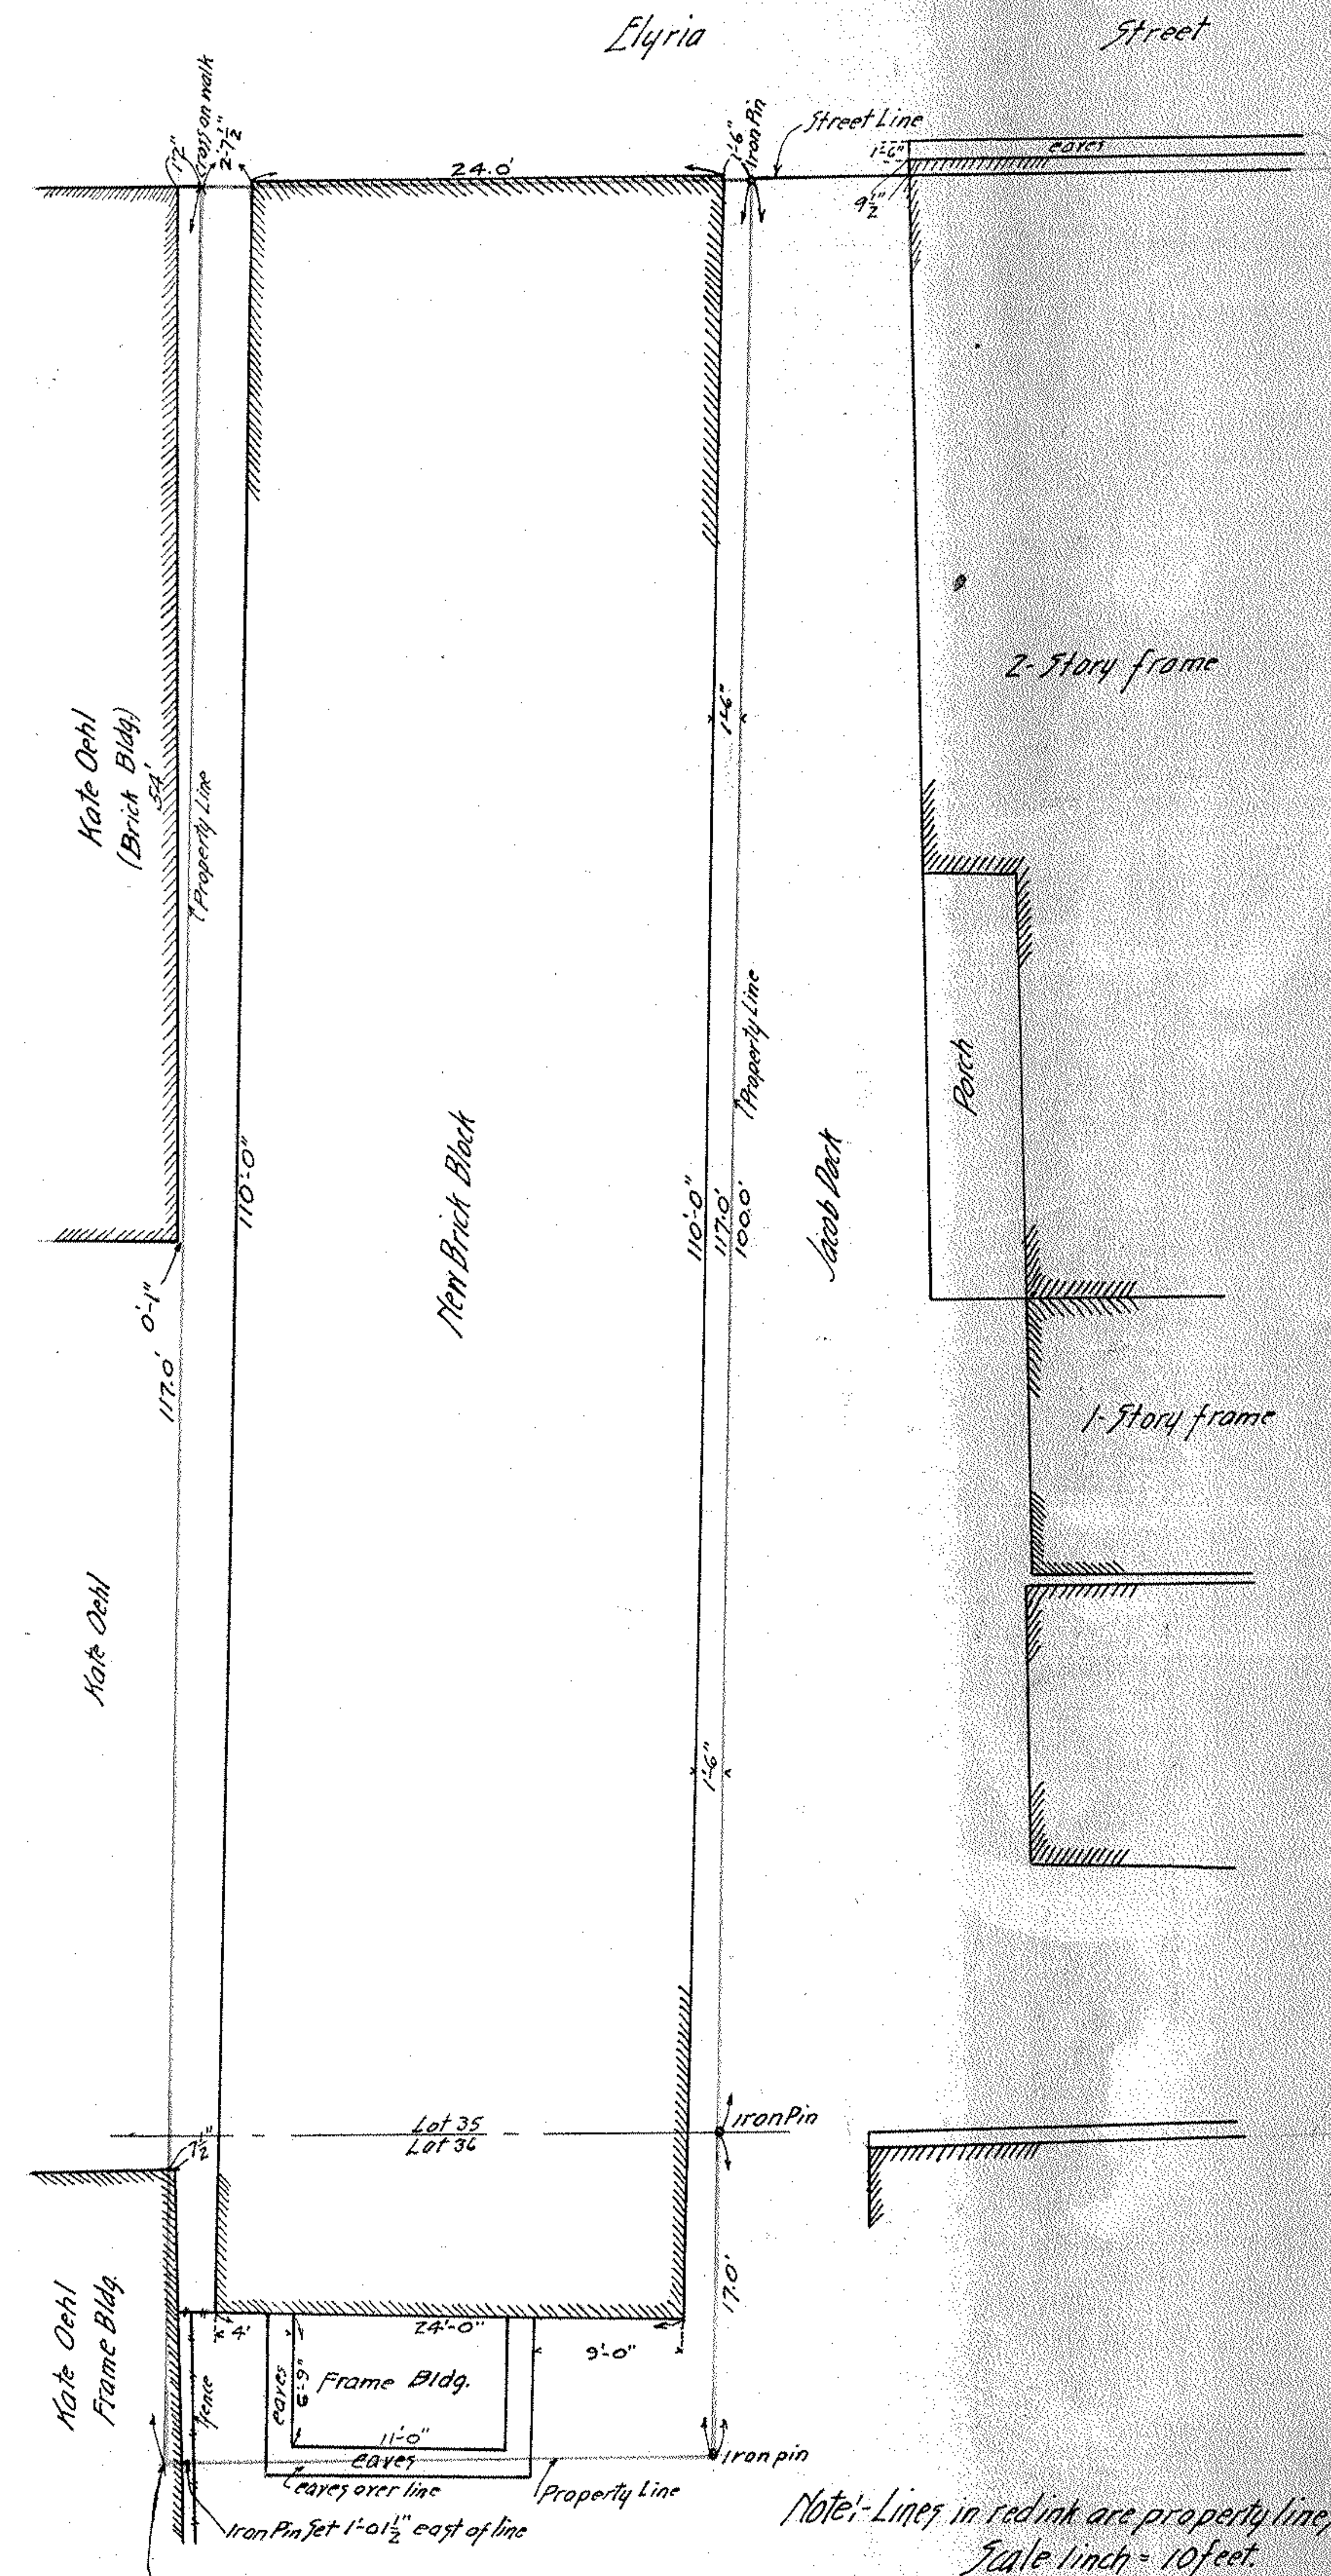

Note: Frame Bldg. encroaches here 0'-11" at north end of frame Bldg. the encroachment is 0'-7 1/2". Eaves over-hang line also, and are about 12 inches in width.

Note: Lines in red ink are property lines - 28.13 x 117.0.
Scale 1 inch = 10 feet.