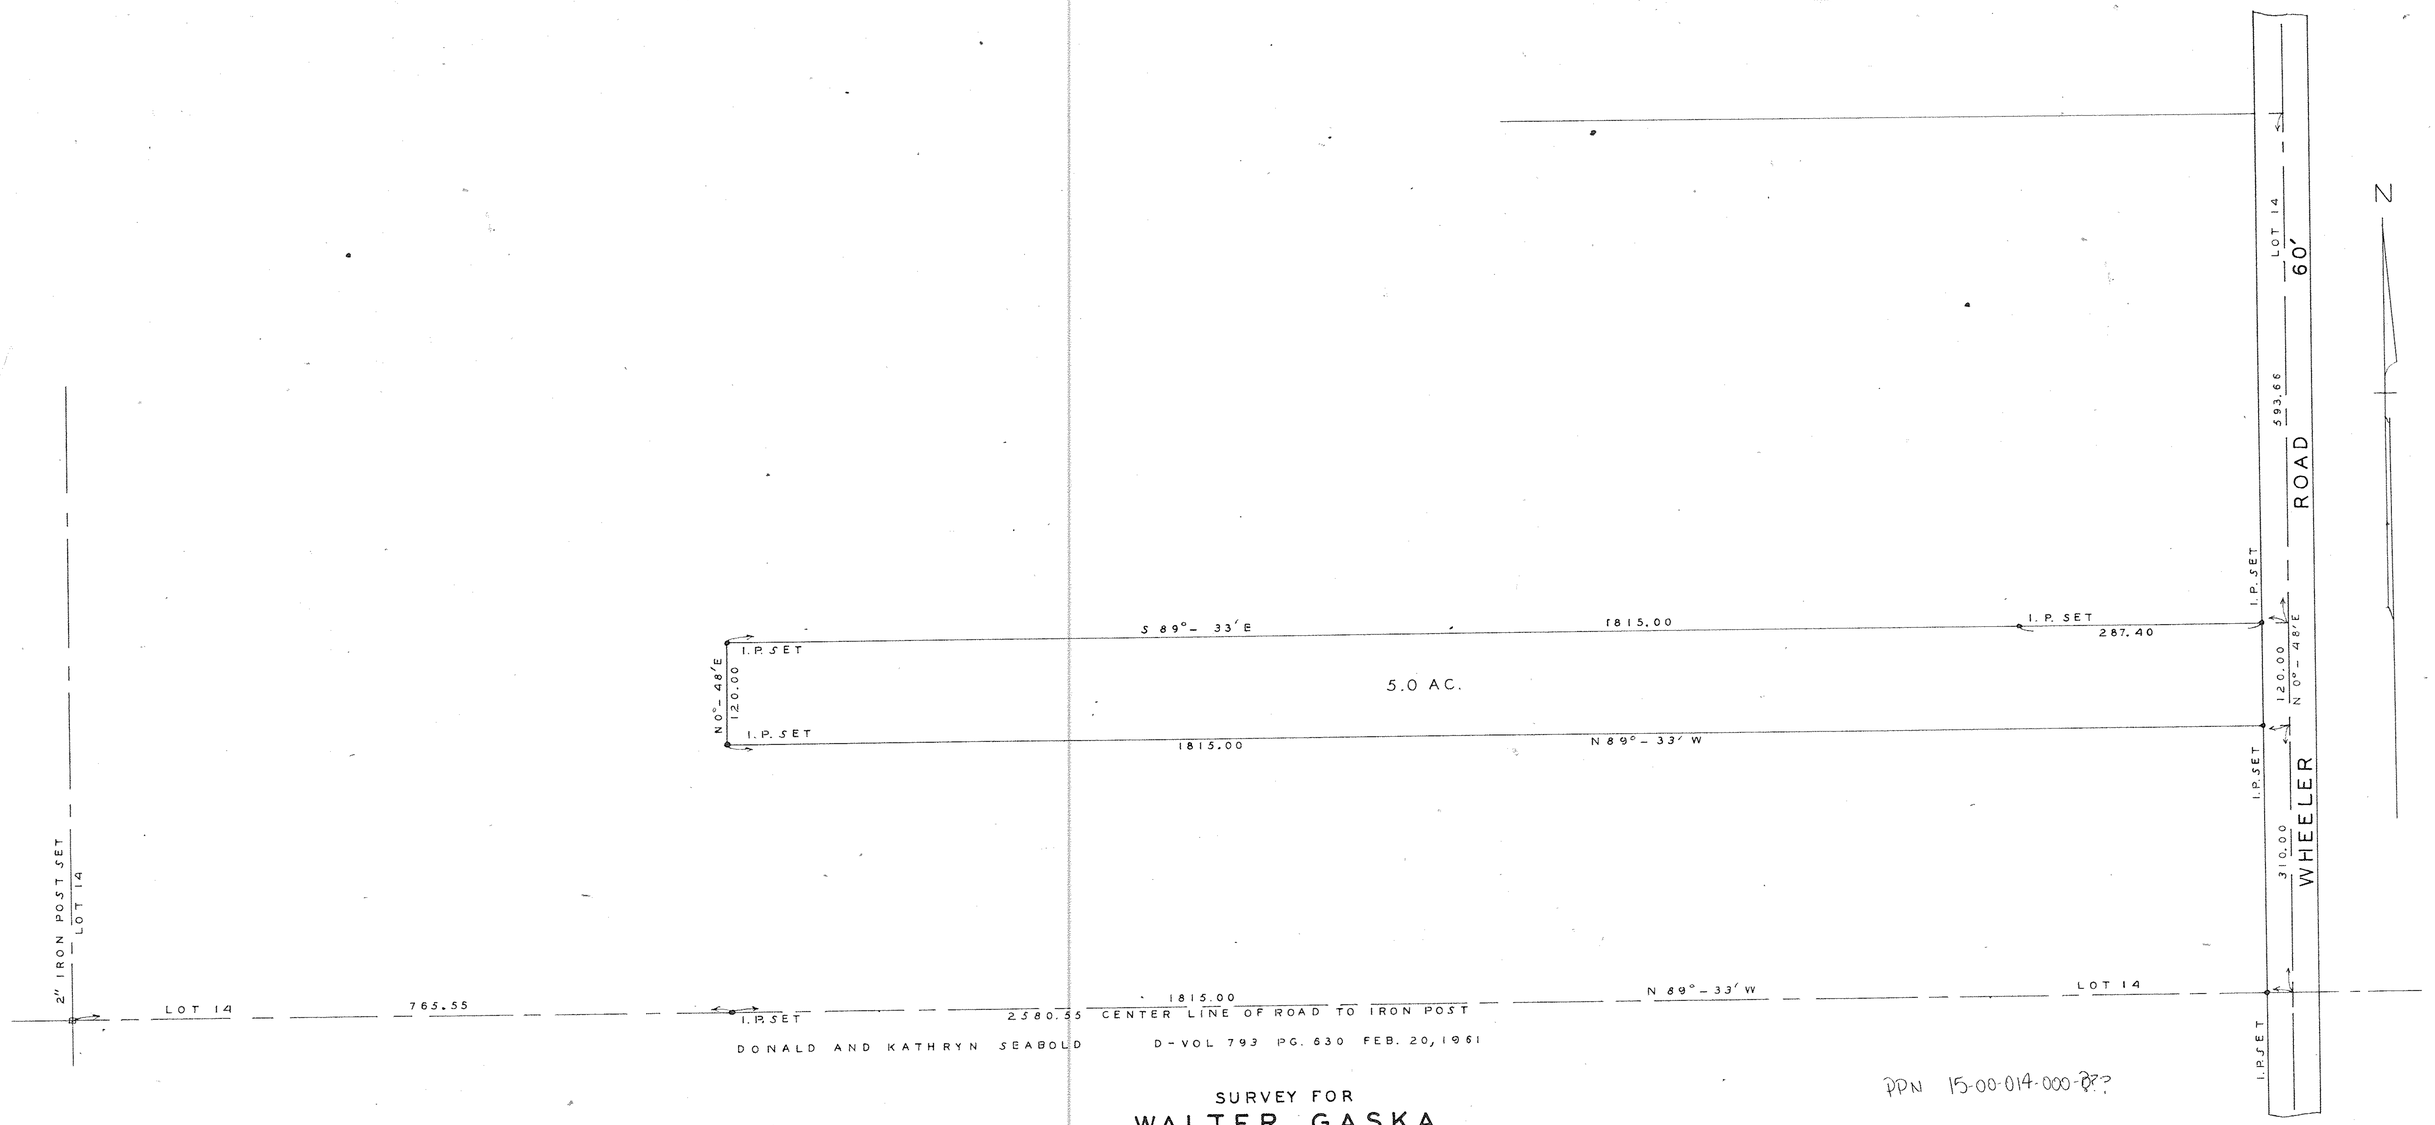

SURVEY FOR

WALTER GASKA

D-VOL 592 PG. 390 DEC. 11, 1953
O. L. 14 LAGRANGE TOWNSHIP
LORAIN COUNTY, OHIO
SCALE 1" = 100' JUNE 13, 1963
J. W. WARDEN AND ASSOCIATES
REG. SURVEYORS

PPN 15-00-014-000-??

MAP PG 15-00-014-B

STATE OF OHIO
J. W. WARDEN
3969
REGISTERED
SURVEYOR