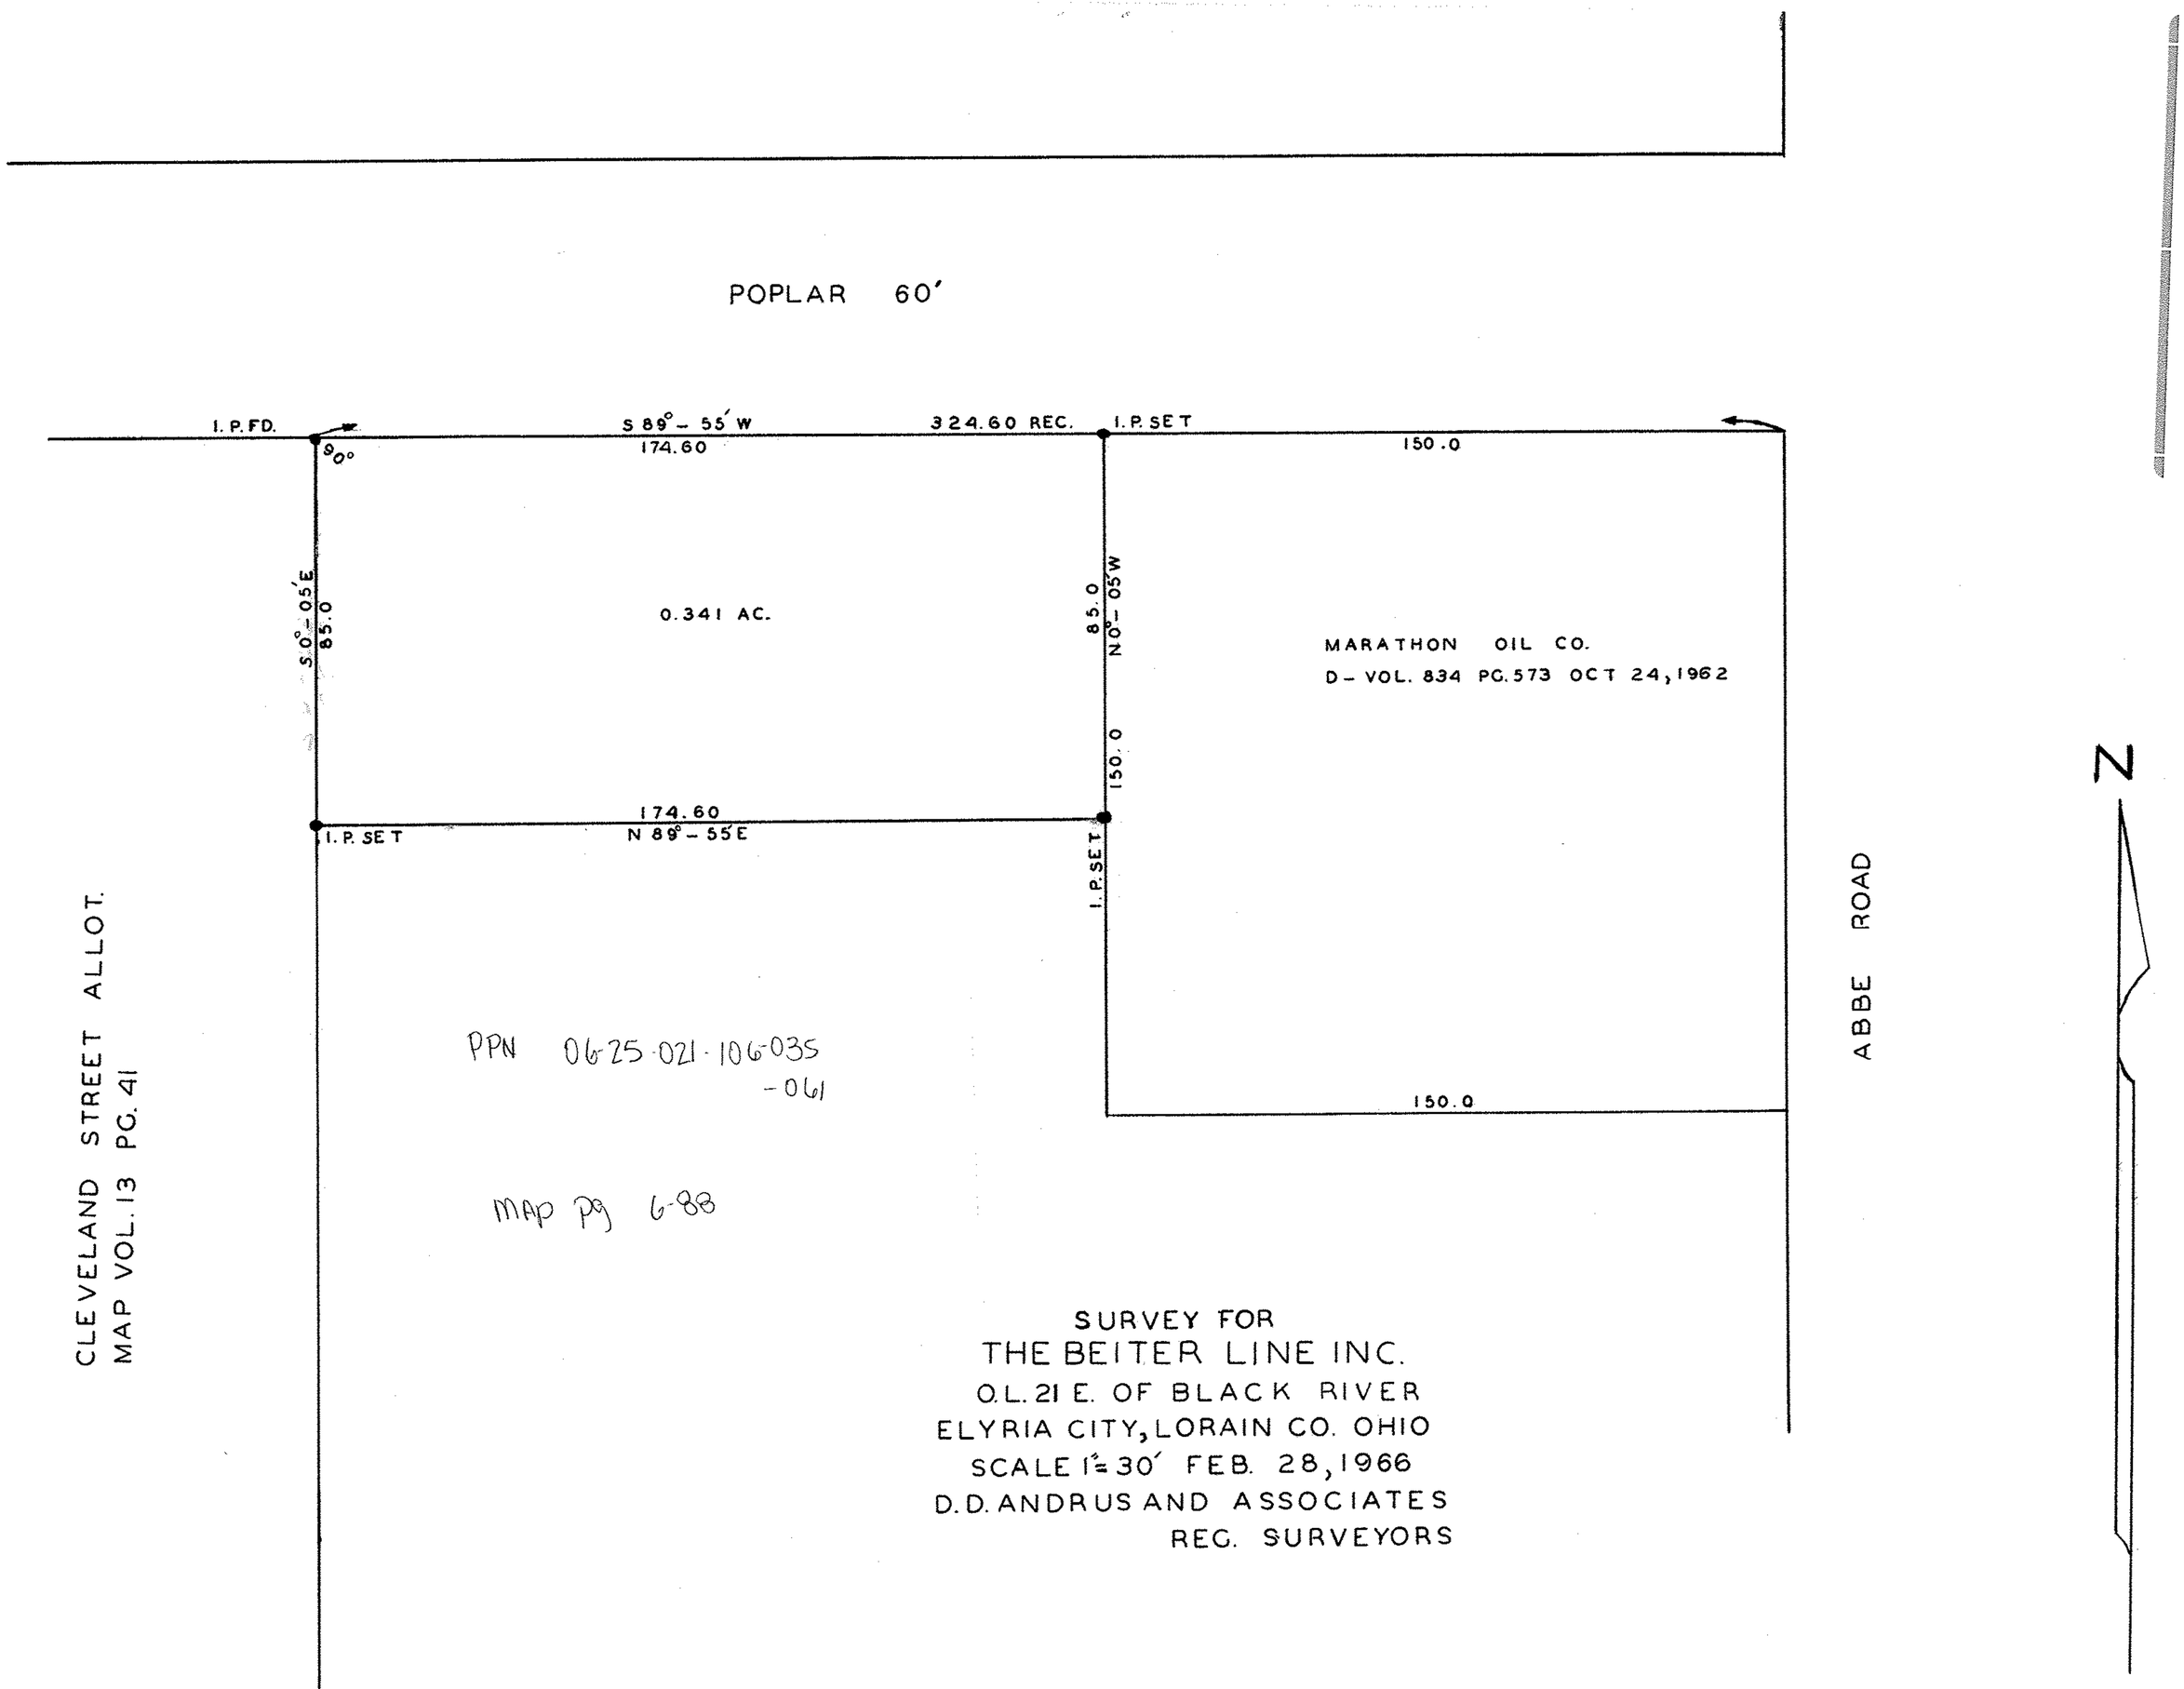
POPLAR 60'
I. P. FD.
S 89° - 55' W
174.60
324.60 REC.
I. P. SET
150.0
90°
S 0° - 05' E
85.0
0.341 AC.
85.0
N 0° - 05' W
MARATHON OIL CO.
D - VOL. 834 PG. 573 OCT 24, 1962
150.0
174.60
N 89° - 55' E
I. P. SET
I. P. SET
150.0
CLEVELAND STREET ALLOT.
MAP VOL. 13 PG. 41
ABBE ROAD
N
PPN 06-25-021-106-035
-061
MAP pg 6-88
SURVEY FOR
THE BEITER LINE INC.
O.L. 21 E. OF BLACK RIVER
ELYRIA CITY, LORAIN CO. OHIO
SCALE 1" = 30' FEB. 28, 1966
D. D. ANDRUS AND ASSOCIATES
REG. SURVEYORS

401479A