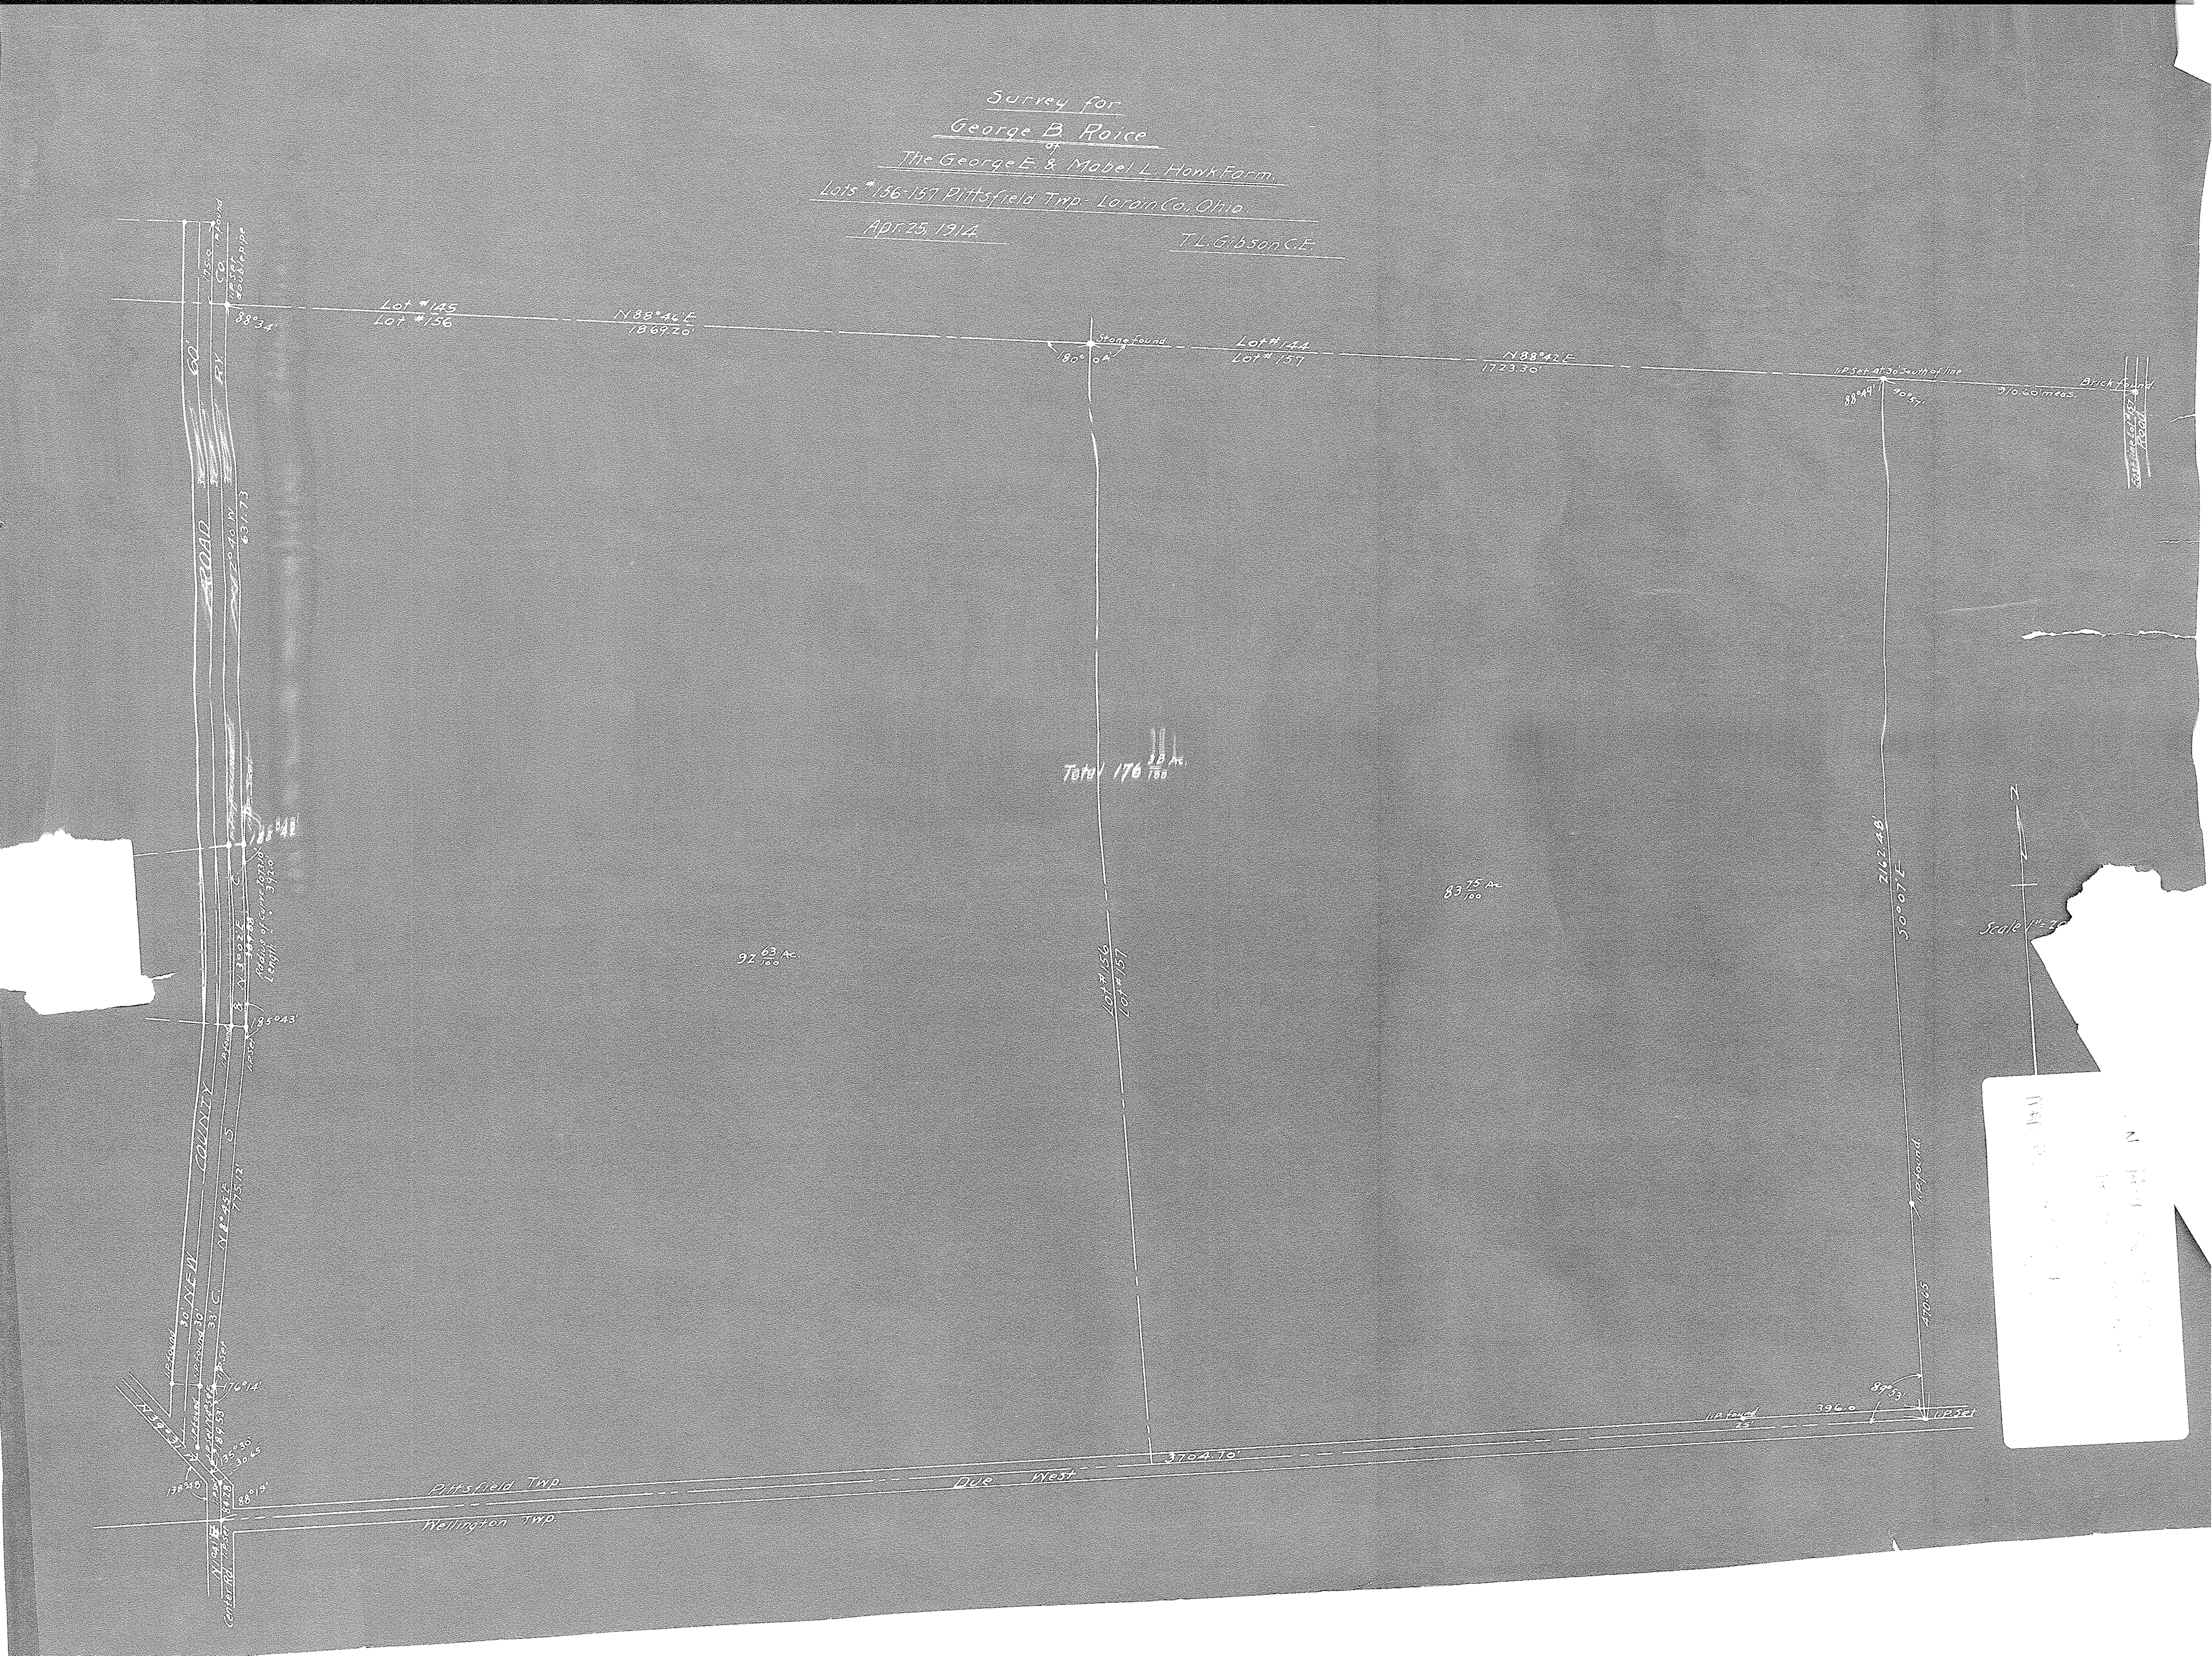
Survey for
George B. Roice
of
The George E. & Mabel L. Hawk Farm.
Lots # 156-157 Pittsfield Twp. - Lorain Co. Ohio.
Apr. 25, 1914.
T. L. Gibson C.E.
Lot #145
Lot #156
N 88°46' E
1869.20'
88°34'
Stone found
180°04'
Lot #144
Lot #157
N 88°42' E
1723.30'
I.P. Set At 30' South of line
88°49'
90°57'
910.60' meas.
Brick found
East line Lot #157
Road
60'
ROAD
Co.
R.Y.
175.0
I.P. found
I.P. Set double pipe
N 2°40' W
631.73
85°48'
C
Radius of curve 7073.10
Length 392.0
N 3°02' E
8
185°43'
I.P. found
I.P. Set
COUNTY
NEW
S
N 8°45' E
775.12'
30'
33'
C.
I.P. found
I.P. Set
176°14'
N 39°37'
189°53'
135°30'
30.65'
138°48'
88°19'
Center Rd.
Pittsfield Twp.
Wellington Twp.
Due West
3704.70'
Total 176 38/100 Ac.
92 63/100 Ac.
83 75/100 Ac.
Lot #156
Lot #157
2162.48'
S 0°07' E
I.P. found
470.65
89°53'
396.0
I.P. found
25'
I.P. Set
N
Scale 1" = 3