


4-142

Judson S. & Ella E. Clifford
D. Vol. 180 - Pg. 139 - Oct. 22, 1921.

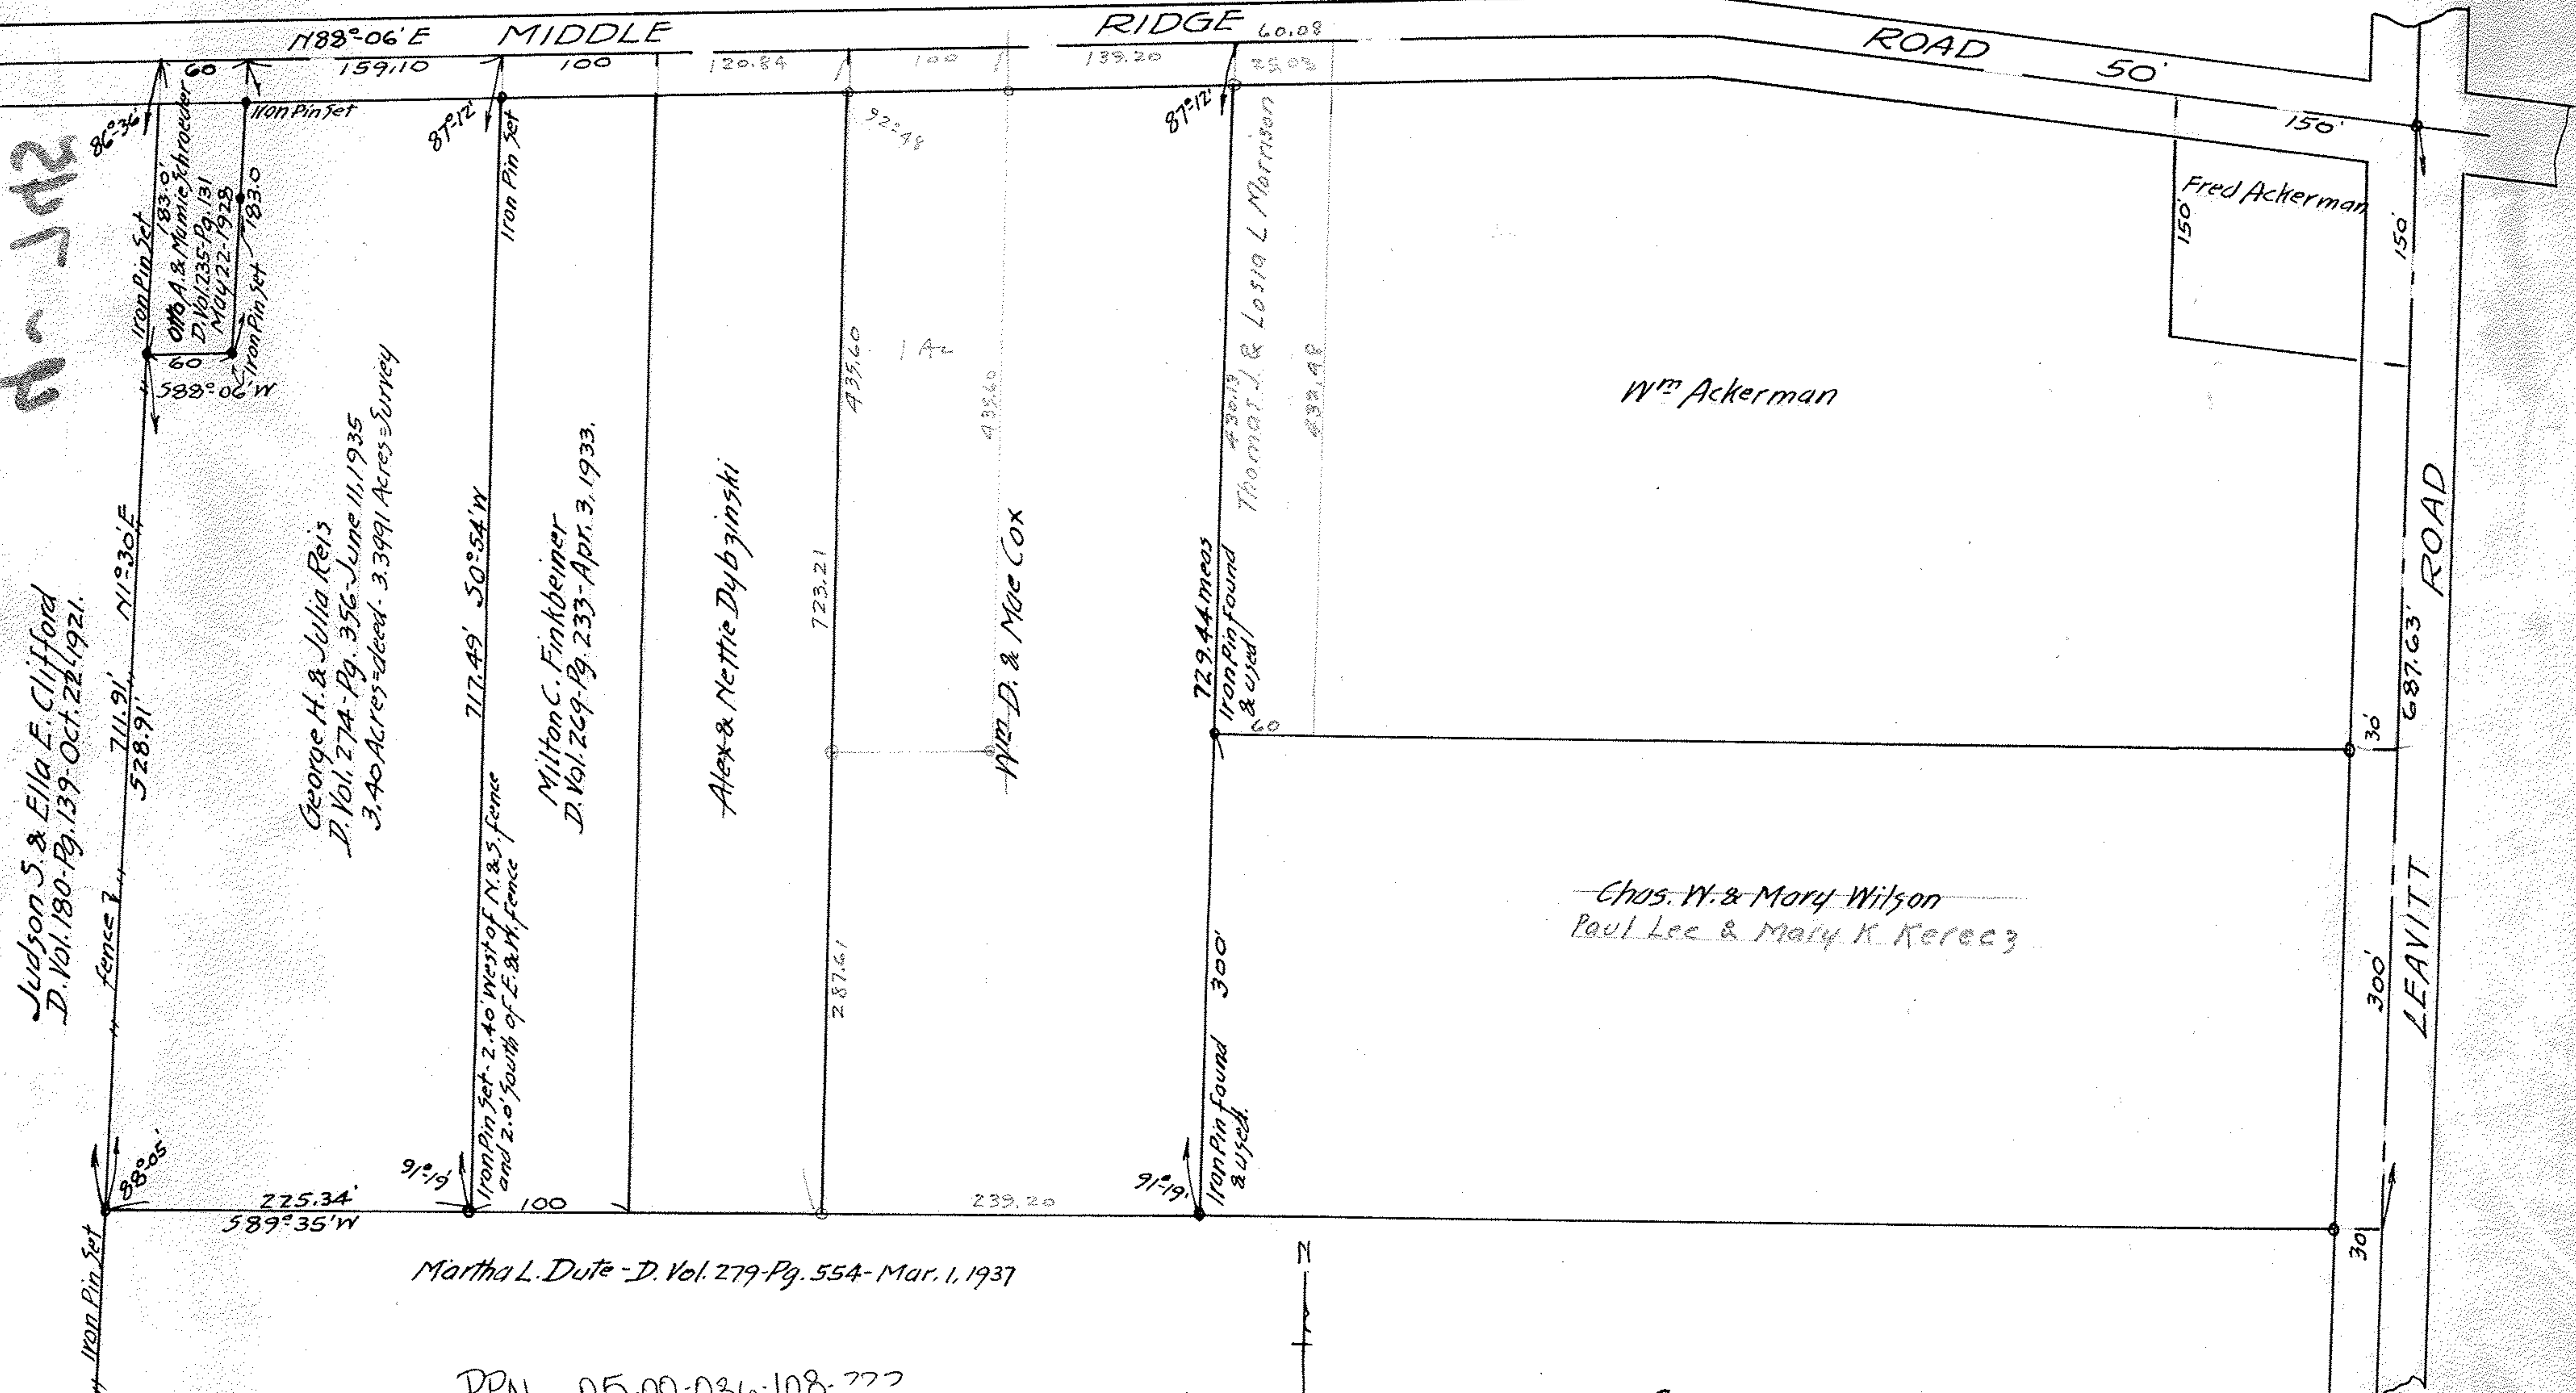

Iron Pin Set
58°05'

fence
711.91' N1°30'E
528.91'

George H. & Julia Reis
D. Vol. 274 - Pg. 356 - June 11, 1935
3.40 Acres - deed - 3.3991 Acres - Survey

Iron Pin Set - 2.40 West of N. & S. fence
and 2.0' South of E. & W. fence
717.49' S0°54'W

Milton C. Finkbeiner
D. Vol. 269 - Pg. 233 - Apr. 3, 1933.

Alex & Nettie Dybzinski

Wm. D. & Mae Cox

Iron Pin found 300'
& used.
729.44 meas
Iron Pin found
430.13
& used
Thomas J. & Lusia L. Morrison
432.49

Chas. W. & Mary Wilson
Paul Lee & Mary K. Kerecz

Fred Ackerman
150'
150'

LEAVITT ROAD
687.63'

Martha L. Dute - D. Vol. 279 - Pg. 554 - Mar. 1, 1937

PPN 05-00-036-108-???

MAP pg 5-00-036-B

Survey for
Georgette & Julia Reis.
Lot 36, Amherst Twp.,
Lorain Co., Ohio.
Aug 18, 1937. Scale 1" = 100ft.
J. W. Warden - Registered Surveyor.

