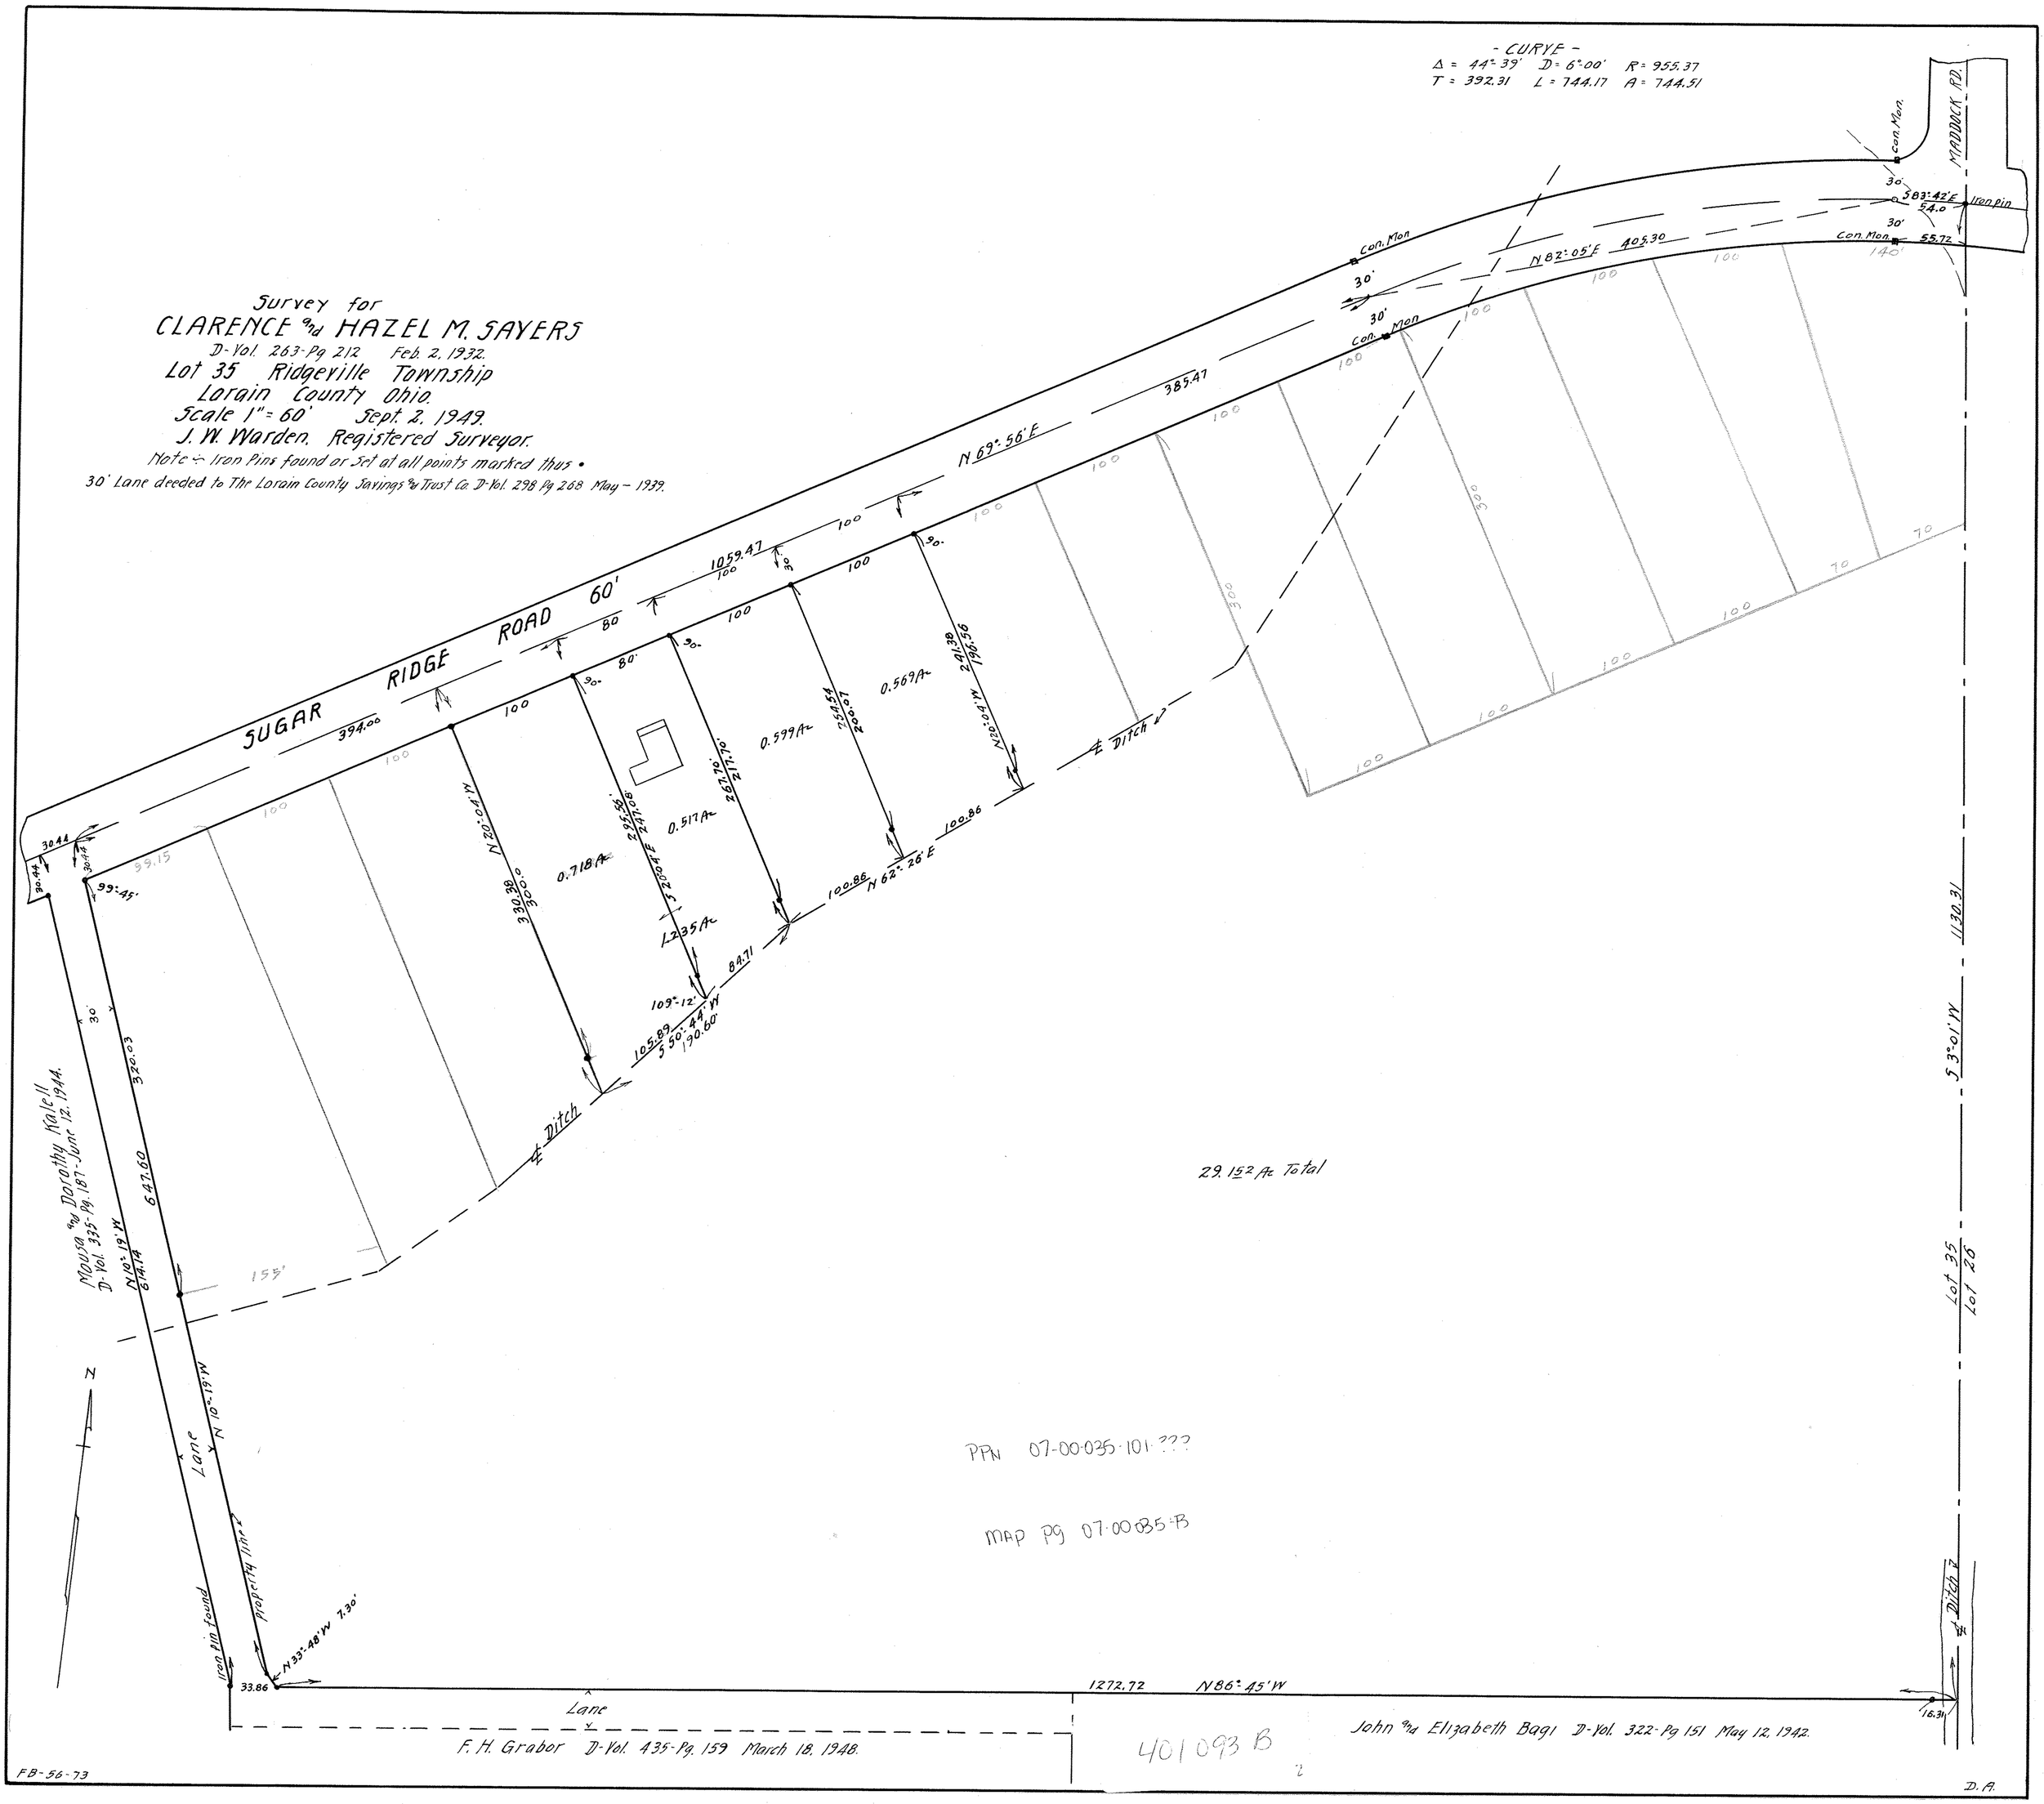
- CURVE -
Δ = 44°-39' D = 6°-00' R = 955.37
T = 392.31 L = 744.17 A = 744.51
Survey for
CLARENCE and HAZEL M. SAYERS
D-Vol. 263-Pg 212 Feb. 2, 1932.
Lot 35 Ridgeville Township
Lorain County Ohio.
Scale 1" = 60' Sept. 2, 1949.
J. W. Warden, Registered Surveyor.
Note - Iron Pins found or Set at all points marked thus •
30' Lane deeded to The Lorain County Savings & Trust Co. D-Vol. 298 Pg 268 May - 1939.
SUGAR RIDGE ROAD 60'
MADDUX RD.
N 69°-56' E
385.47
N 82°-05' E 405.30
S 83°-42' E 54.0
Iron Pin
55.72
Con. Mon.
Ditch
N 20°-04' W
N 62°-26' E
S 50°-44' W
S 3°-01' W
1130.31
Lot 35
Lot 26
29.152 Ac Total
Mousa and Dorothy Kalc
D-Vol. 335-Pg. 187-June 12, 1944.
N 10°-19' W
647.60
N 10°-19' W
Lane
Property line
N 33°-48' W 7.30'
33.86
1272.72 N 86°-45' W
16.31
Lane
F. H. Grabor D-Vol. 435-Pg. 159 March 18, 1948.
John and Elizabeth Bagi D-Vol. 322-Pg 151 May 12, 1942.
PPN 07-00-035-101-???
MAP Pg 07-00-035-B
401093 B
FB-56-73
D.A.