


PPN 07-00-014-104-???

map Pg 7-00-014-B

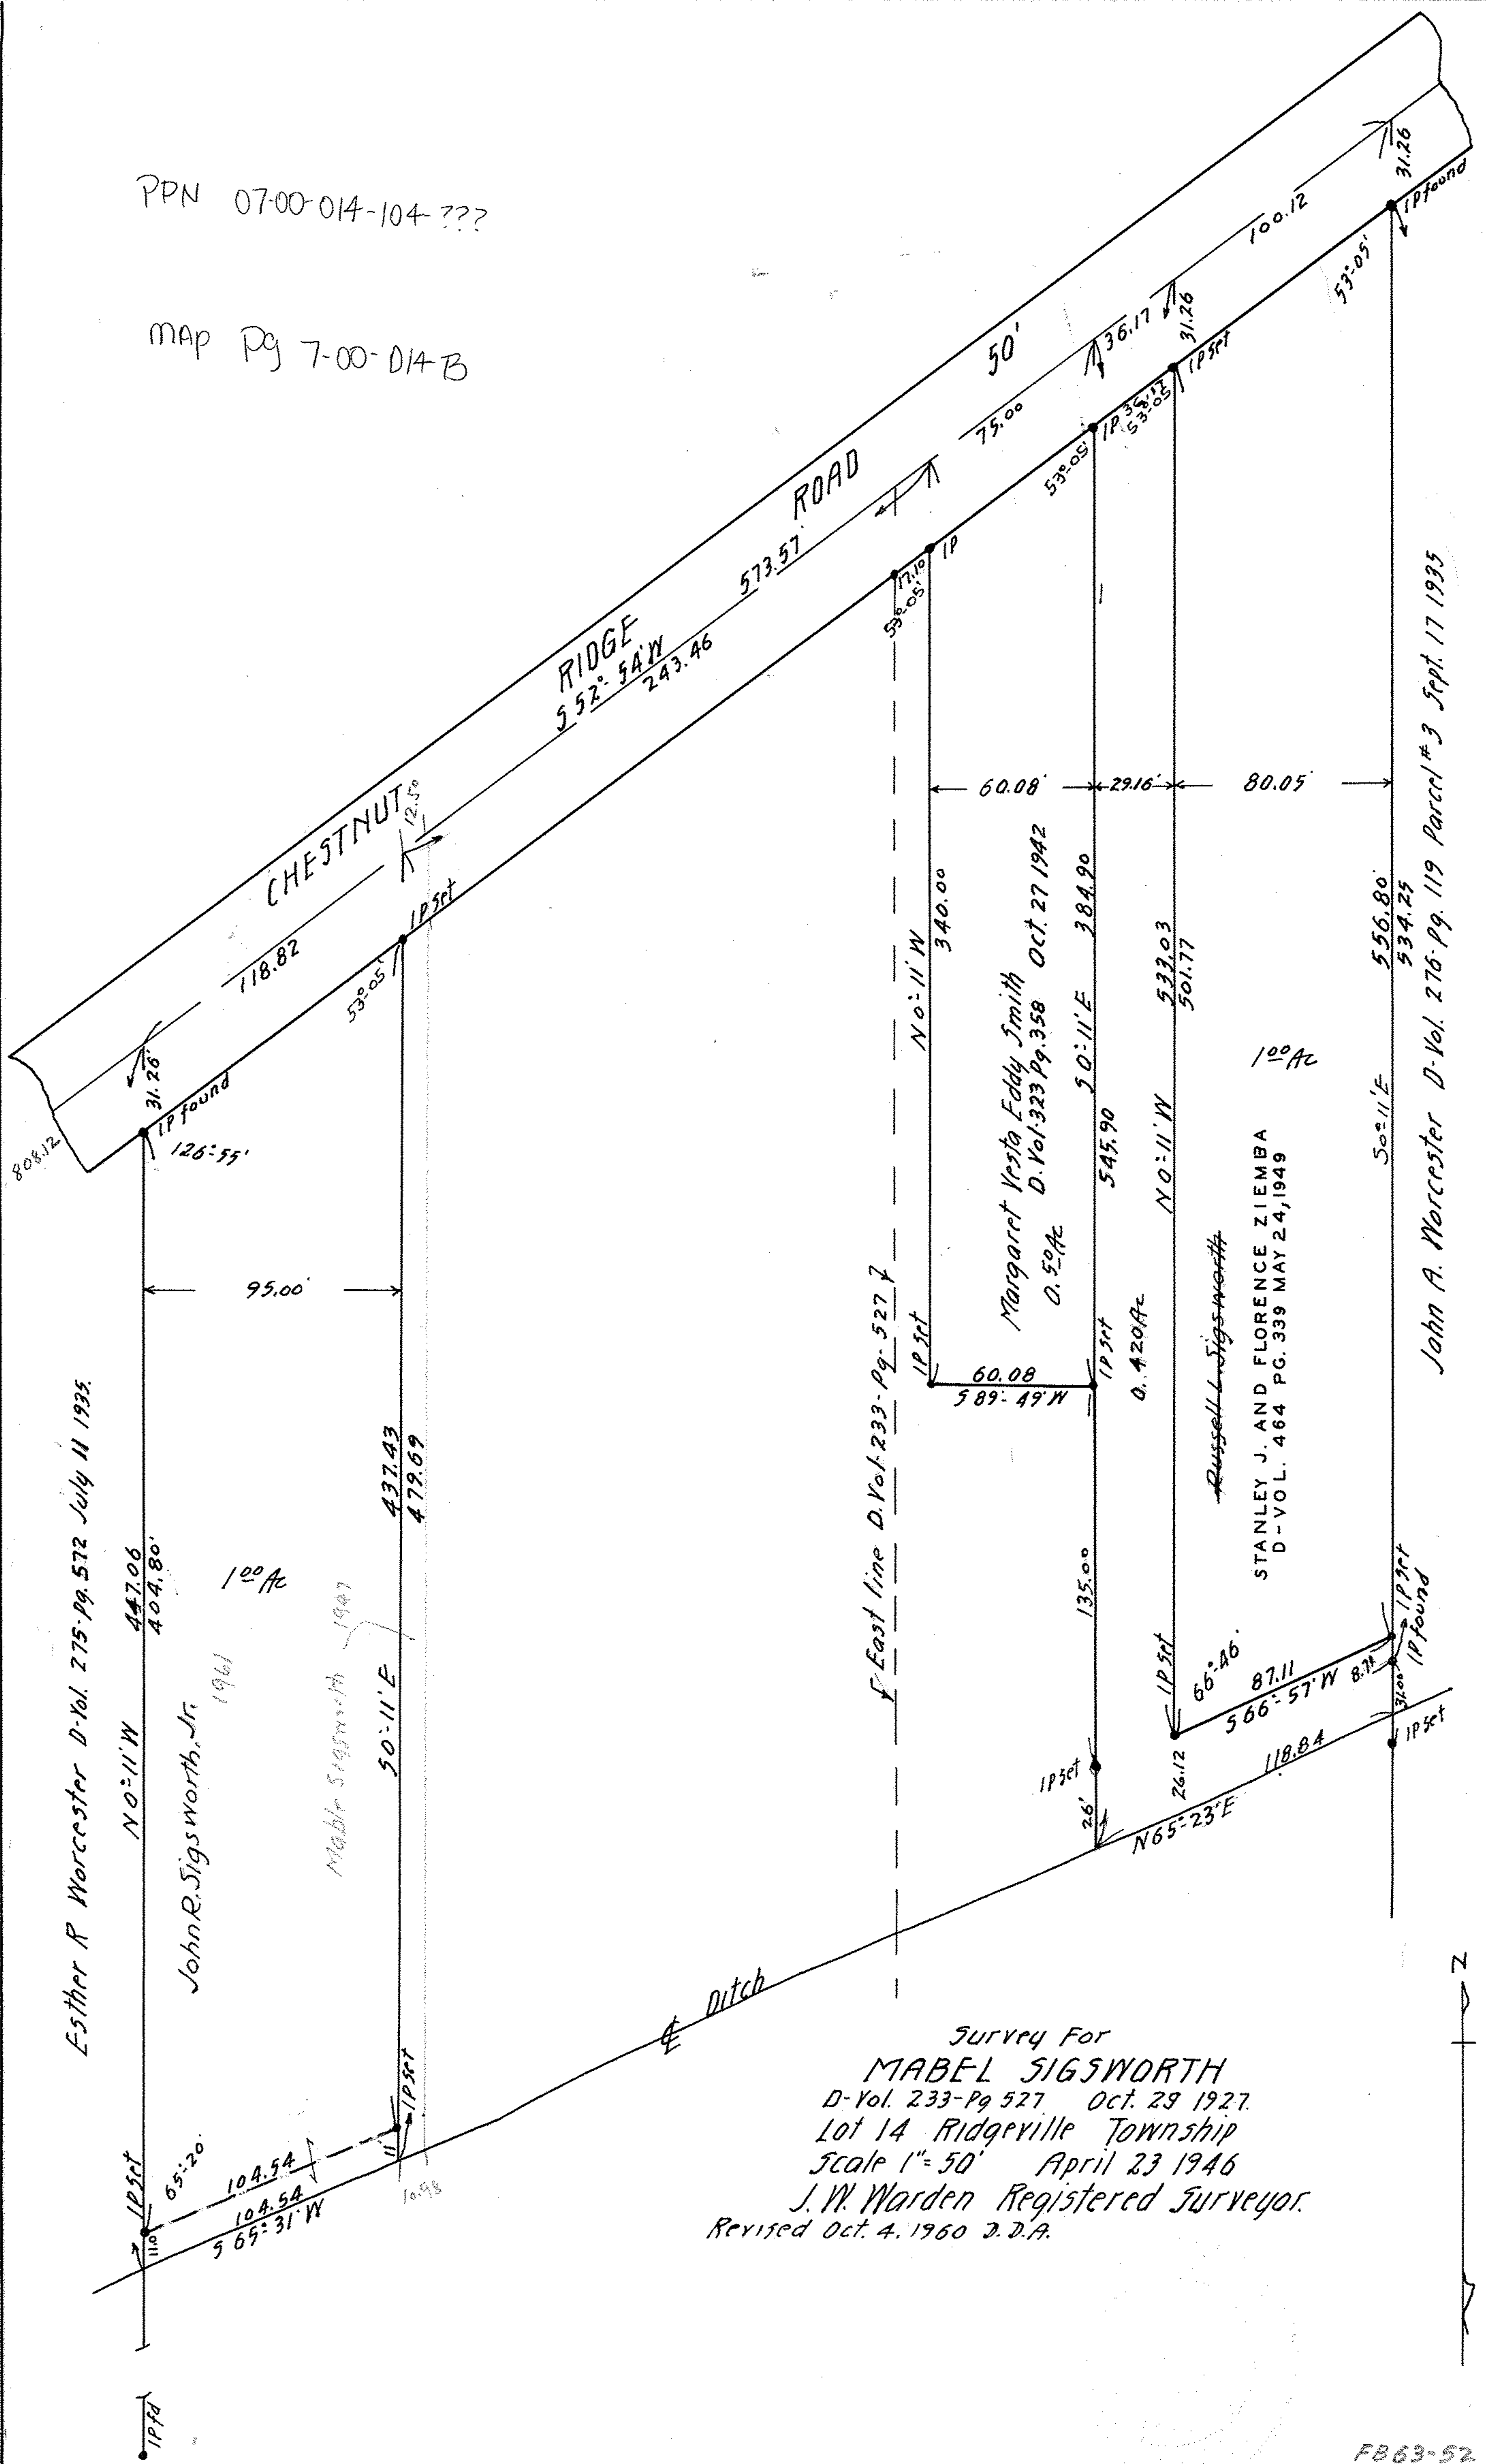

Esther R Worcester D-Vol. 275-Pg. 572 July 11 1935.

John R. Sigsworth, Jr. 1961

Mable Sigsworth 1947

East line D-Vol. 233-Pg. 527

Margaret Yesta Eddy Smith Oct. 27 1942
D-Vol. 323-Pg. 358
0.50 Ac

Russell Sigsworth

STANLEY J. AND FLORENCE ZIEMBA
D-VOL. 464 PG. 339 MAY 24, 1949

John A. Worcester D-Vol. 276-Pg. 119 Parcel # 3 Sept. 17 1935

Survey for
MABEL SIGSWORTH
 D-Vol. 233-Pg 527 Oct. 29 1927.
 Lot 14 Ridgeville Township
 Scale 1" = 50' April 23 1946
 J. W. Warden Registered Surveyor.
