Map Vol 3 P 943

11-0169

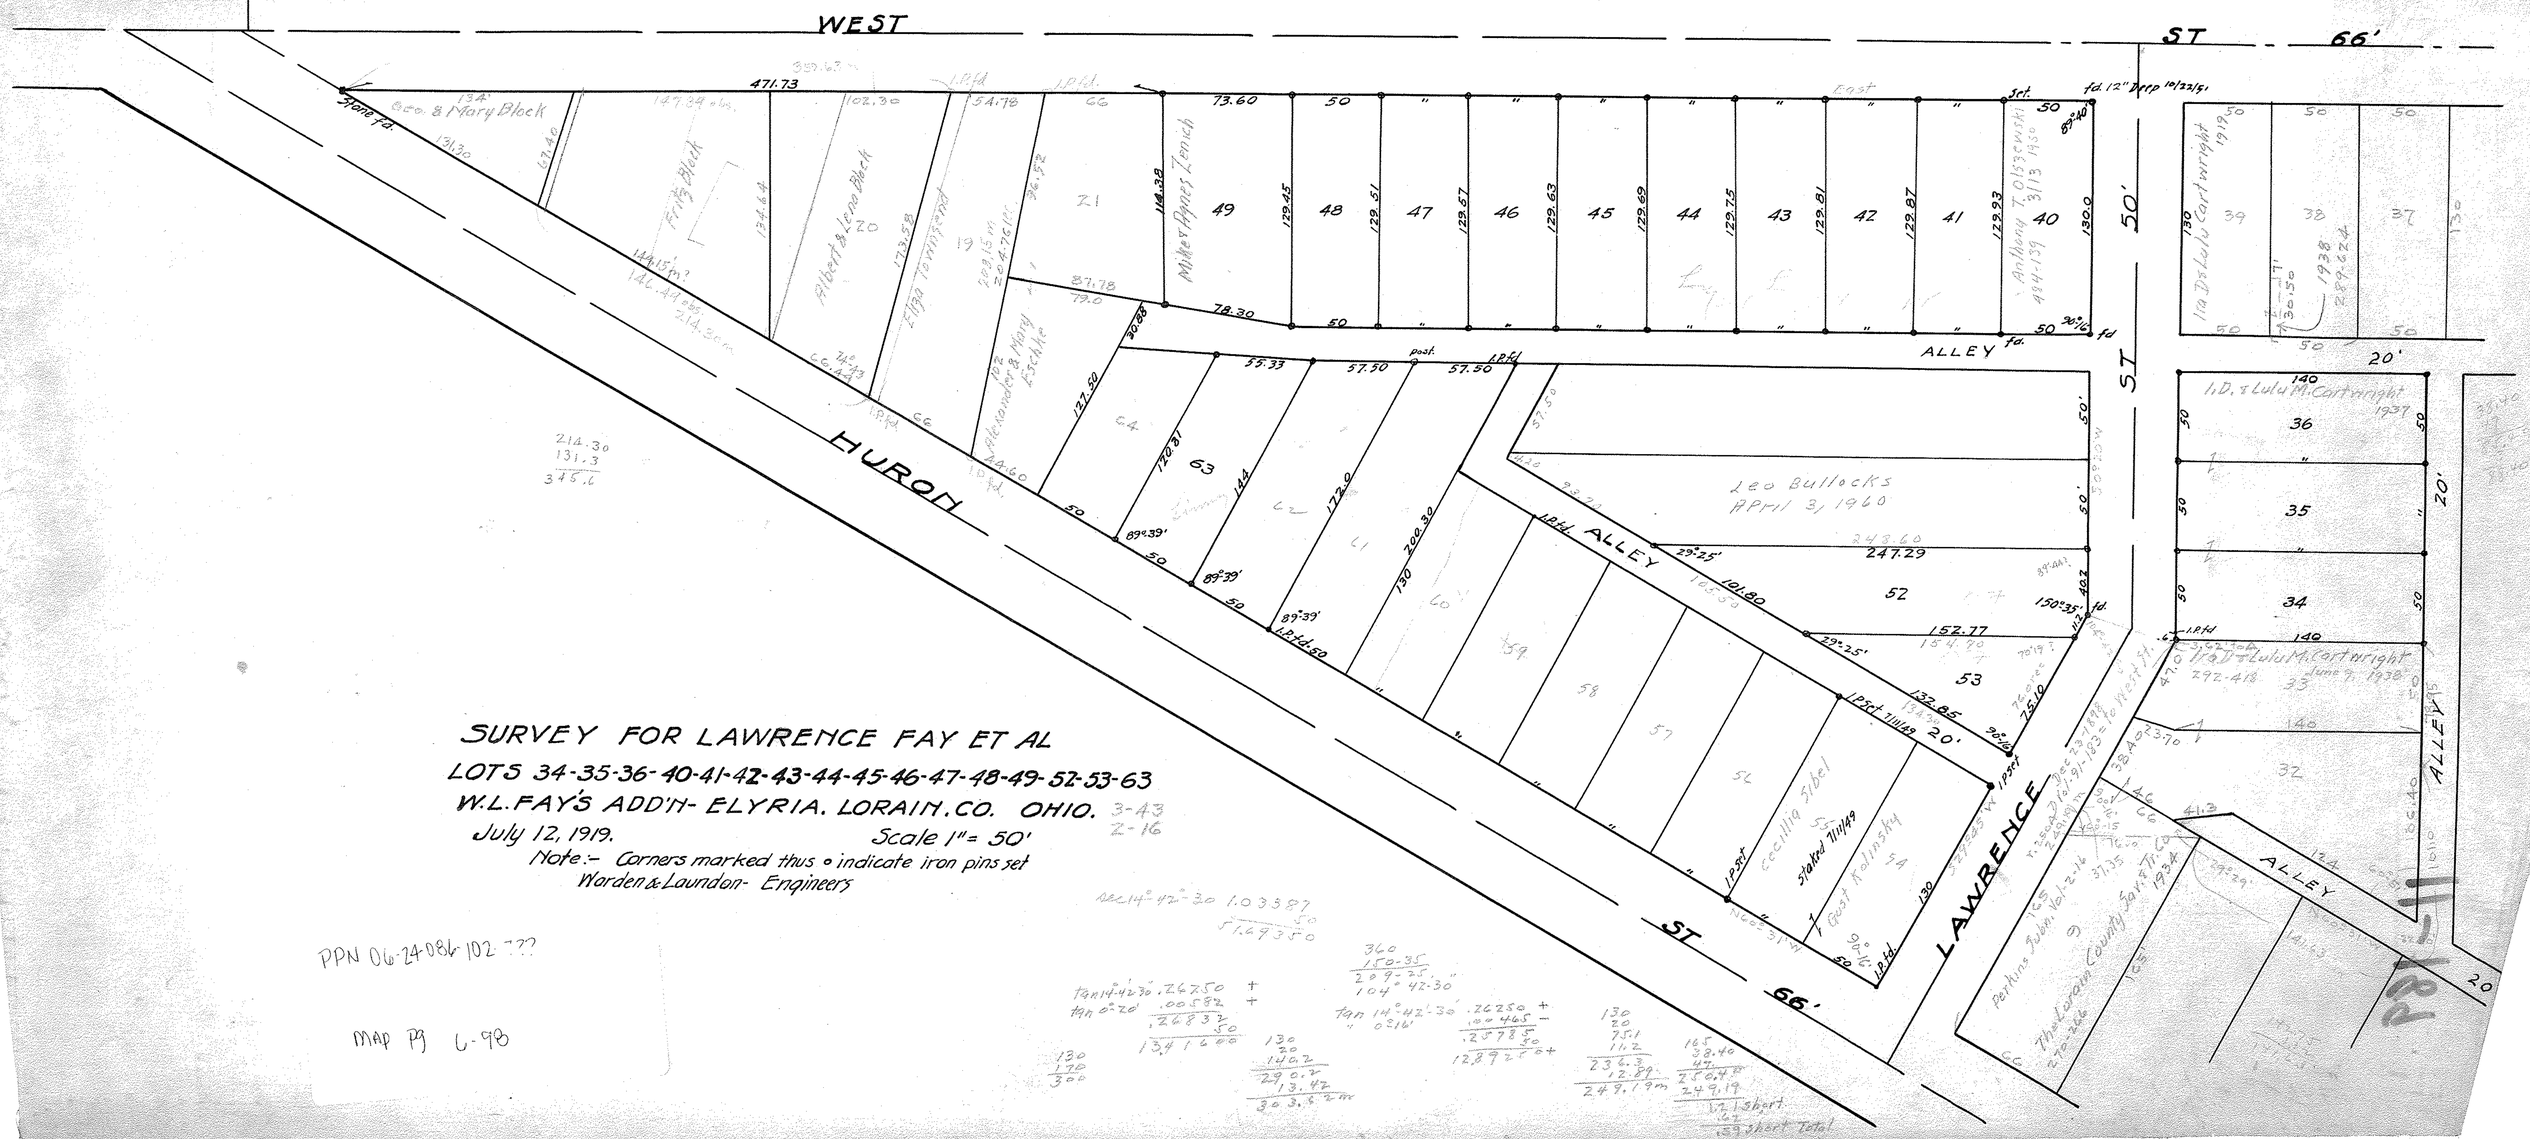

SURVEY FOR LAWRENCE FAY ET AL

LOTS 34-35-36-40-41-42-43-44-45-46-47-48-49-52-53-63

W.L. FAY'S ADD'N- ELYRIA. LORAIN.CO. OHIO.

July 12, 1919. Scale 1" = 50'

Note:- Corners marked thus ∘ indicate iron pins set

Warden & Laundon- Engineers