

11-11

Homer St


145.0'

11-0071

Iron Pin

PPN 06-25014-101-???

MAP Pg 6-104

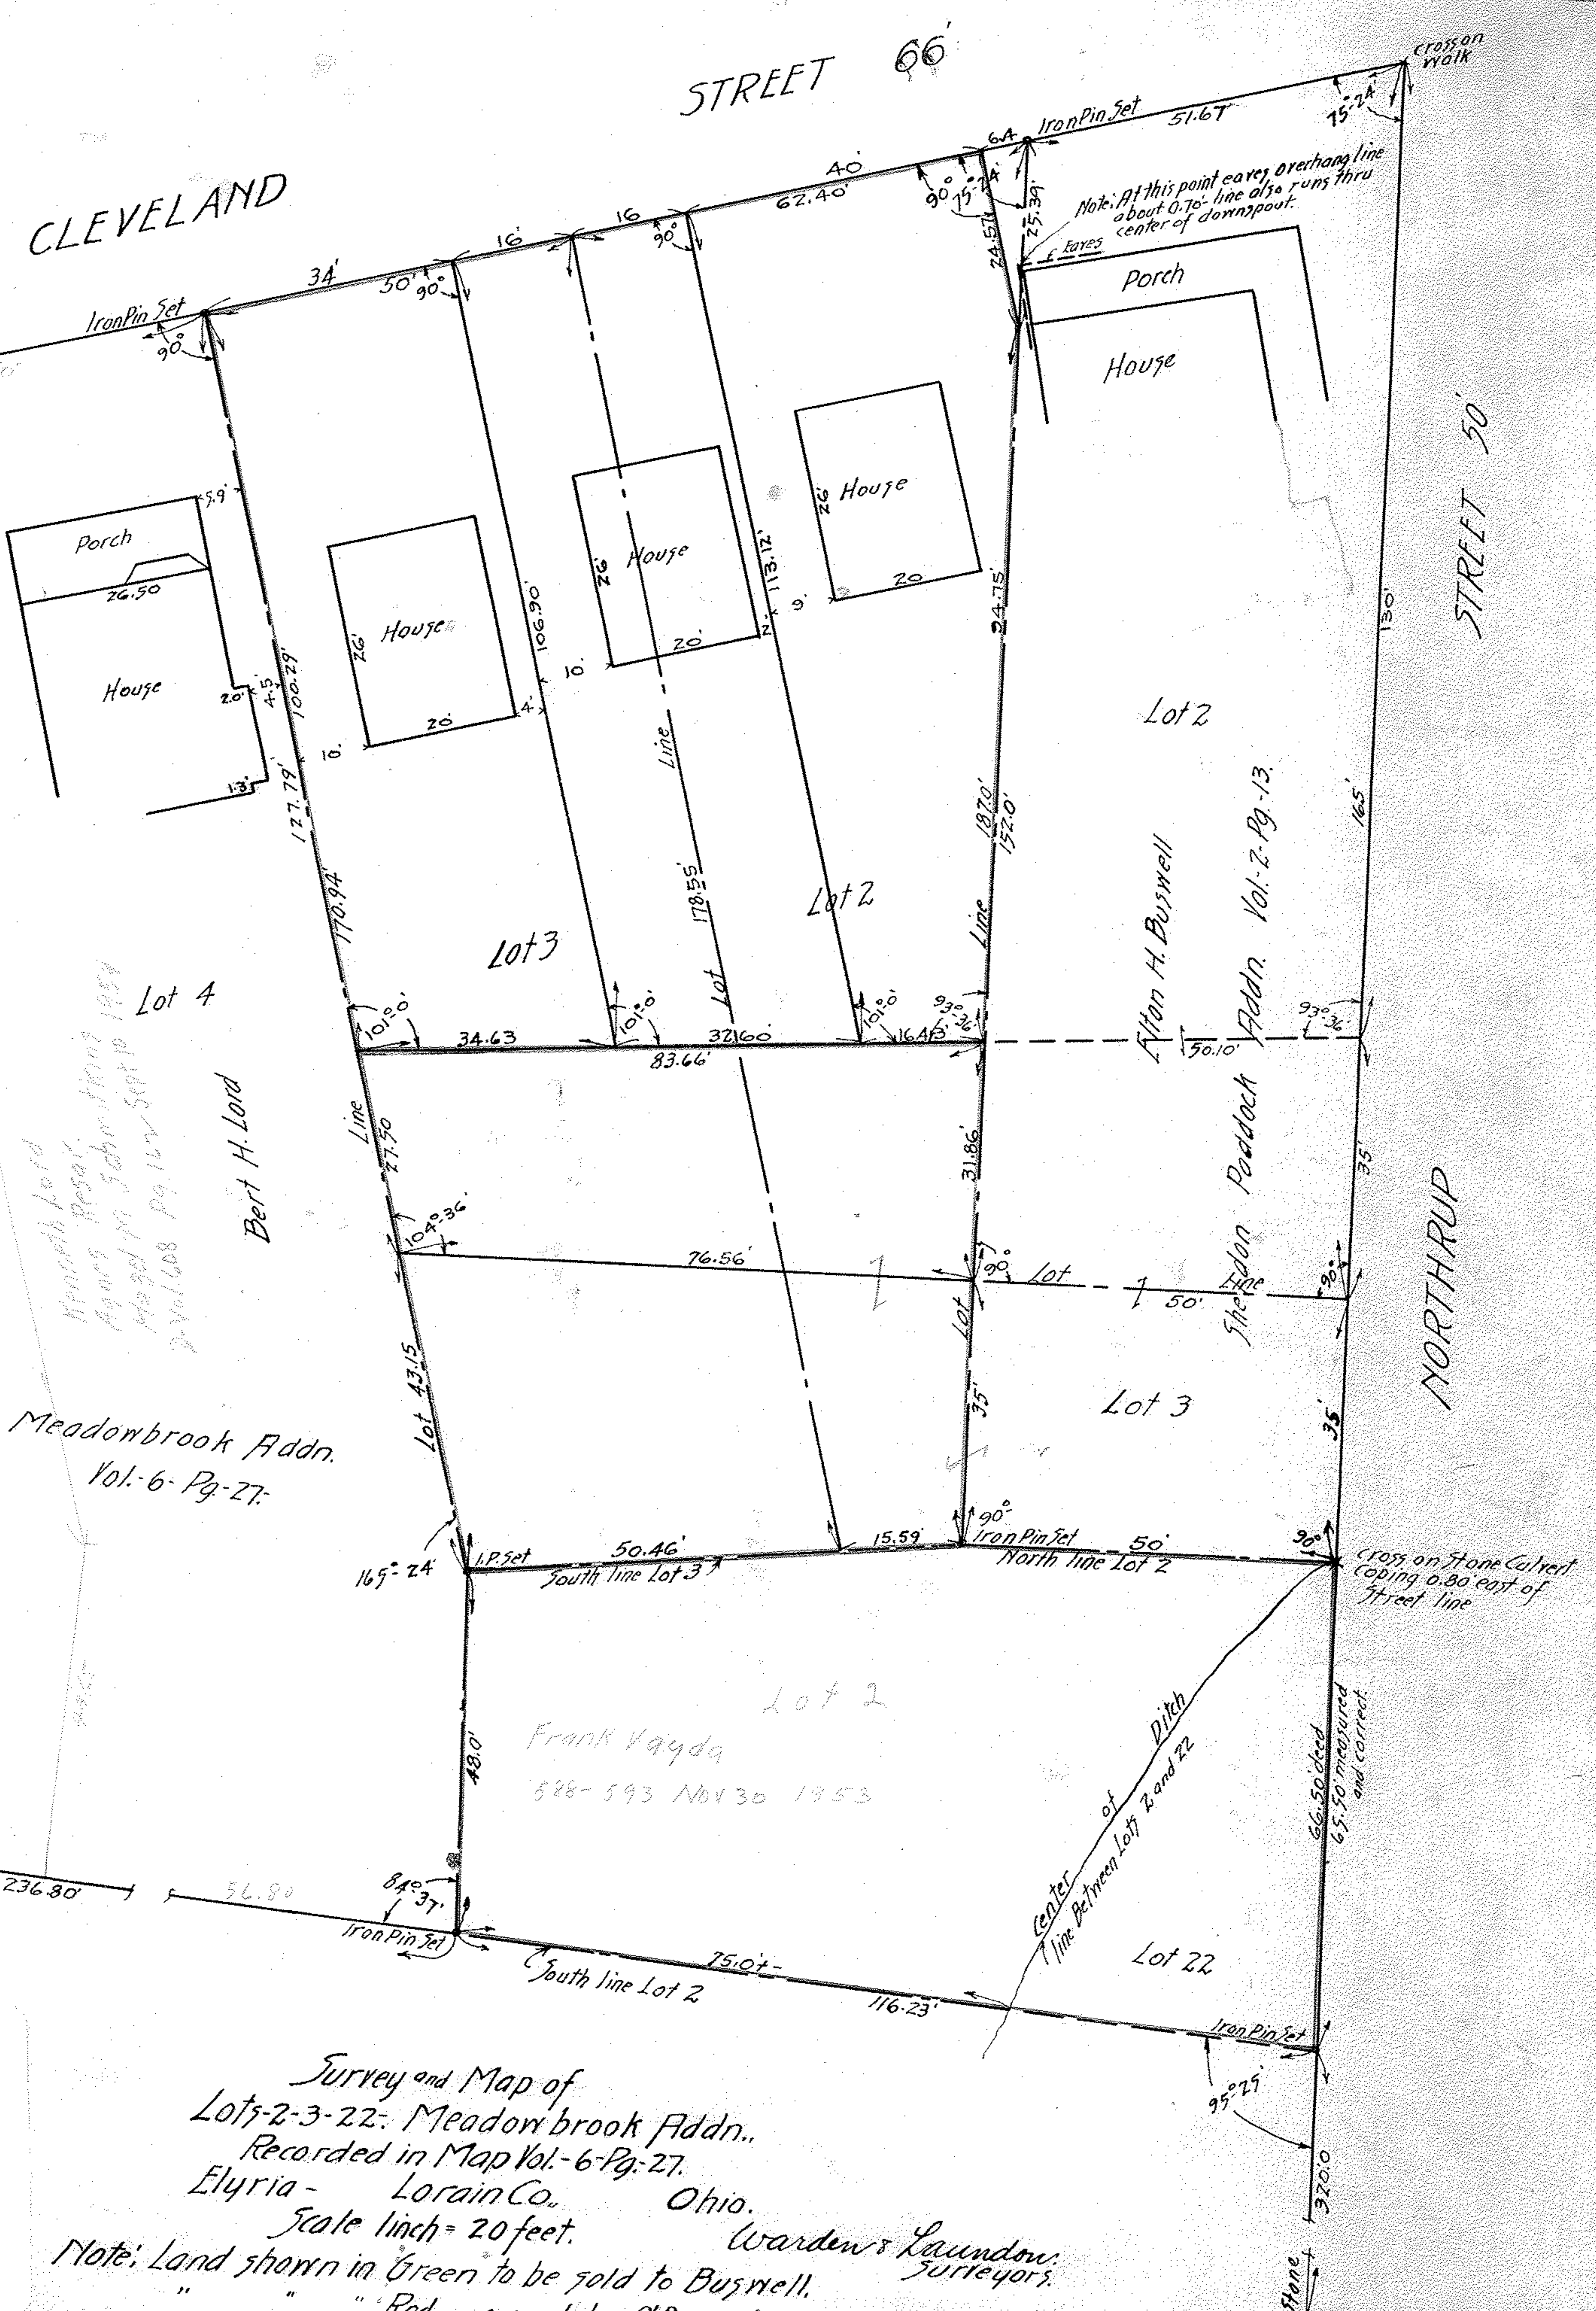

Survey and Map of
 Lots-2-3-22: Meadowbrook Addn.,
 Recorded in Map Vol. 6-Pg. 27.
 Elyria - Lorain Co. Ohio.
 Scale 1 inch = 20 feet. Warden's Laudon
 Surveyors.
 Note: Land shown in Green to be sold to Buswell.
 " " " Red owned by O'Donnell after selling to Buswell.