13-53

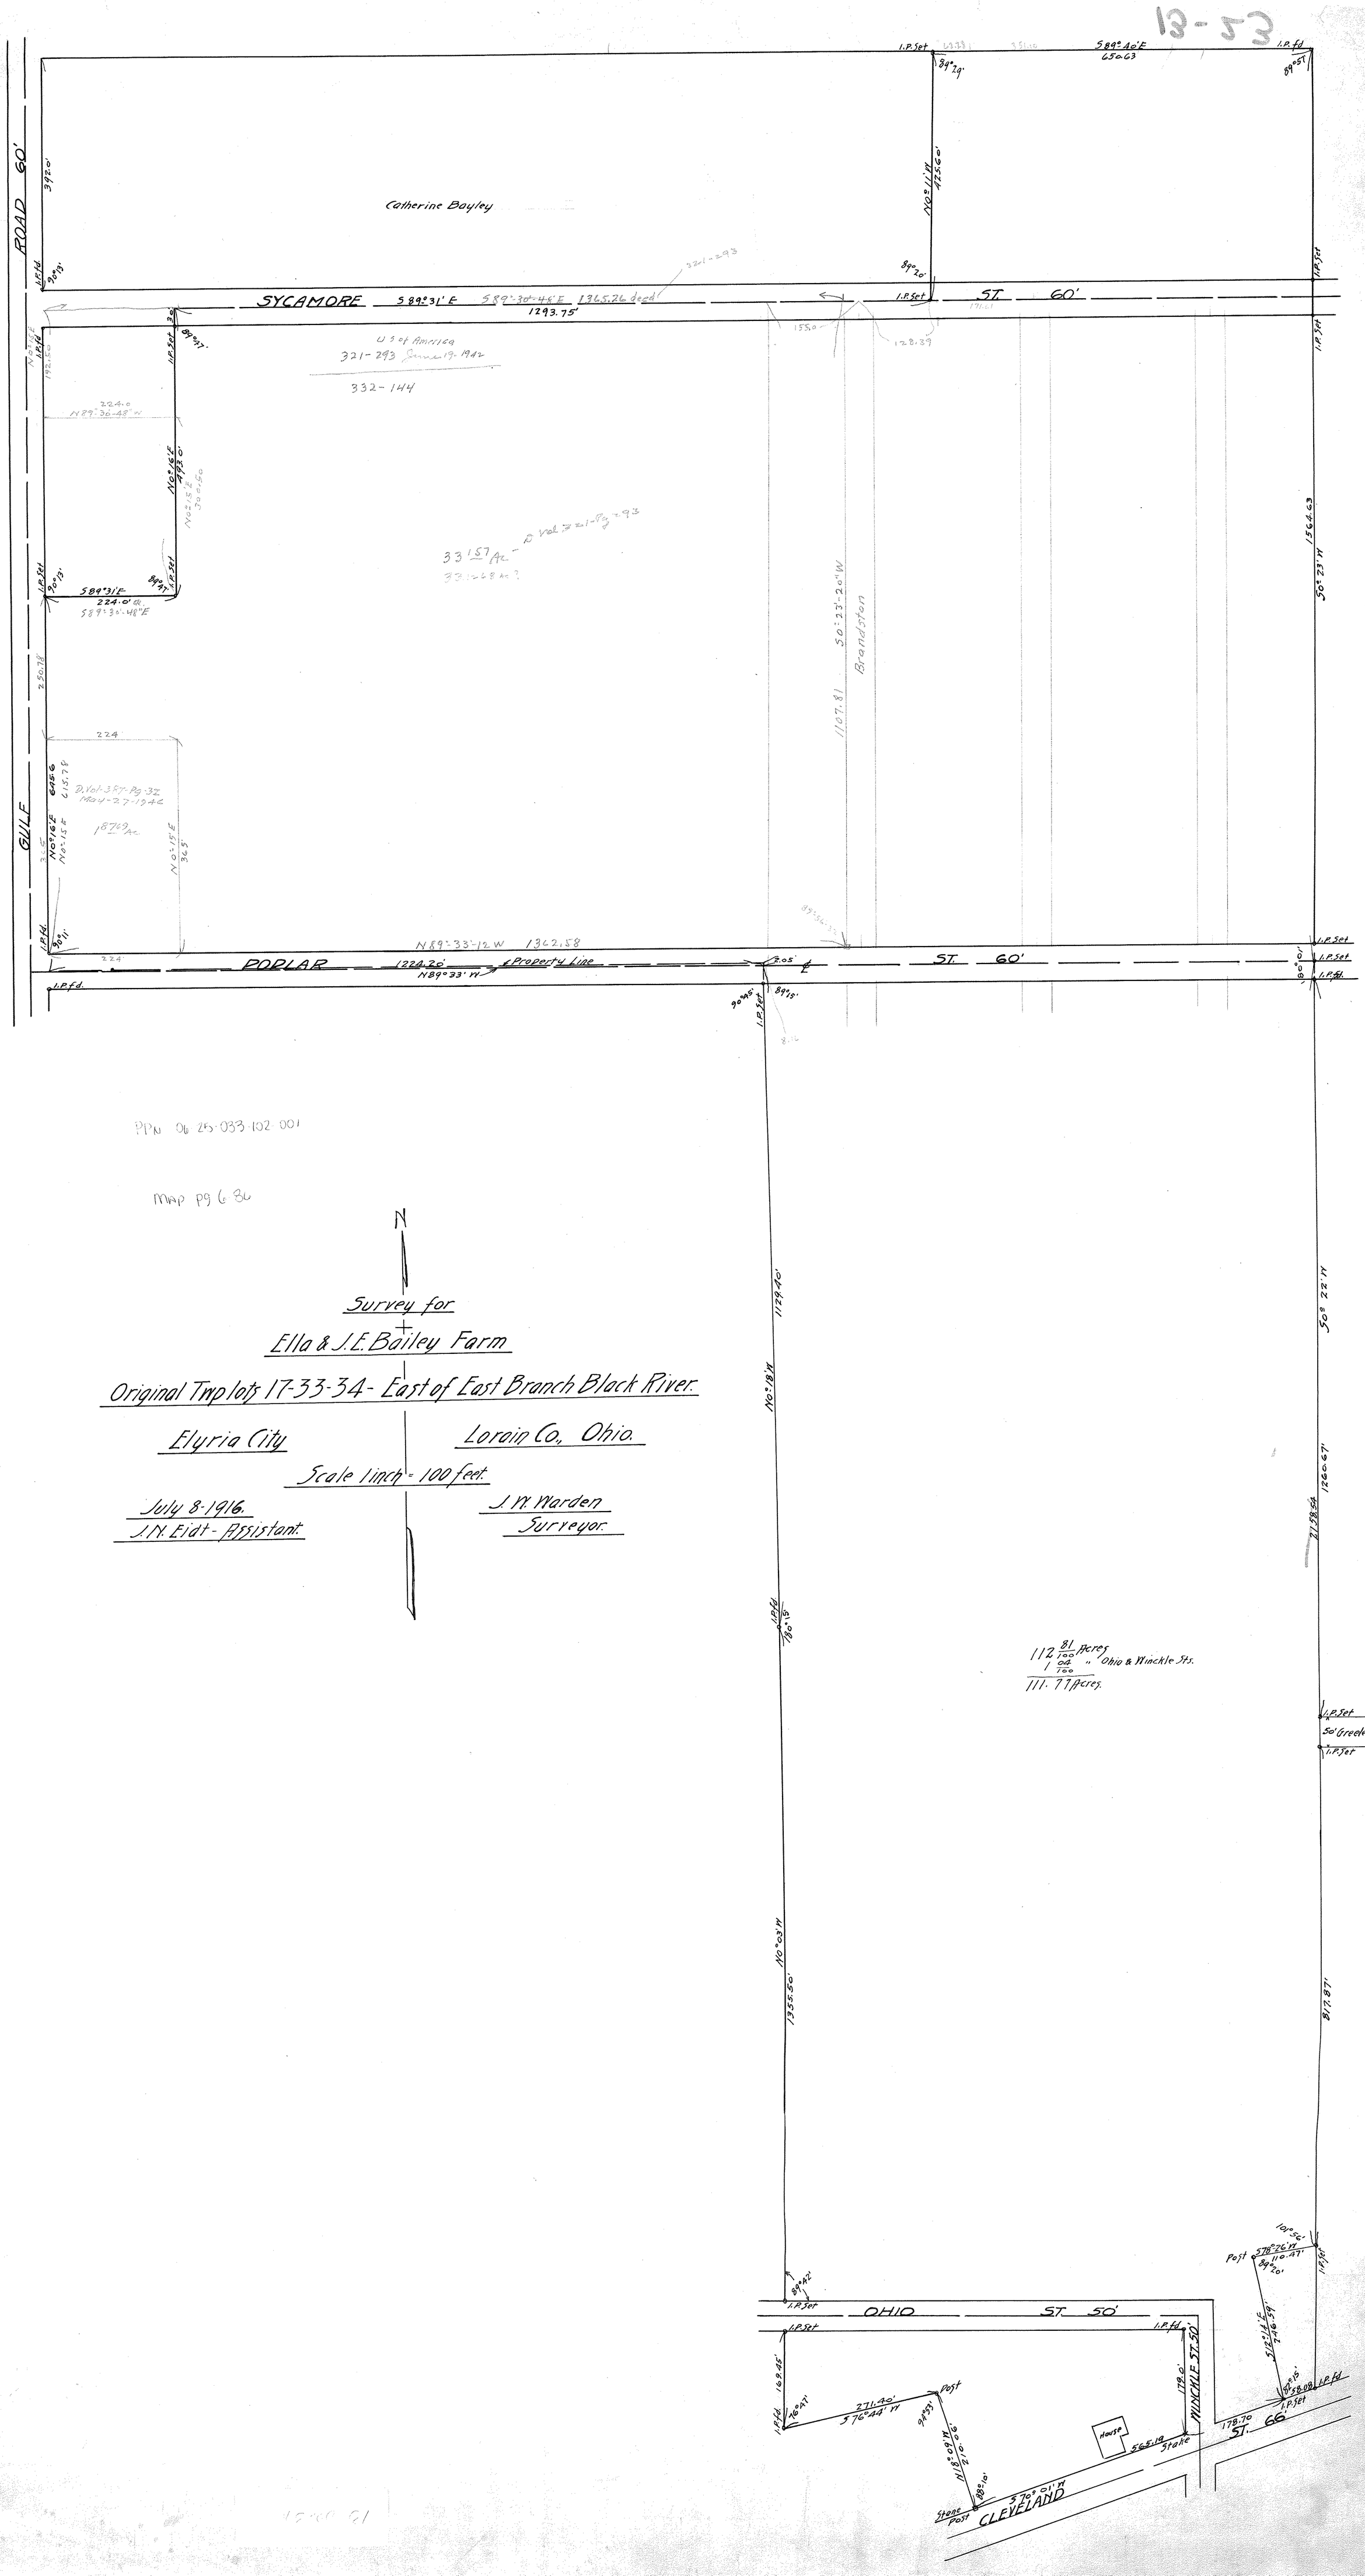

PPN 06-25-033-102-001

Map pg 6-36

N

Survey for

Ella & J.E. Bailey Farm

Original Twp lots 17-33-34- East of East Branch Black River.

Elyria City — Lorain Co., Ohio.

Scale 1 inch = 100 feet.

July 8-1916.
J.N. Eidt - Assistant.

J.N. Warden
Surveyor.