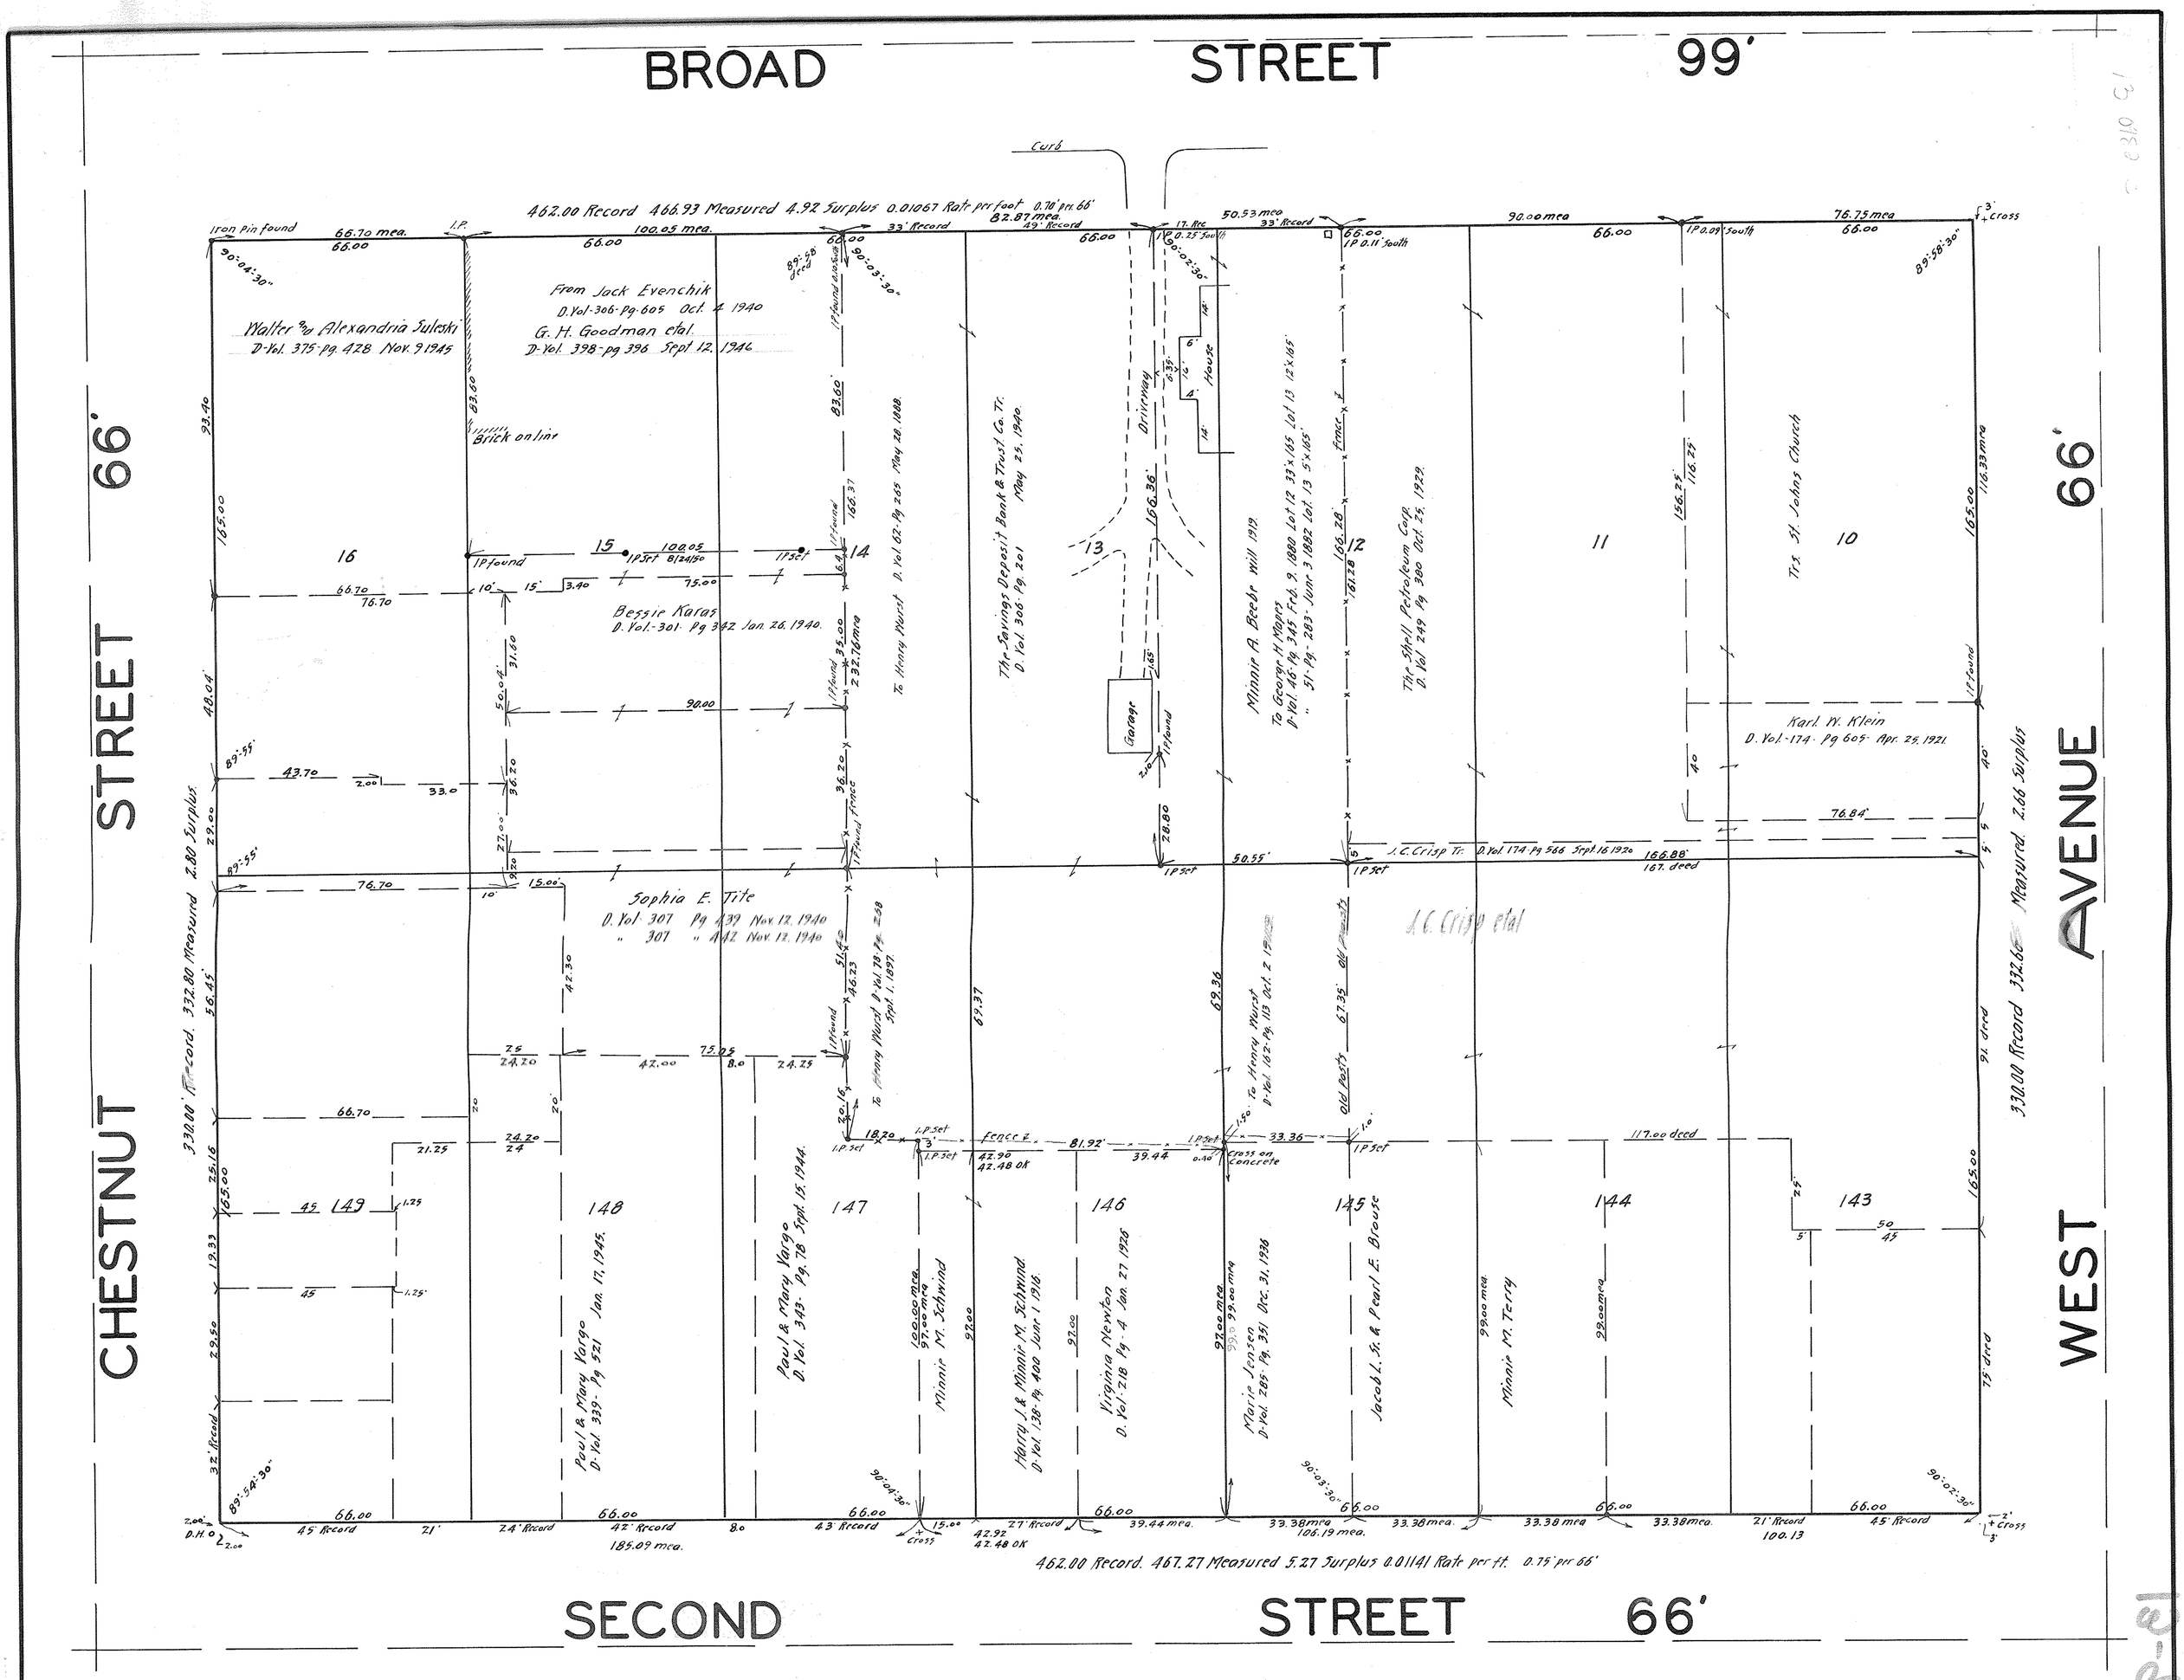

Field Book 10-Pg 1 - 17-Pg. 43
Loose leaf E. P. Sonnels
Benson Small Map File
St. Johns Church "
Peerless Oil Co. "
Van Haesen 4-404

Survey for G. H. Goodman Aug. 24. 1950

PPN 06-26-065-000-???

map pg 6-119

Survey For
THE SAVINGS DEPOSIT BANK & TRUST CO., TR.
Lots 13-14-145-146-147 Block 65
Original Village Plat of Elyria Map. Vol. 3-Pg.-14
Elyria City, Lorain County Ohio.
Scale 1" = 20' Dec. 2, 1946.
J. W. Warden, Registered Surveyor.