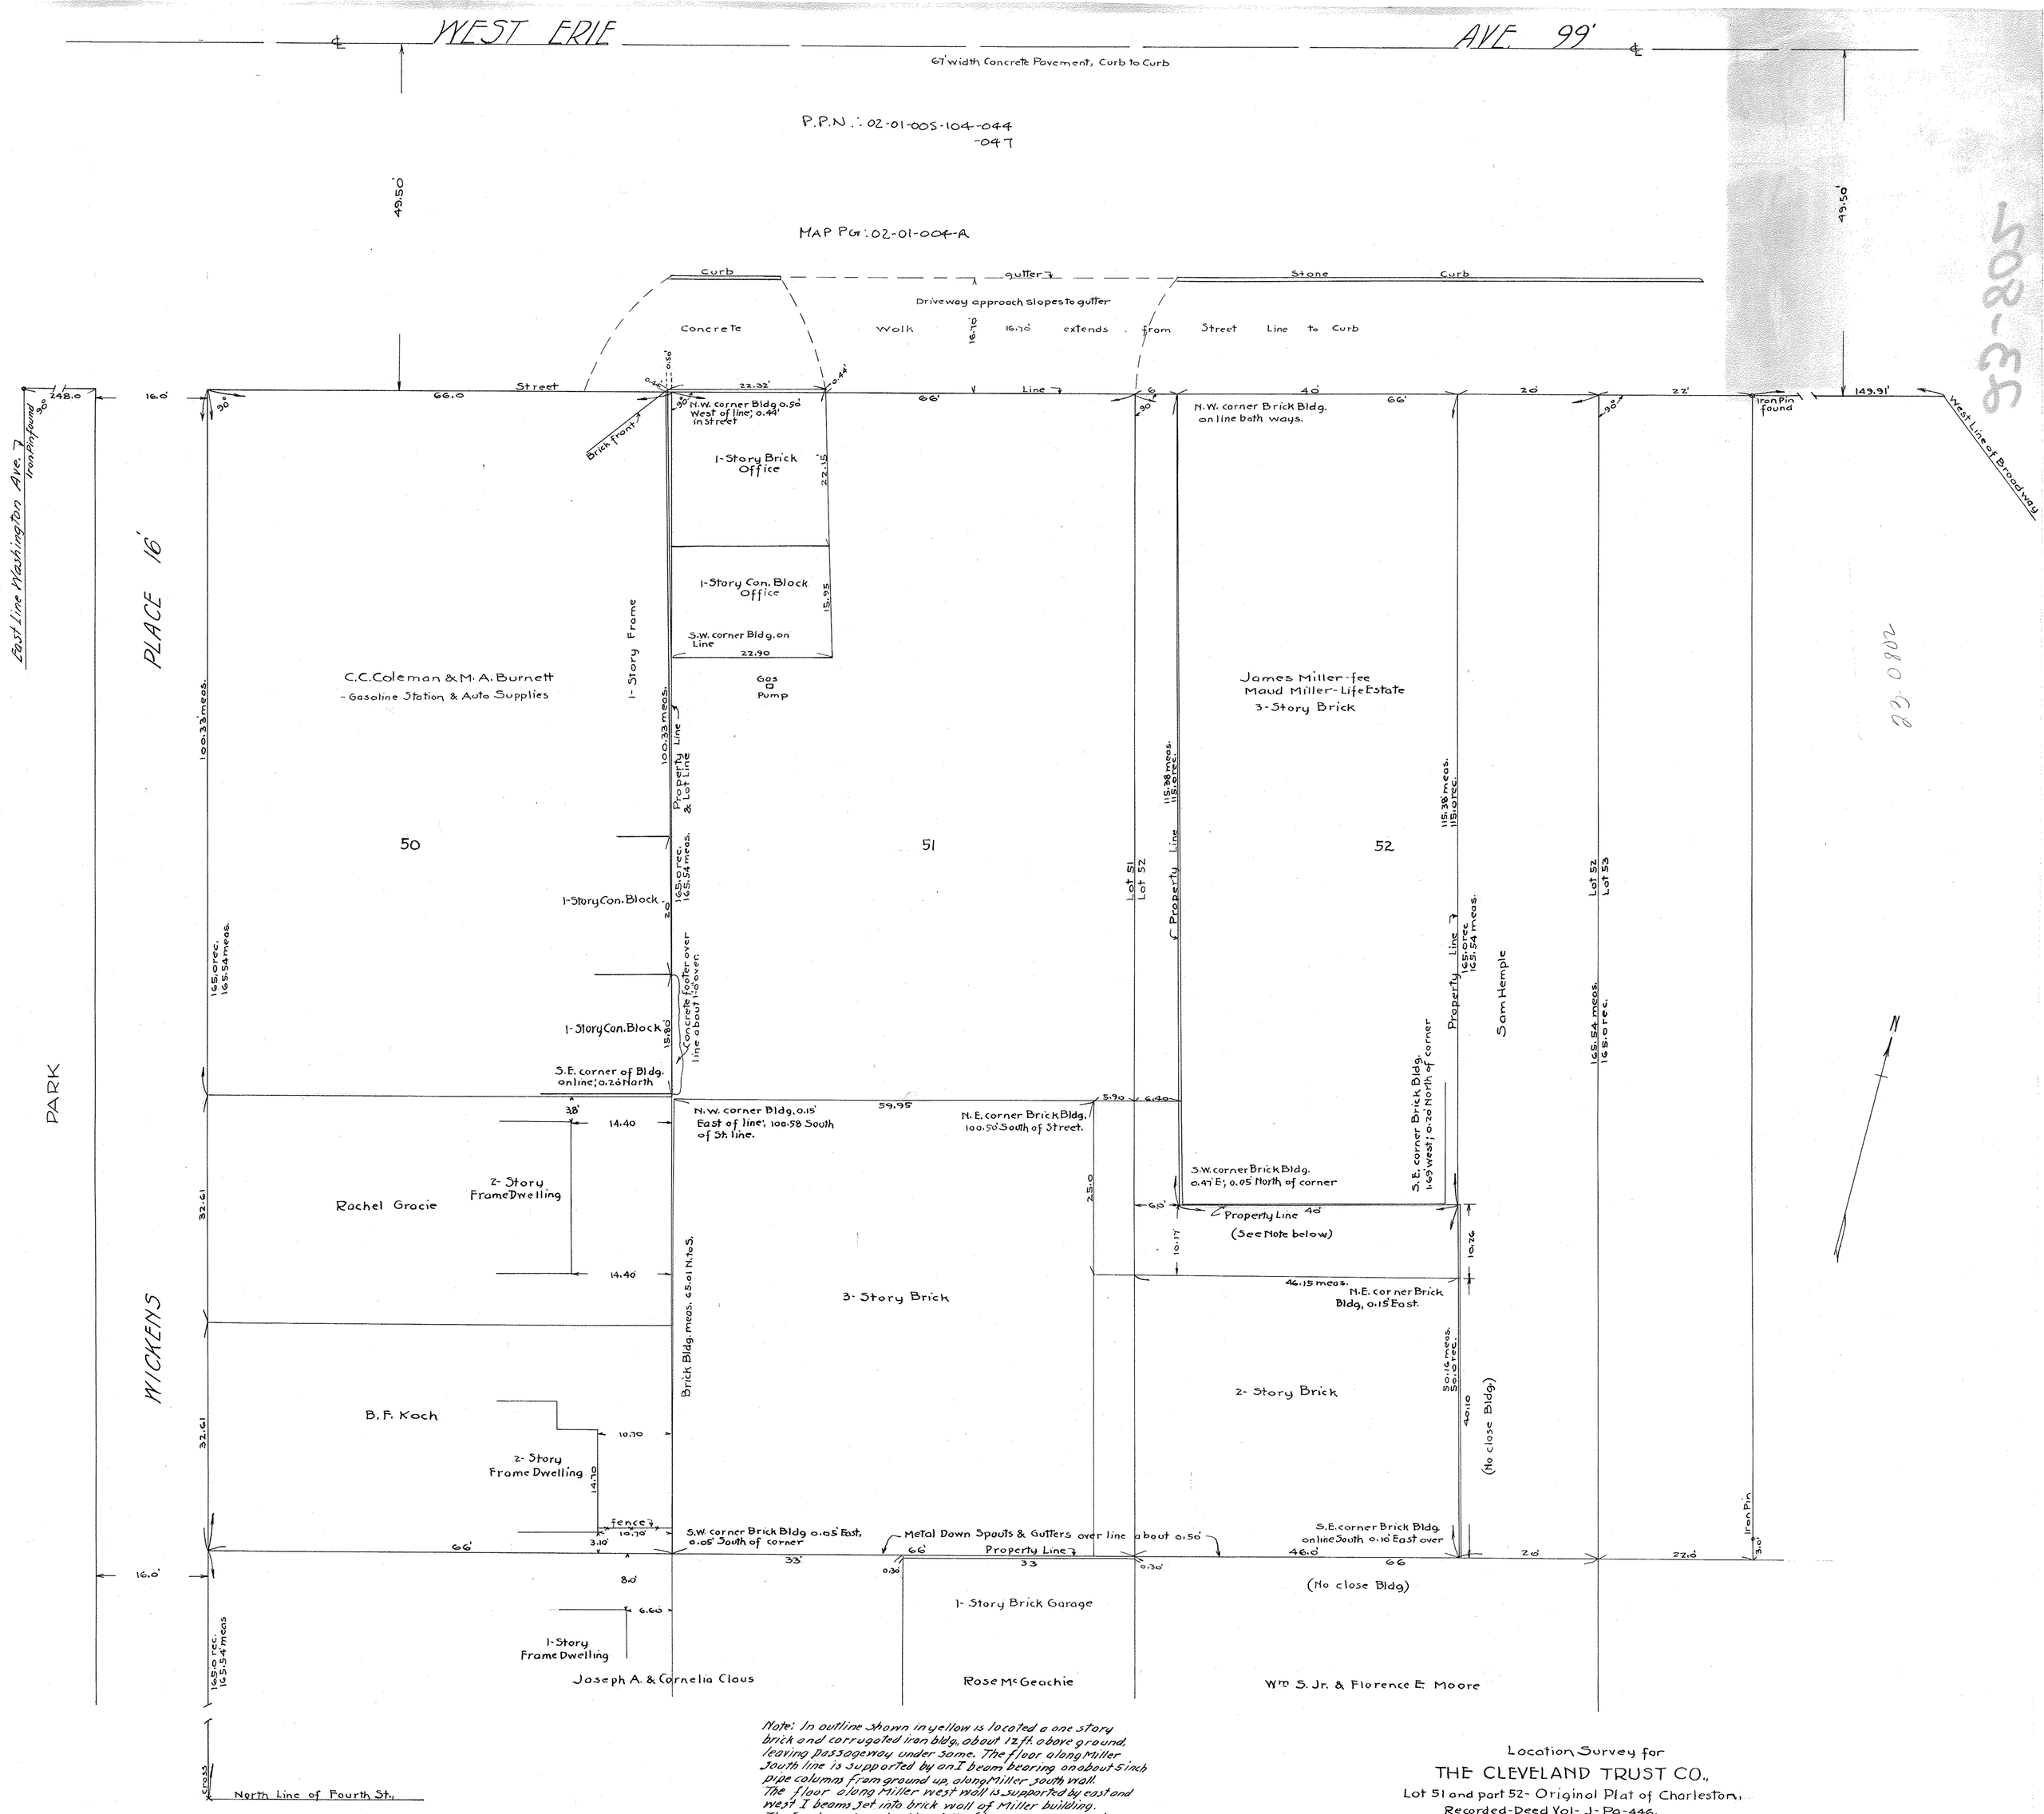

Note: In outline shown in yellow is located a one story brick and corrugated iron bldg., about 12 ft. above ground, leaving passageway under same. The floor along Miller South line is supported by an I beam bearing on about 5 inch pipe columns from ground up, along Miller south wall. The floor along Miller west wall is supported by east and west I beams set into brick wall of Miller building. The South and west side of the floor is supported by I beams laid into the brick walls of the three and two story buildings shown on map.

Location Survey for

THE CLEVELAND TRUST CO.,

Lot 51 and part 52- Original Plat of Charleston,
Recorded-Deed Vol- J- Pg-446.
Lot-5- Tract-1-. Black River Twp.,
Lorain Co., Lorain City, Ohio.
March-6-1940. Scale 1"= 10'.
J. W. Warden, Registered Surveyor.

22-0802