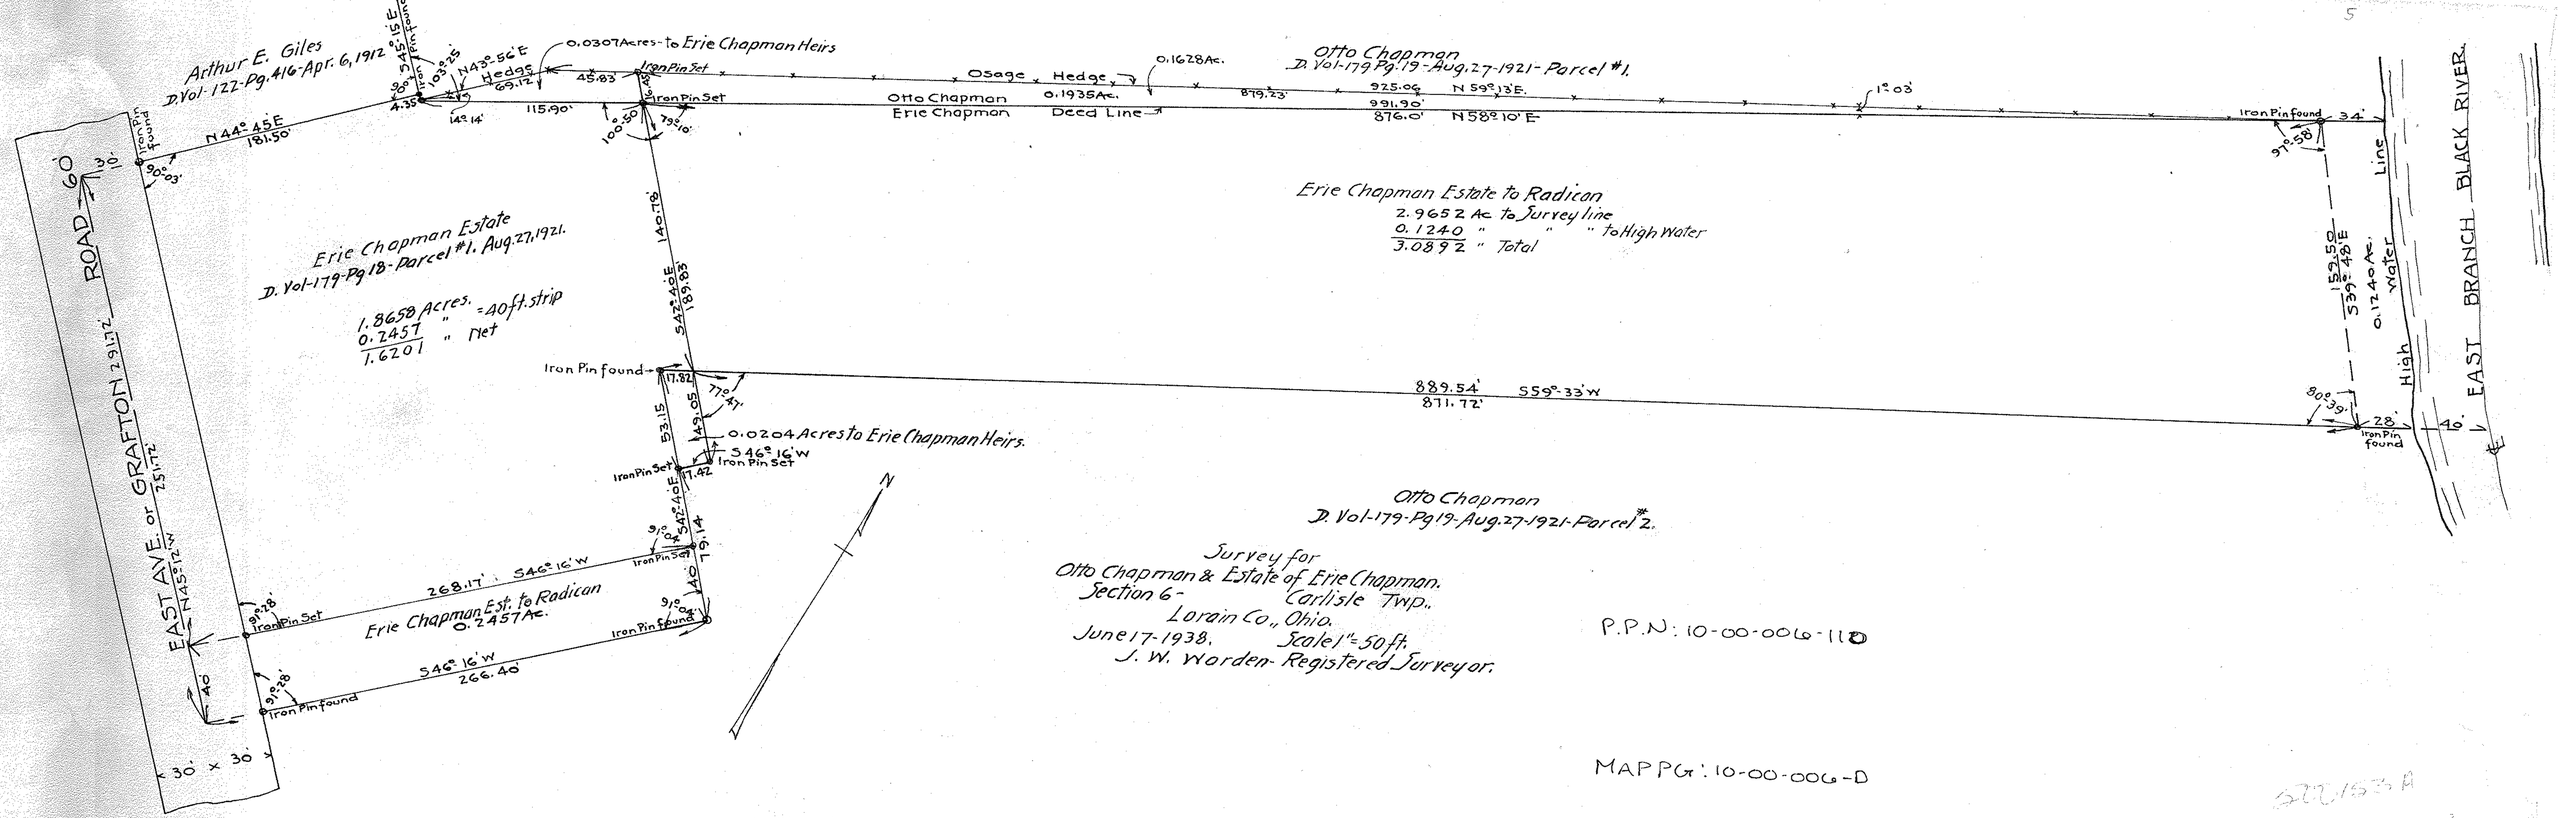
Arthur E. Giles
D. Vol-122-Pg.416-Apr. 6, 1912
0.0307 Acres - to Erie Chapman Heirs
Iron Pin Set
Osage Hedge
0.1628 Ac.
Otto Chapman
D. Vol-179 Pg.19-Aug. 27-1921-Parcel #1.
Otto Chapman
Erie Chapman
0.1935 Ac.
Deed Line
N 59° 13' E.
N 58° 10' E
Iron Pin found
Erie Chapman Estate to Radican
2.9652 Ac to Survey line
0.1240 " " " to High Water
3.0892 " Total
Erie Chapman Estate
D. Vol-179-Pg 18-Parcel #1. Aug. 27, 1921.
1.8658 Acres.
0.2457 " = 40 ft. strip
1.6201 " Net
ROAD 60'
EAST AVE. or GRAFTON
N 44° 45' E
181.50'
S 42° 40' E
169.83
889.54'
871.72'
S 59° 33' W
0.0204 Acres to Erie Chapman Heirs.
S 46° 16' W
Otto Chapman
D. Vol-179-Pg 19-Aug. 27-1921-Parcel #2.
Erie Chapman Est. to Radican
0.2457 Ac.
268.17'
266.40'
Survey for
Otto Chapman & Estate of Erie Chapman.
Section 6 - Carlisle Twp.
Lorain Co., Ohio.
June 17-1938. Scale 1" = 50 ft.
J. W. Worden - Registered Surveyor.
P.P.N: 10-00-006-110
MAP PG: 10-00-006-D
High Water Line
EAST BRANCH BLACK RIVER
0.1240 Ac.
30' x 30'
N