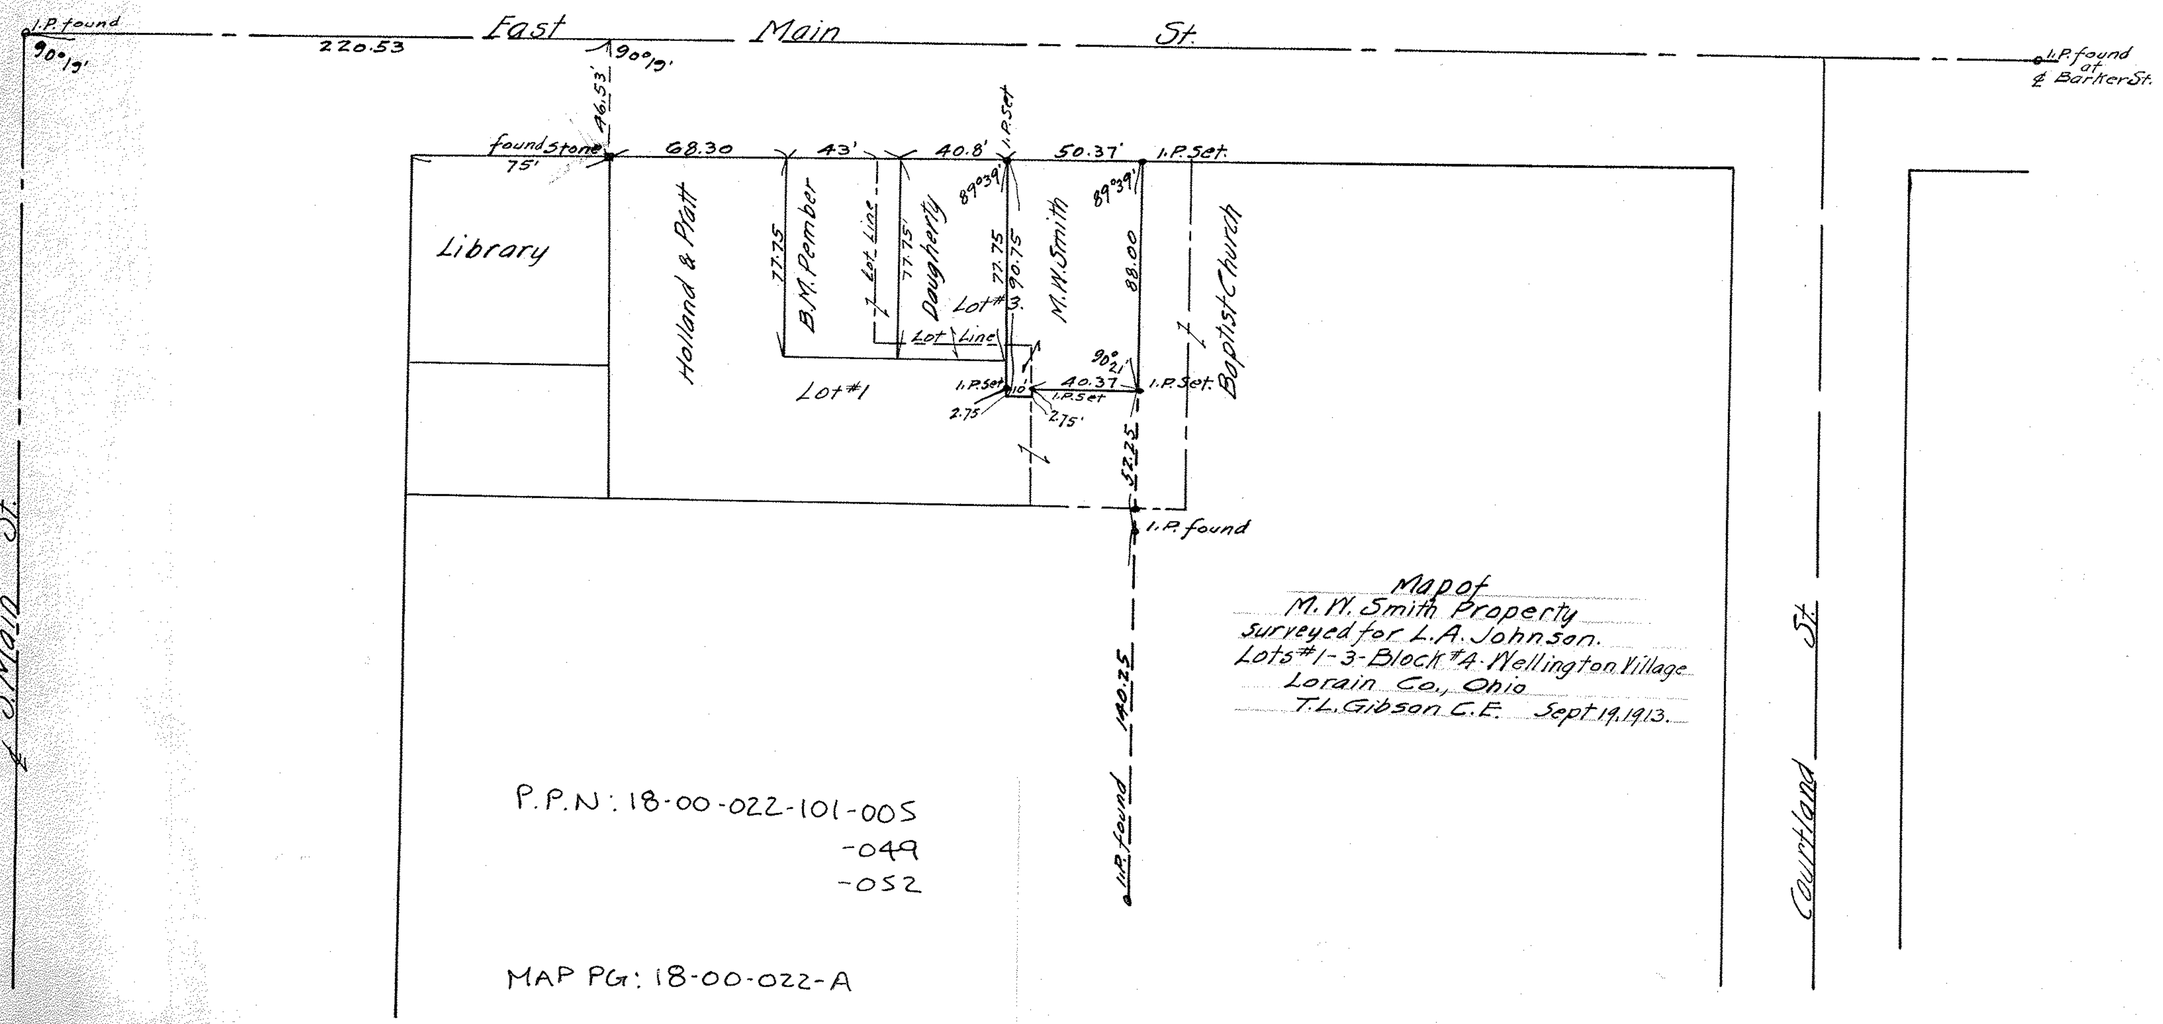

Map of
M. W. Smith Property
surveyed for L. A. Johnson.
Lots #1-3-Block #A-Wellington Village
Lorain Co., Ohio
T. L. Gibson C.E. Sept 19, 1913.

P.P.N: 18-00-022-101-005
-049
-052

MAP PG: 18-00-022-A