


P.P.N: 11-00-068-000

MAP PG: 11-00-068-B

Survey for  
- L. F. Hamlin -  
O.L. #88 Eaton Twp. Lorain Co. O.  
Apr. 17, 1914. T.L. Gibson C.E.

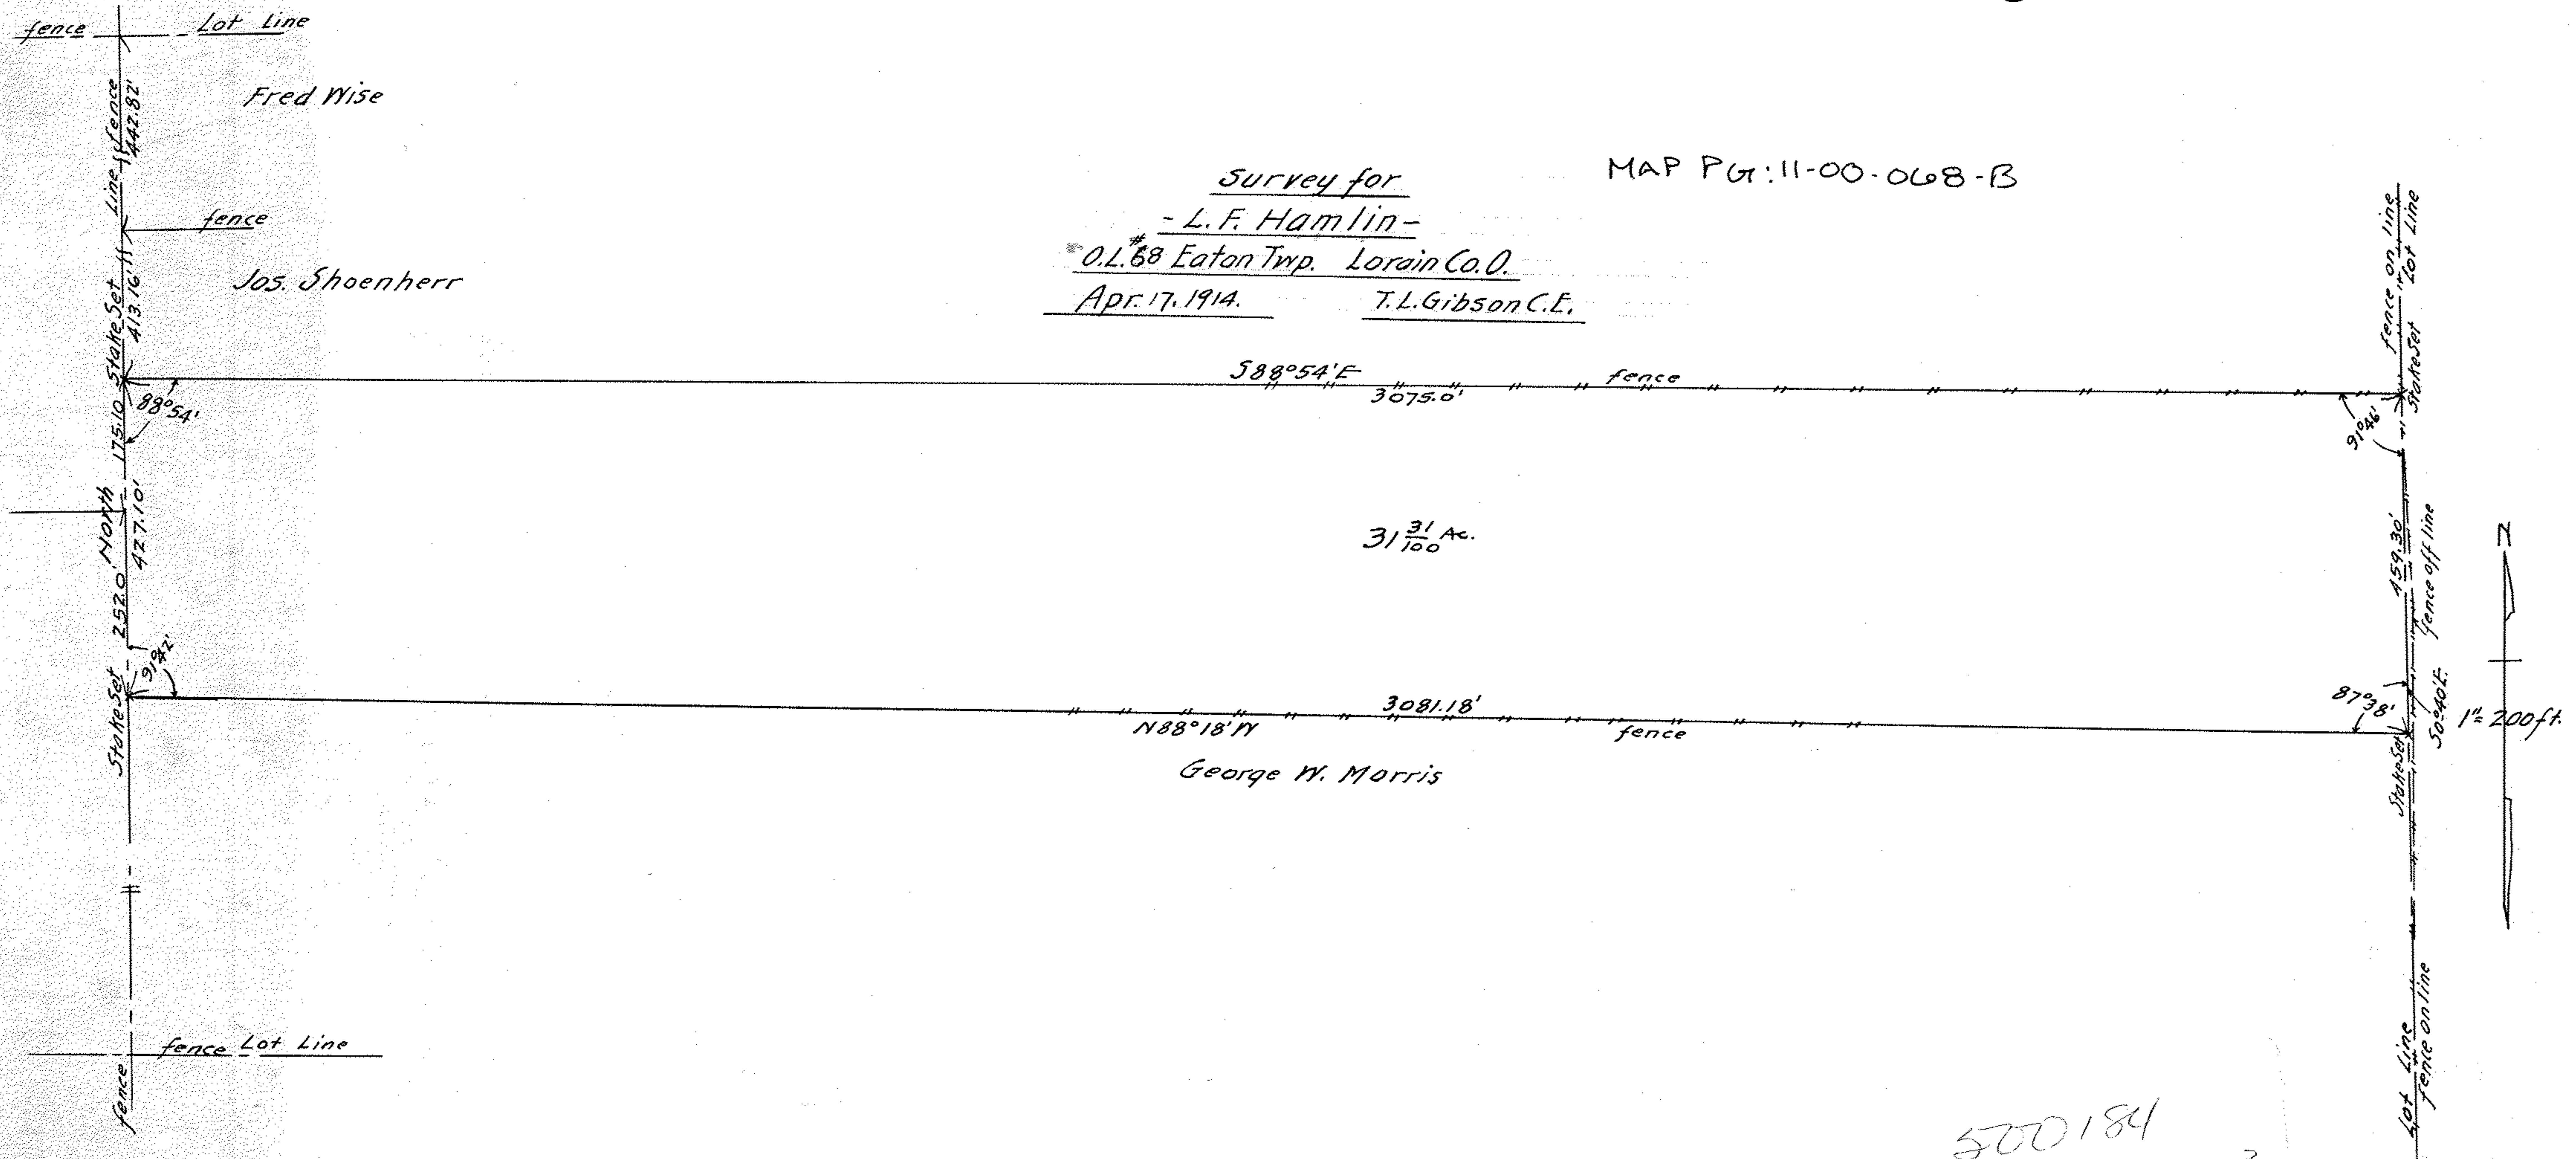

500184