200 0 200 400 600

GRAPHIC SCALE – FEET

DIMENSIONS SHOWN ON THIS PLAT ARE EXPRESSED IN FEET AND DECIMAL PARTS THEREOF, ALL BEARINGS ARE TO AN ASSUMED MERIDIAN AND ARE USED TO INDICATE ANGLES ONLY. PERMANENT MONUMENTS WERE FOUND OR SET AT ALL POINTS INDICATED HEREON, ALL OF WHICH I CERTIFY TO BE CORRECT.

STATE OF OHIO THOMAS A. SIMON S-7775 REGISTERED SURVEYOR

THOMAS A. SIMON
REG. PROFESSIONAL SURVEYOR
NO. S-7775

BASIS OF BEARINGS IS THE CENTERLINE OF GORE ORPHANAGE ROAD (NORTH 00°34'04" EAST). IRON PINS SET ARE 5/8" DIAMETER, 30" LONG WITH PLASTIC CAPS "T. SIMON, S-7775".

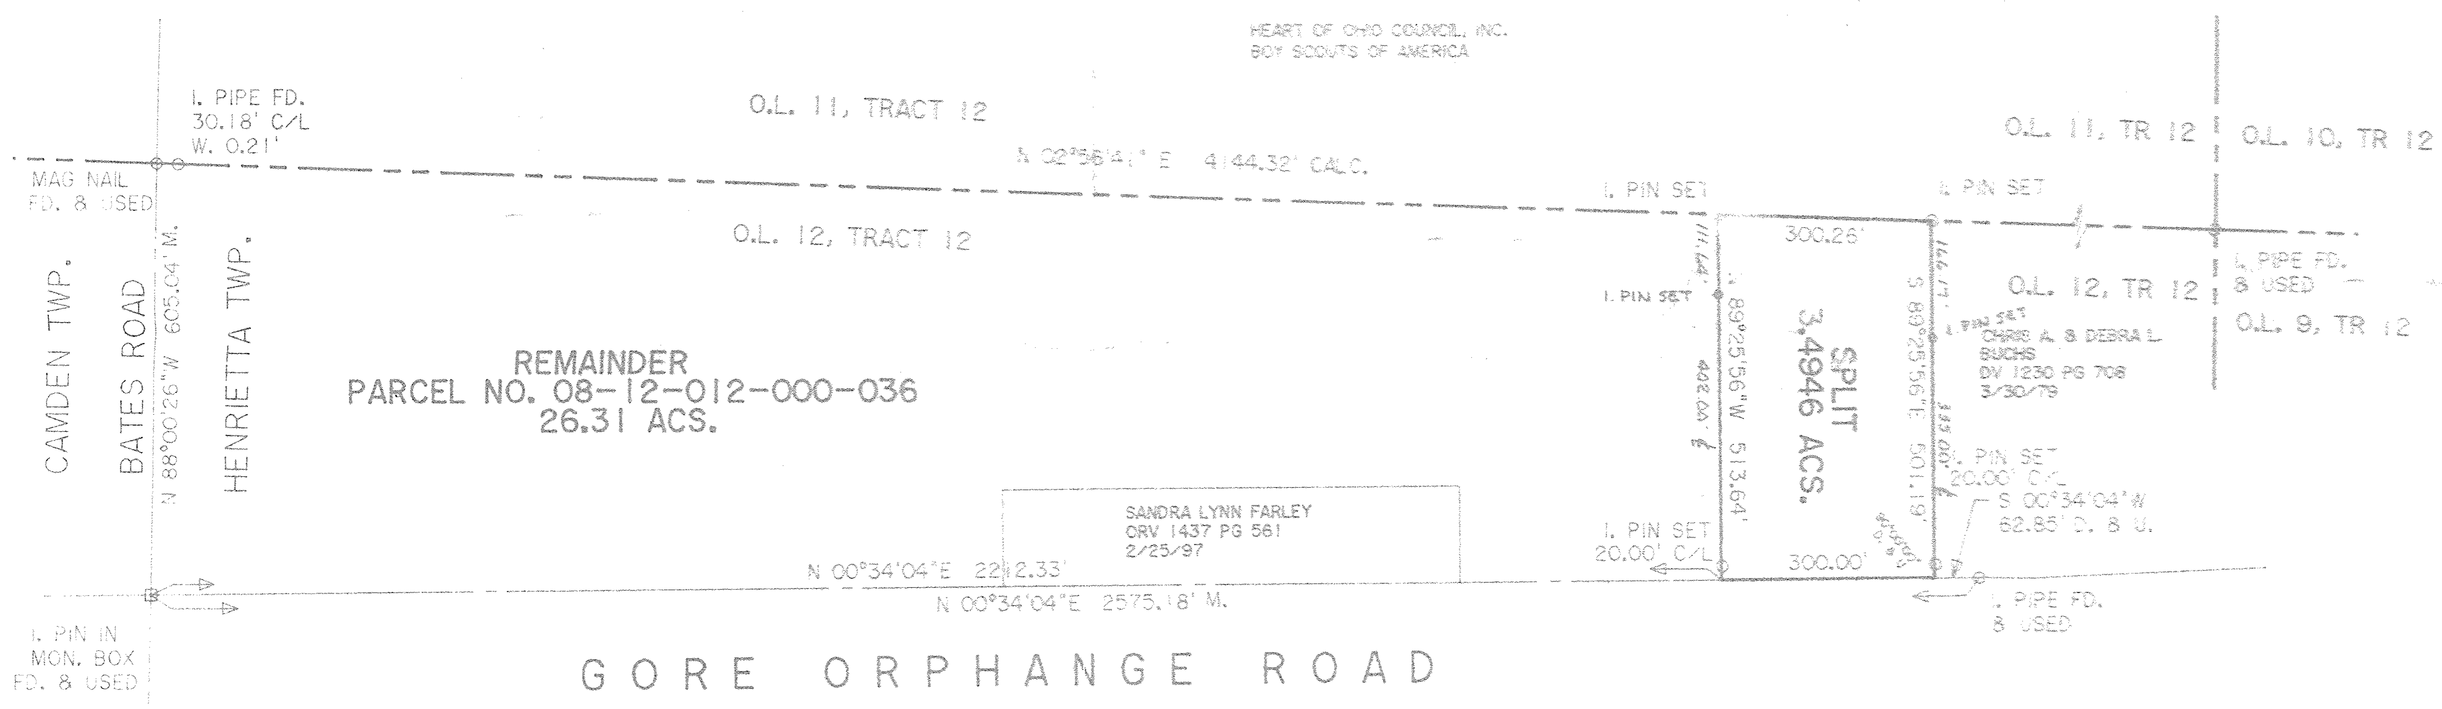

APPROVED
LORAIN CO.
MAP DEPT.
DATE 6-19-08
08-12-012-000-036
PAGE 8-E
BY JHatfield
08-02581
No. 02581

THOMAS SIMON & ASSOCIATES, INC.
PROFESSIONAL LAND SURVEYORS
[illegible] SOUTH OLIVE STREET
ELYRIA, OHIO 44035
(440) 327-2825
FAX 327-2864

PLAT OF SURVEY & SPLIT FOR WILLIAM AND JAMES BORN

BEING KNOWN AS PART OF ORIGINAL HENRIETTA TOWNSHIP
LOT NO. 12, TRACT 12

COUNTY OF LORAIN STATE OF OHIO

MARCH, 2008 SCALE: 1" = 200'

JOB NO. 2008-010