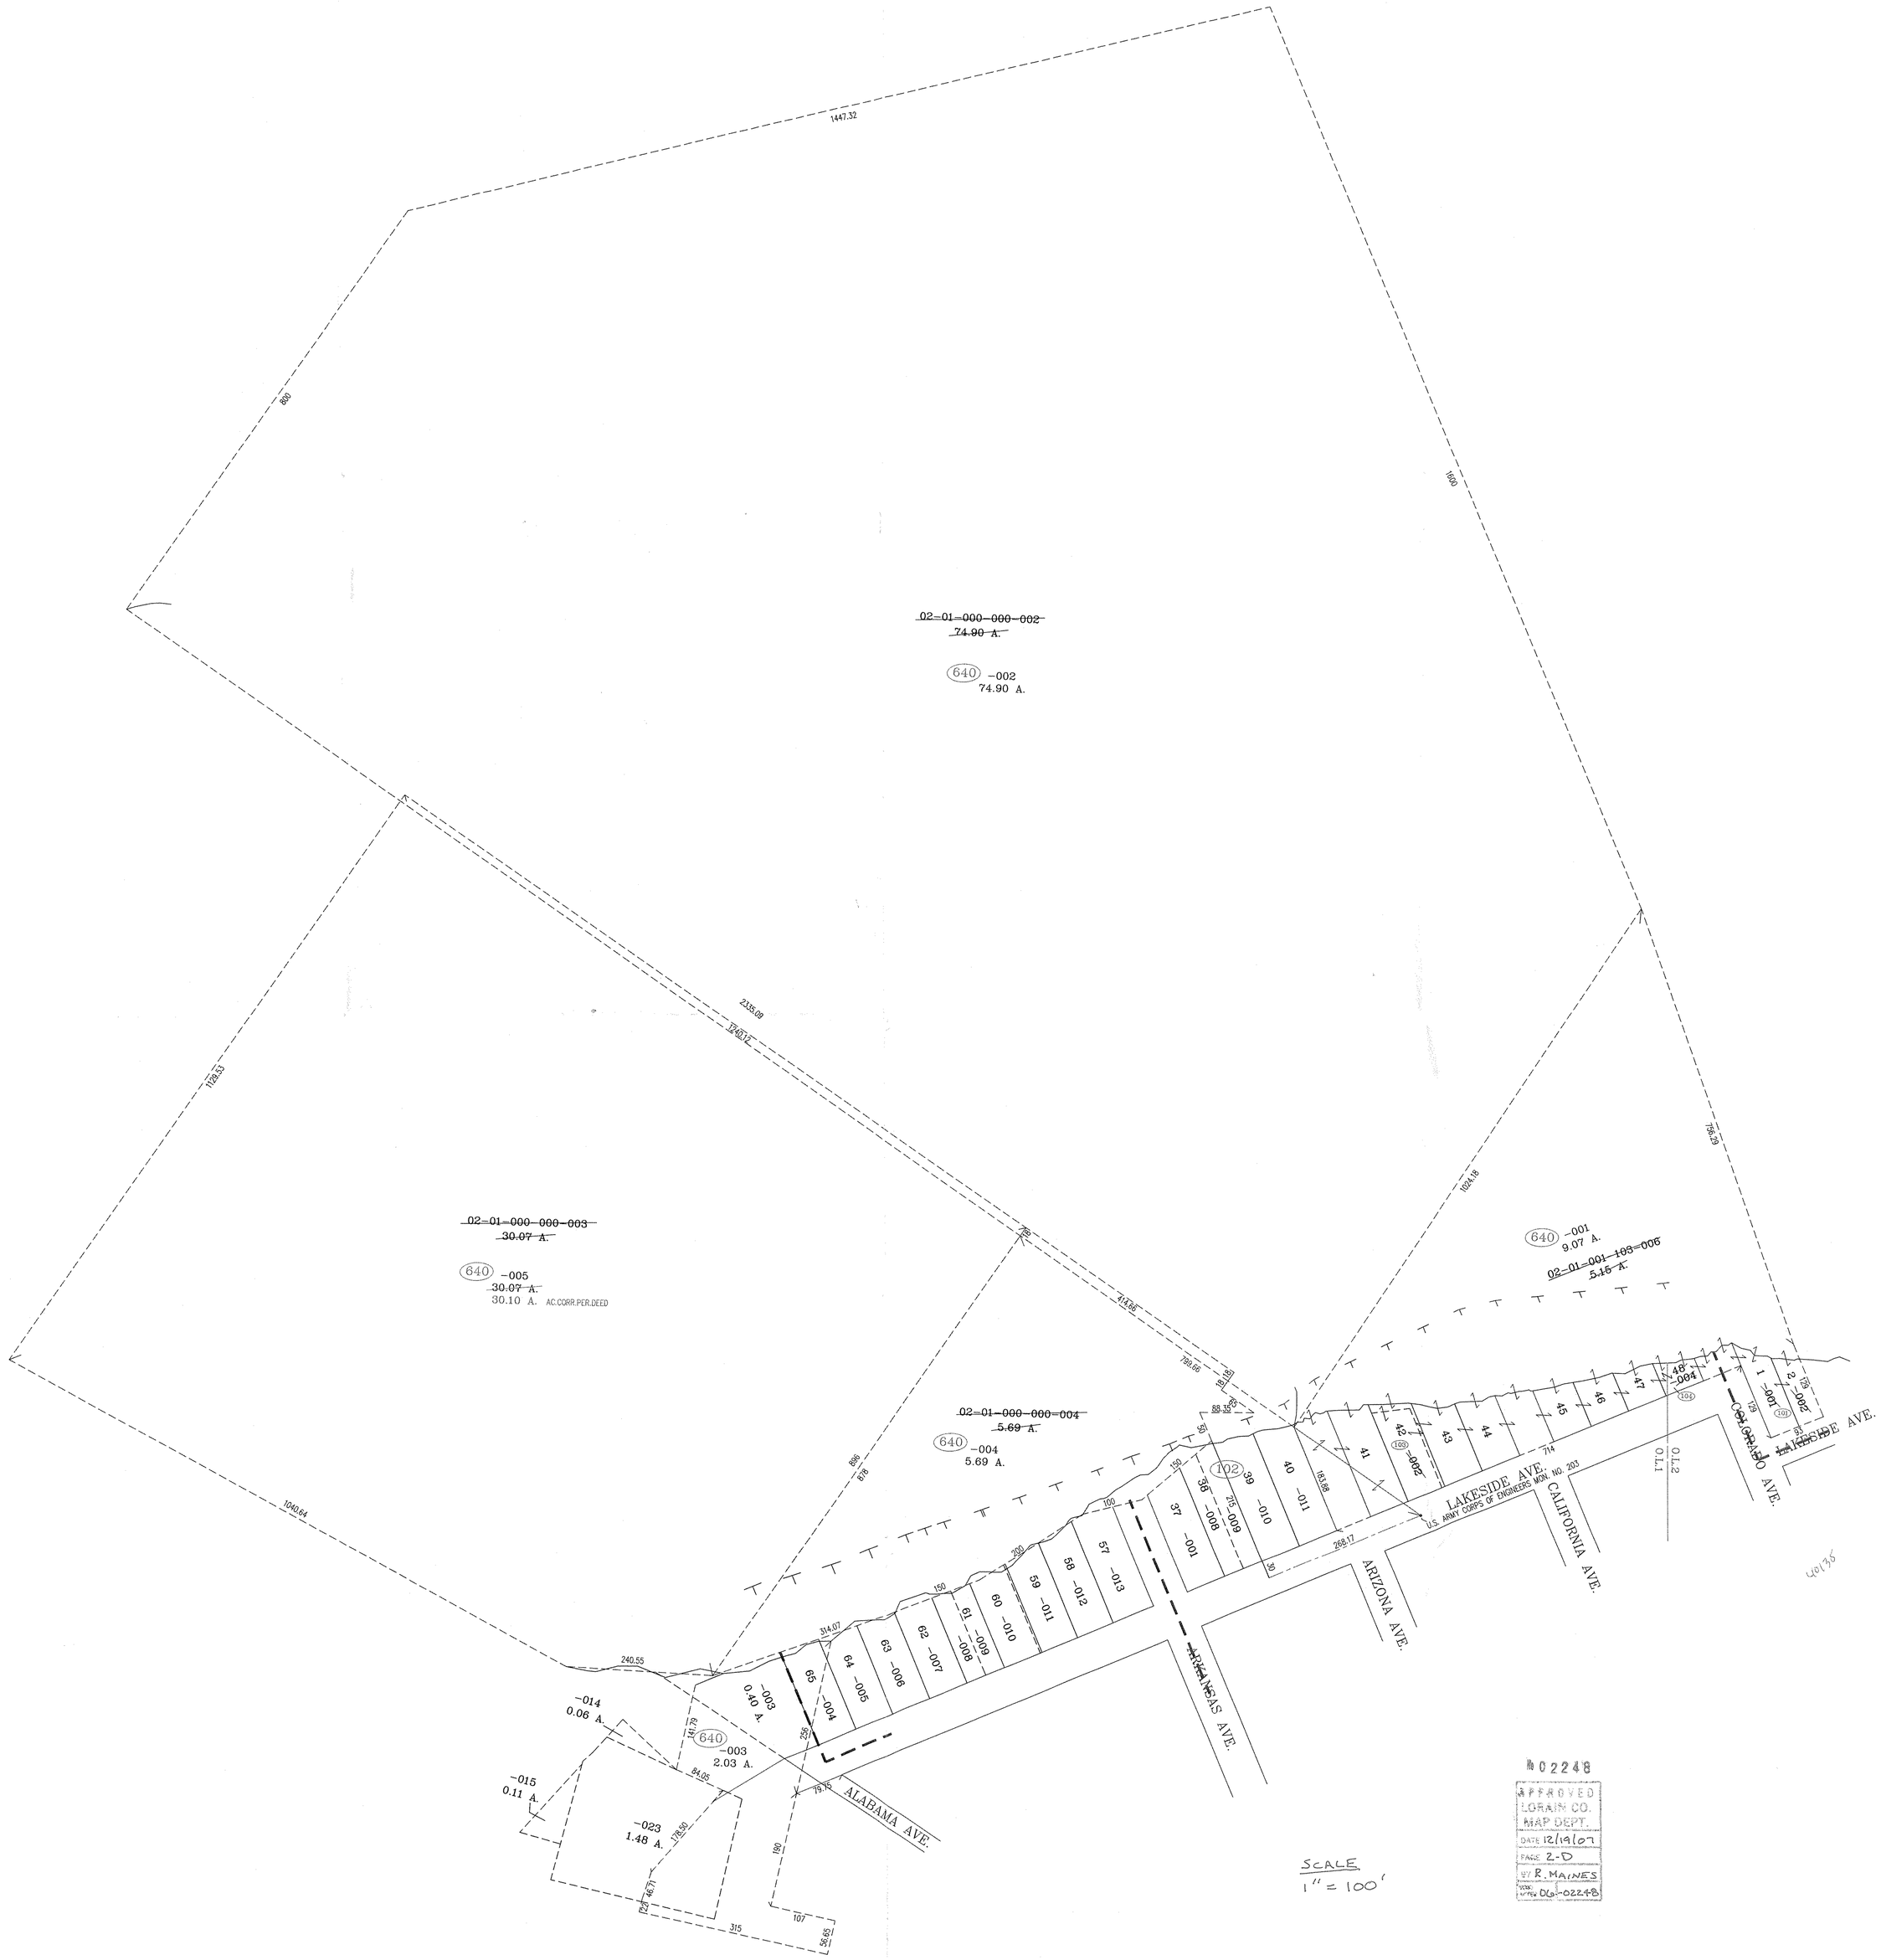
1447.32
800
1600
~~02-01-000-000-002~~
~~74.90 A.~~
640 -002
74.90 A.
2335.09
1260.17
1128.53
756.29
1024.18
~~02-01-000-000-003~~
~~30.07 A.~~
640 -005
~~30.07 A.~~
30.10 A. AC.CORR.PER.DEED
640 -001
9.07 A.
~~02-01-001-103-006~~
~~5.16 A.~~
~~02-01-000-000-004~~
~~5.69 A.~~
640 -004
5.69 A.
1040.64
896
878
714.66
788.66
88.35
102
36 -008
37 -001
39 -010
40 -011
41
42 -002
43
44
45
46
47
48 -004
1 -001
2 -002
57 -013
58 -012
59 -011
60 -010
61 -009
62 -007
63 -006
64 -005
65 -004
-003
0.40 A.
640 -003
2.03 A.
-014
0.06 A.
-015
0.11 A.
-023
1.48 A.
240.55
314.07
141.79
84.05
178.50
46.71
79.15
315
107
56.65
LAKESIDE AVE.
U.S. ARMY CORPS OF ENGINEERS MON. NO. 203
268.17
ARIZONA AVE.
CALIFORNIA AVE.
COLORADO AVE.
O.L.1
O.L.2
ARKANSAS AVE.
ALABAMA AVE.
SCALE
1" = 100'
APPROVED
LORAIN CO.
MAP DEPT.
DATE 12/19/07
PAGE 2-D
BY R. MAINES
NO. 02248
DEV. DEV-02248