


895-1

MAP P3 05-00-003-B

PPN 05-00-035-000-777

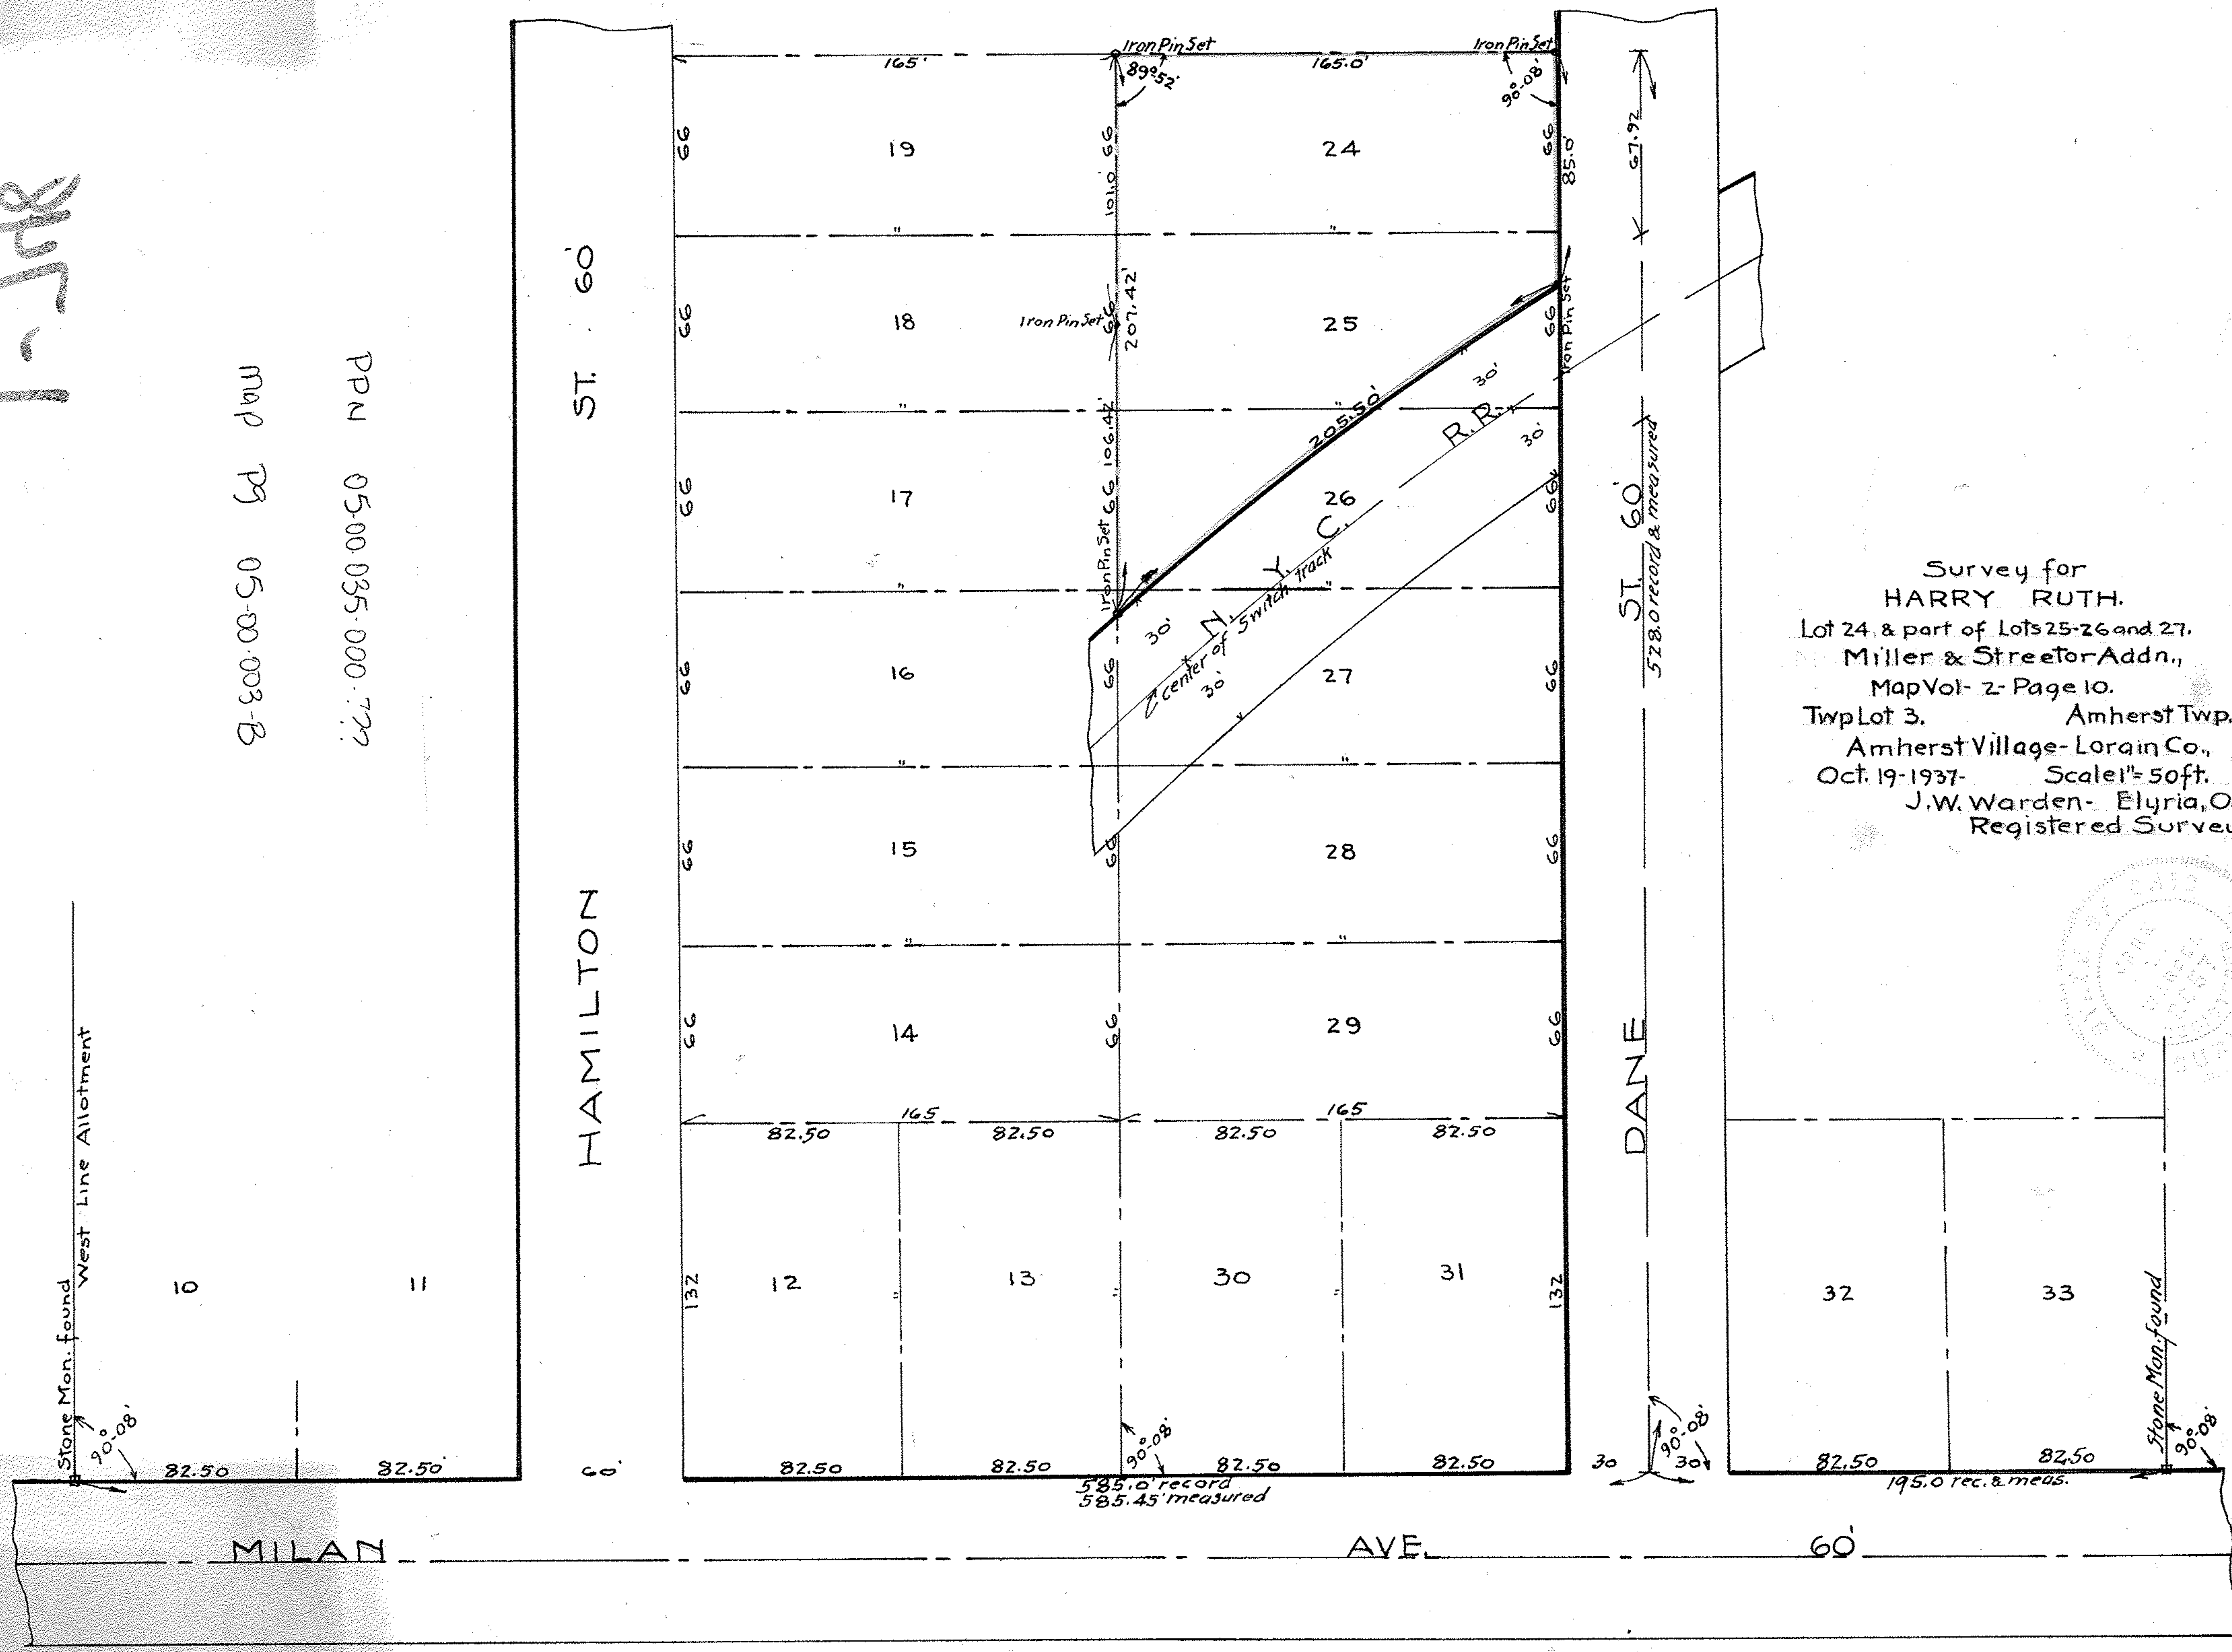

Survey for  
**HARRY RUTH.**  
 Lot 24 & part of Lots 25-26 and 27.  
 Miller & Streetor Addn.,  
 Map Vol- 2- Page 10.  
 Twp Lot 3, Amherst Twp.,  
 Amherst Village- Lorain Co.,  
 Oct. 19-1937- Scale 1"= 50ft.  
 J.W. Warden- Elyria, Ohio.  
 Registered Surveyor.

