


Survey for
WALTER A. KRUECK
 OL Lot 91 Amherst Township
 South Amherst Village
 Lorain County Ohio.
 D-Vol. 194 Pg 335 Aug. 27, 1923
 Scale 1"=50' Jan. 8, 1949.
 J.W. Warden, Registered Surveyor.

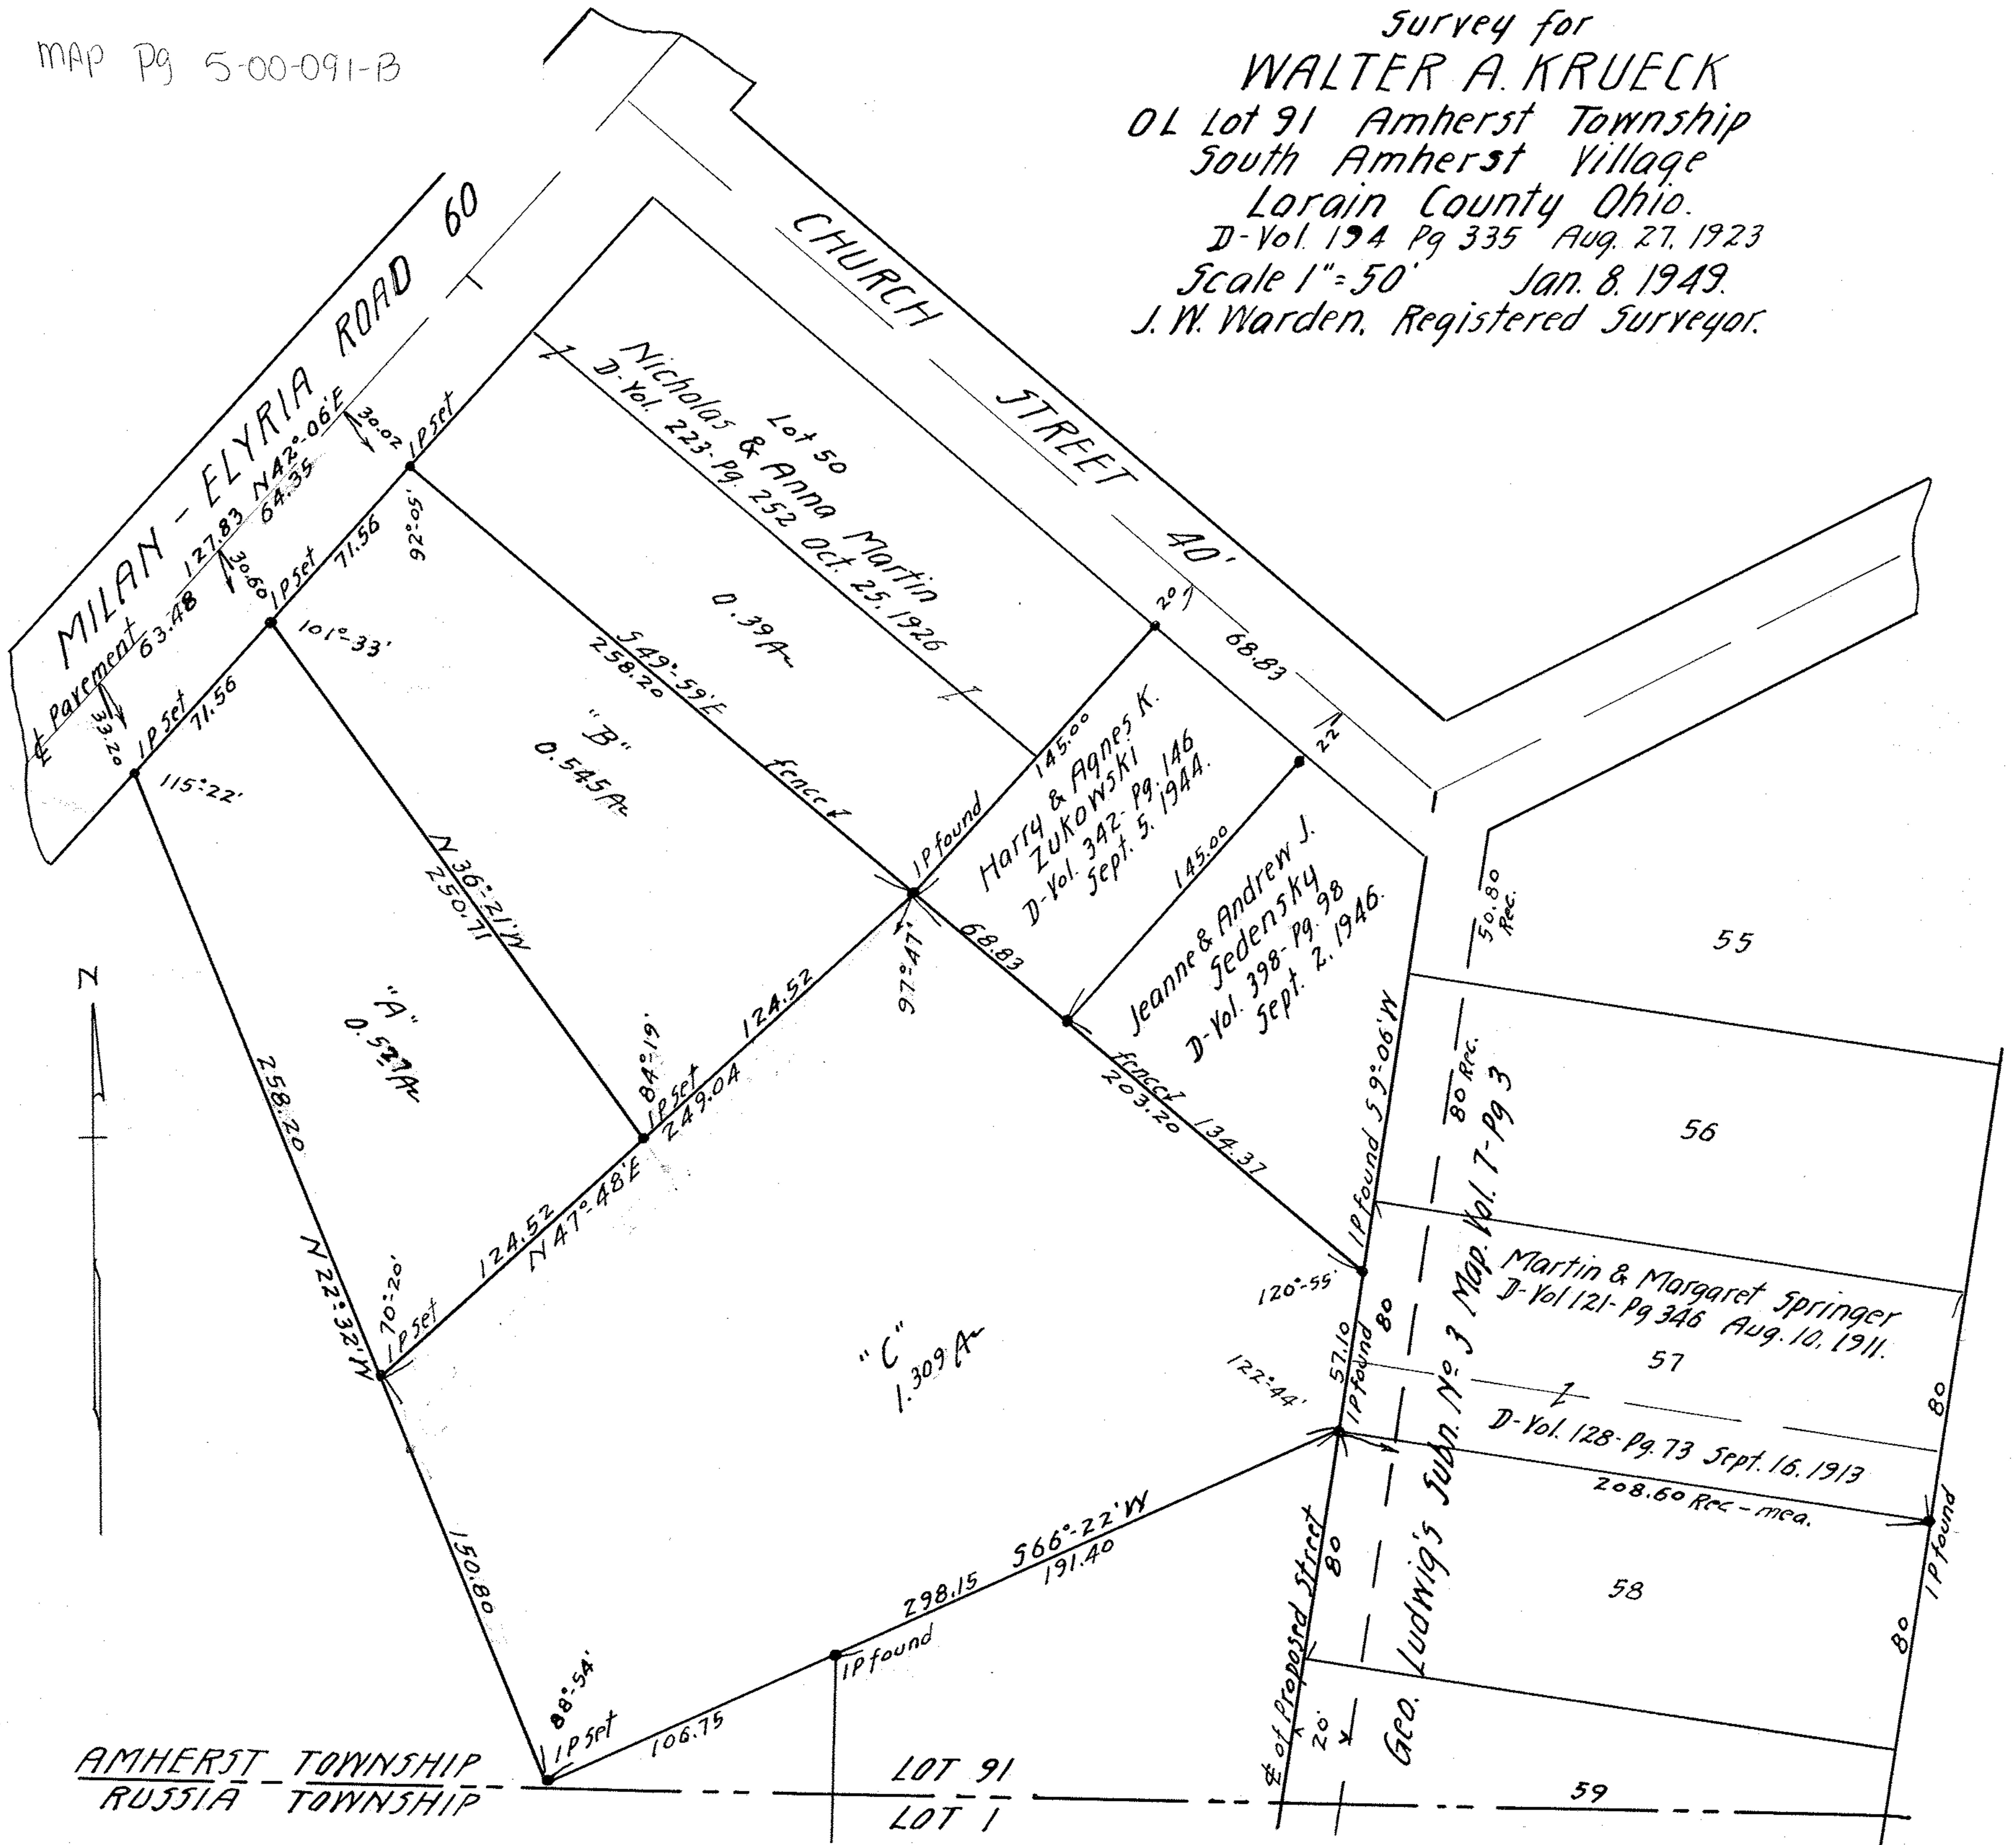

AMHERST TOWNSHIP
 RUSSIA TOWNSHIP

LOT 91
 LOT 1

Geo. Ludwig's Subn. No. 3
 Map Vol. 7-Pg 3

Martin & Margaret Springer
 D-Vol 121-Pg 346 Aug. 10, 1911.

D-Vol. 128-Pg 73 Sept. 16, 1913
 208.60 Rec - mea.

Harry & Agnes K.
 ZUKOWSKI
 D-Vol. 342-Pg 146
 Sept. 5, 1944.

Jeanne & Andrew J.
 JEDENSKY
 D-Vol. 398-Pg 98
 Sept. 2, 1946.

Nicholas & Anna Martin
 Lot 50
 D-Vol. 223-Pg 252 Oct. 25, 1926

"A"
 0.537A

"B"
 0.545A

"C"
 1.309A

50.80
 Rec.

80 Rec.

80

80

