200722

SURVEY FOR EMMETT SAYLES
LOT 2 SHEFFIELD TOWNSHIP
Scale 1 in. = 100 ft. August 19-1916
C. H. Lawrence C.E.

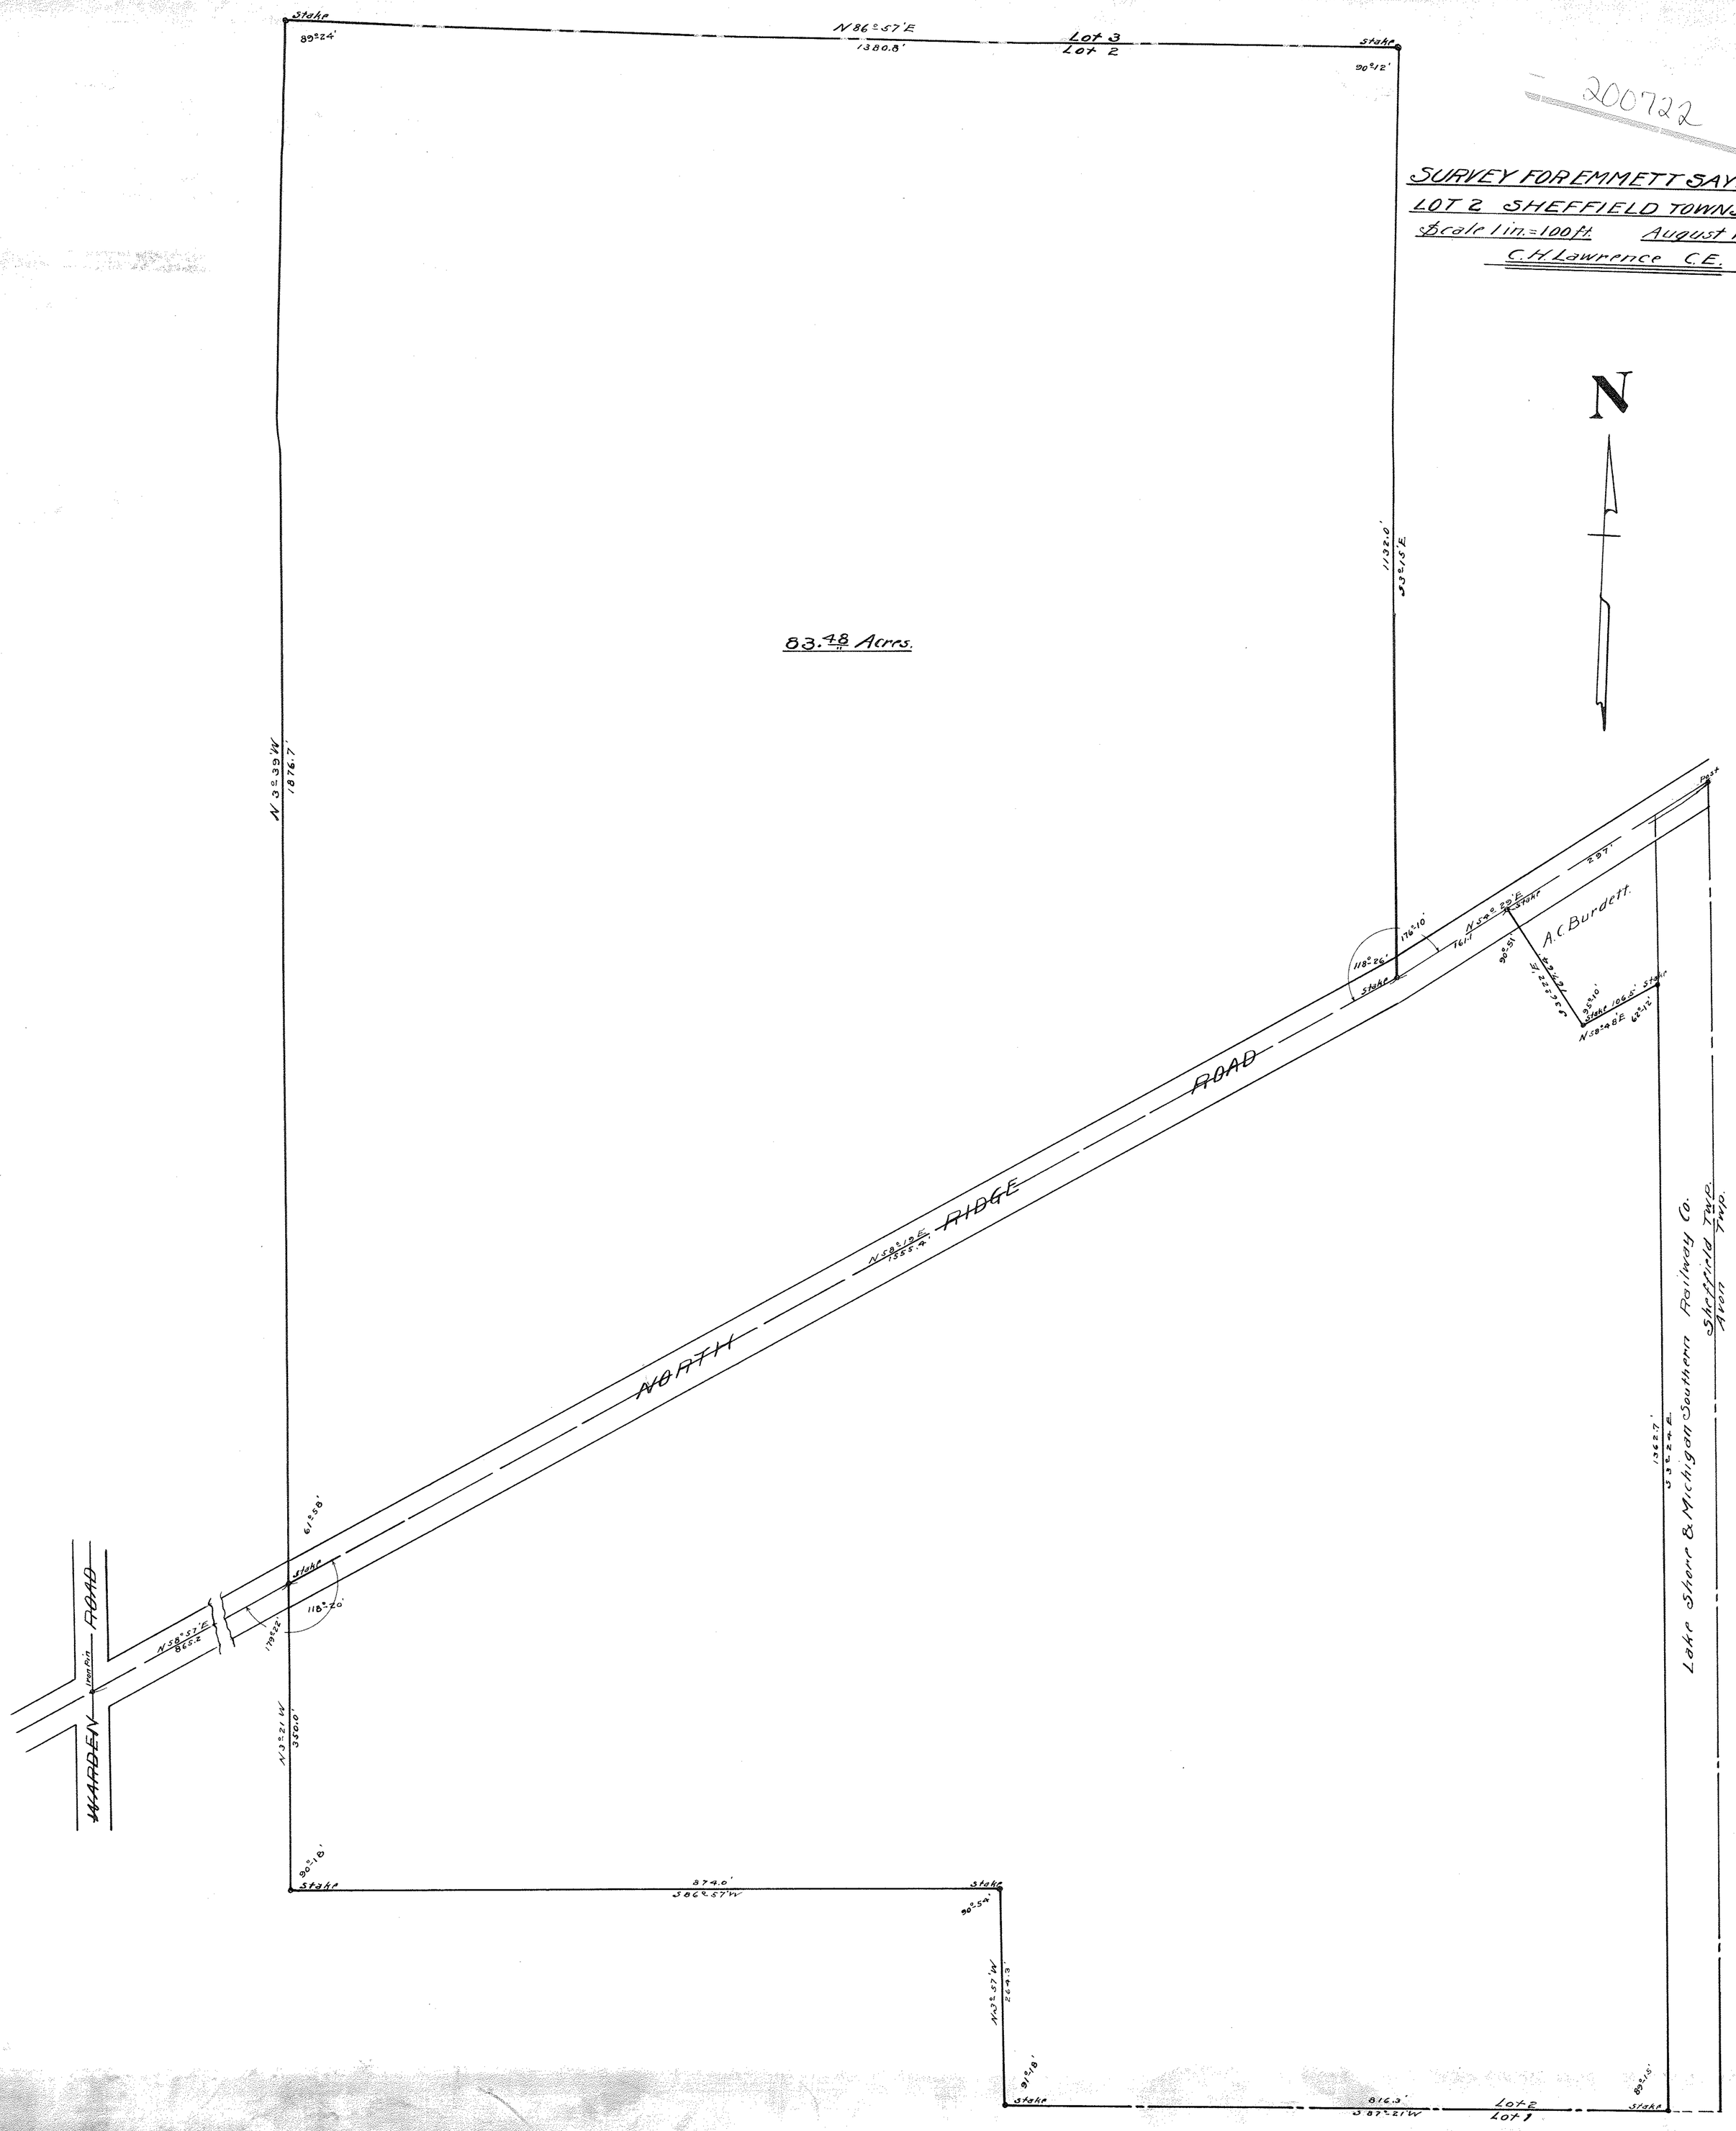

ITWP PG 0300-00243