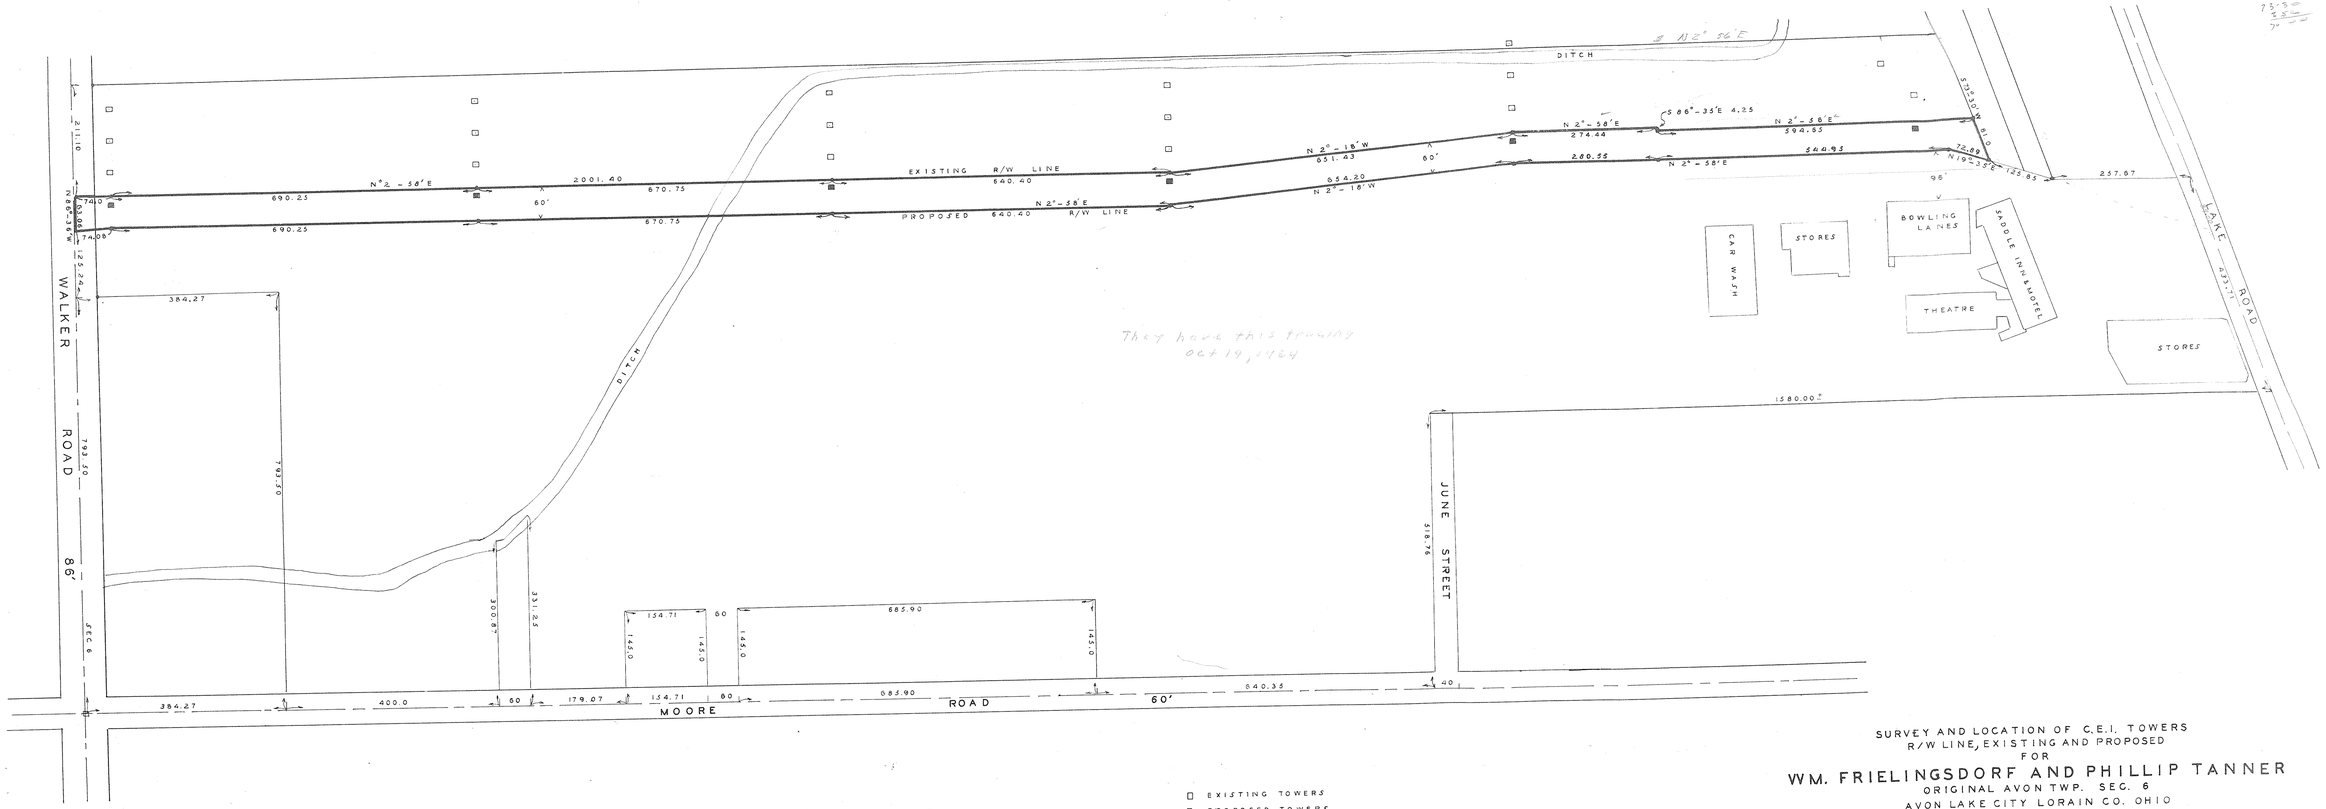

EXISTING TOWERS
PROPOSED TOWERS
INDICATES IRON STAKES

SURVEY AND LOCATION OF C.E.I. TOWERS
R/W LINE, EXISTING AND PROPOSED
FOR
WM. FRIELINGSDORF AND PHILLIP TANNER
ORIGINAL AVON TWP. SEC. 6
AVON LAKE CITY LORAIN CO. OHIO
SCALE 1" = 100' OCT. 17, 1964
J. W. WARDEN AND ASSOCIATES REG. SURVEYORS

STATE OF OHIO
J. W. WARDEN
3239
REGISTERED
SURVEYOR

PPN 04-00-006-135-223

Map PN 4-00-006-11