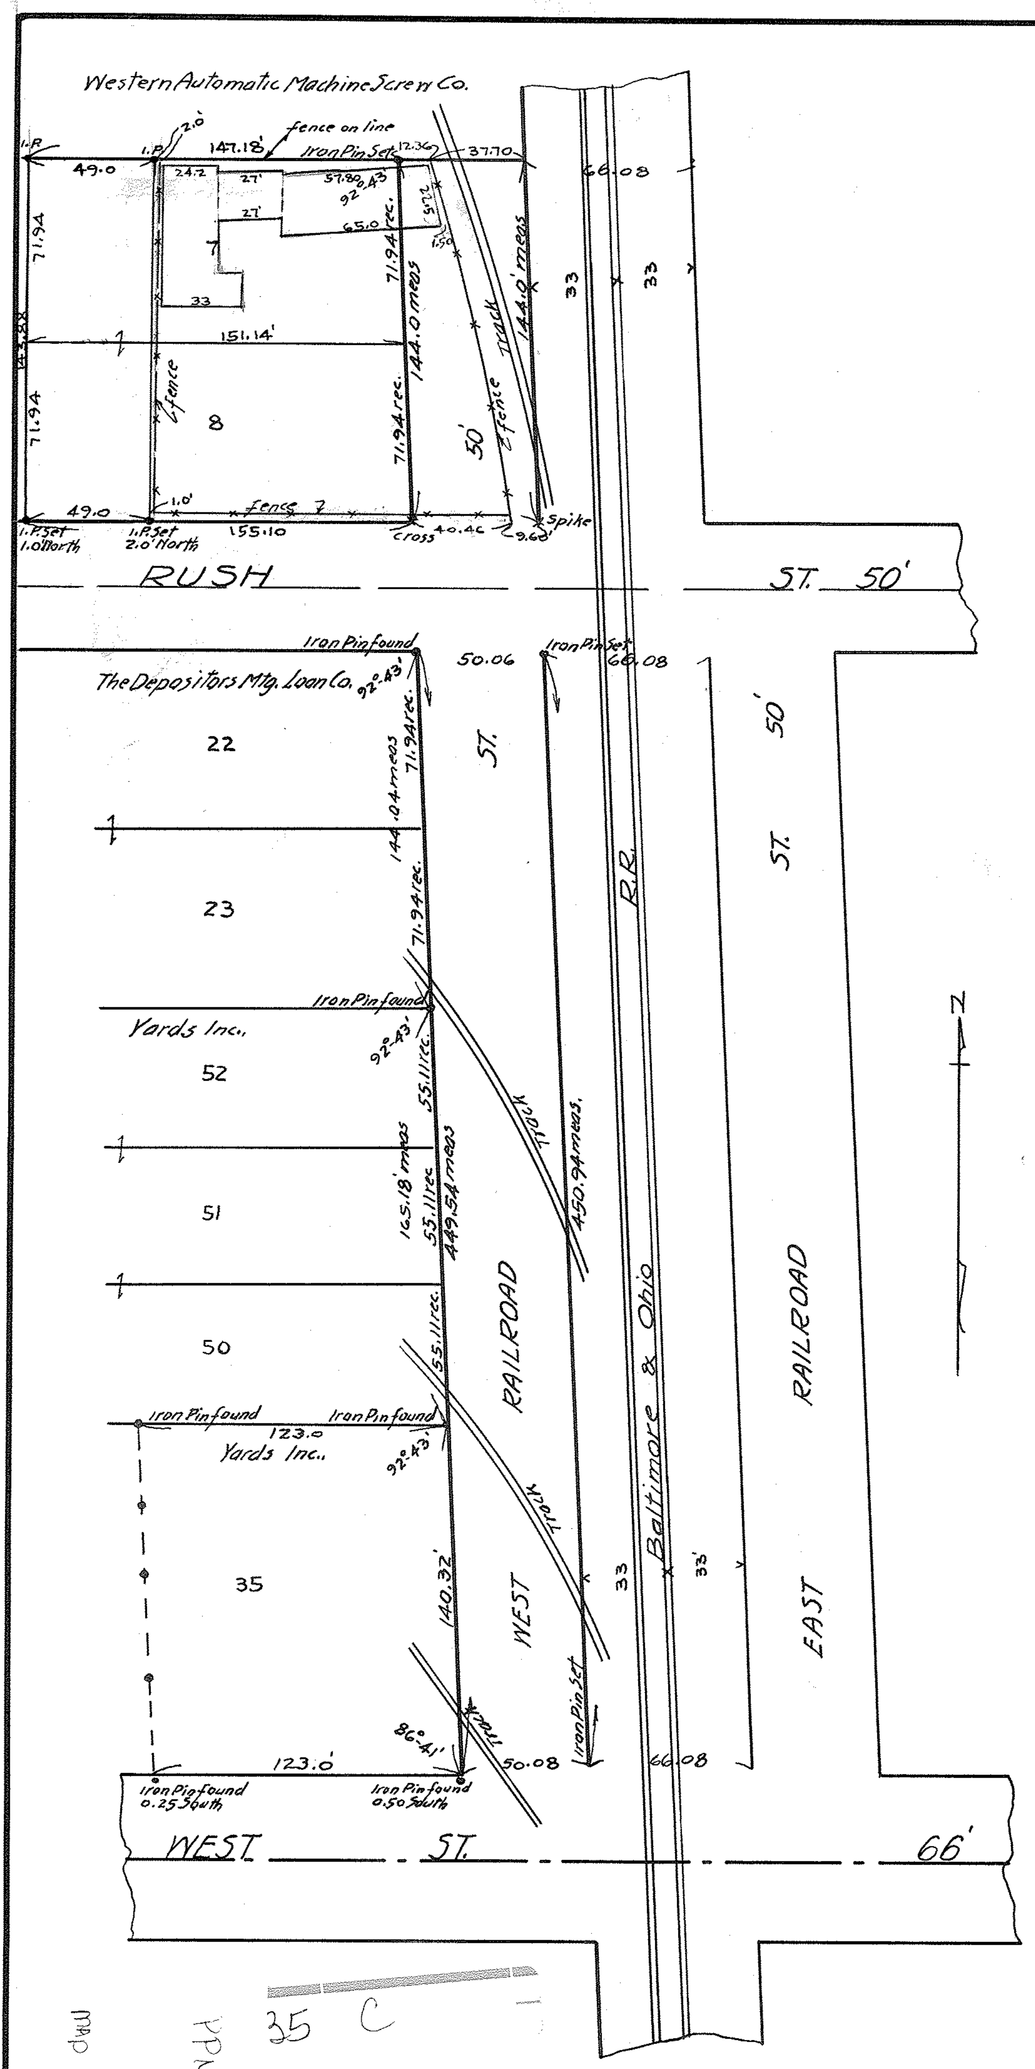

35 C

Survey of

WEST RAILROAD STREET.

C.A. & F. Bronson Addn. Map Vol-2-Pg. 15.

O. L. 85- West of Black River, Elyria Twp.,

Elyria City, Lorain Co., Ohio.

Dec. 8. 1942. Scale 1"= 50'.

J. W. Warden, Registered Surveyor.

Revised as to Lots 7 and 8- July-11-1945.

Map Pg 5-98

PPN 06-24-085-102-017