201269

3

SURVEY FOR
DOROTHY HINCKLEY
D.-VOL.572-PG.455 JULY 20, 1951

O.L.43 COLUMBIA TOWNSHIP

LORAIN COUNTY OHIO

SCALE 1"=200' OCT. 19, 1956

J. W. WARDEN & ASSOCIATES REG. SURVEYORS

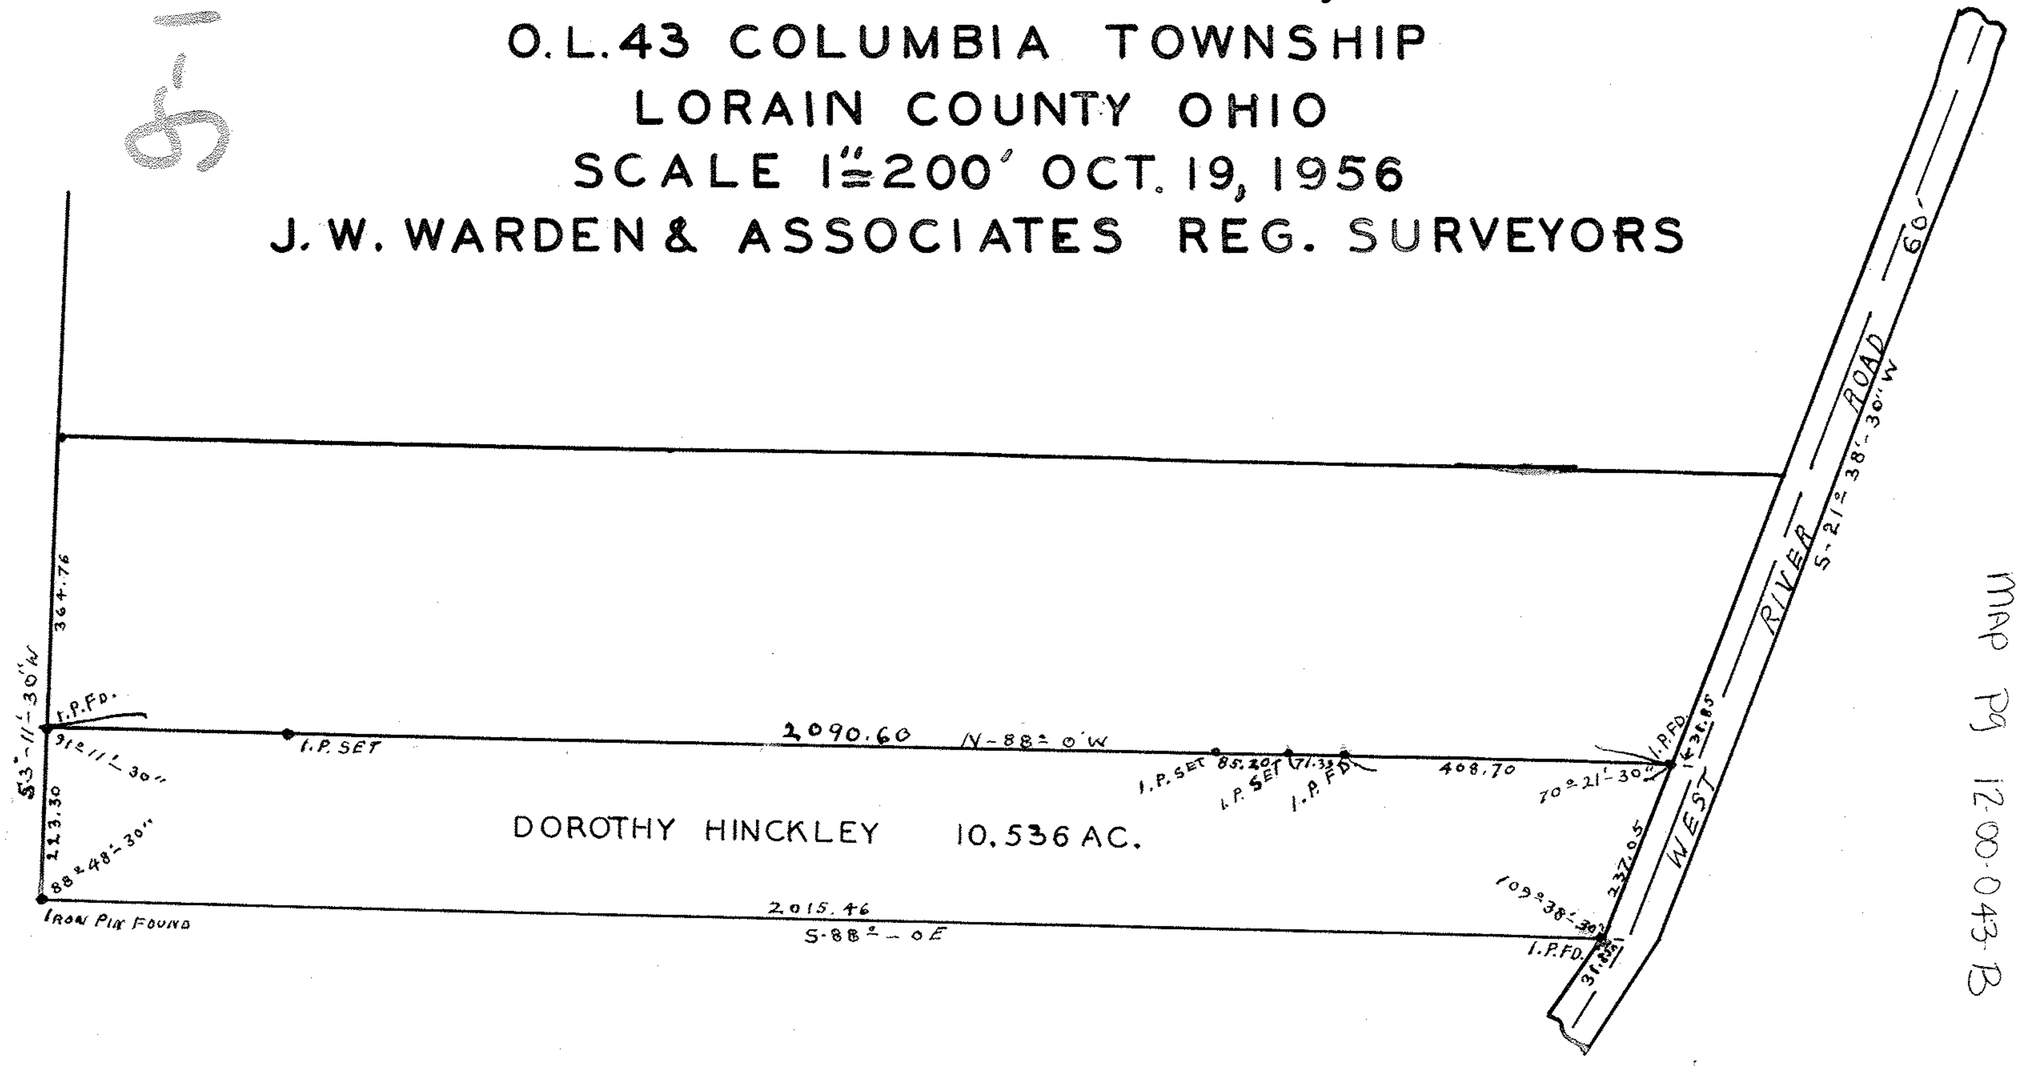

PPN 12-00-043-000.22

MAP PG 12-00-043-B