95-1185

PPN 06-24-043-101-???
06-24-048-000-???

MAP PG 6-57
6-56

SURVEY FOR

CHARLES S. AND CARROLL R. POWELL

D-VOL. 539 PG. 199 MARCH 8, 1952
ORIGINAL LOTS 43-48 ELYRIA TWP.
LORAIN COUNTY, OHIO
SCALE 1" = 100' NOV. 5, 1953
J. W. WARDEN AND ASSOCIATES REG. SURVEYOR'S

201182

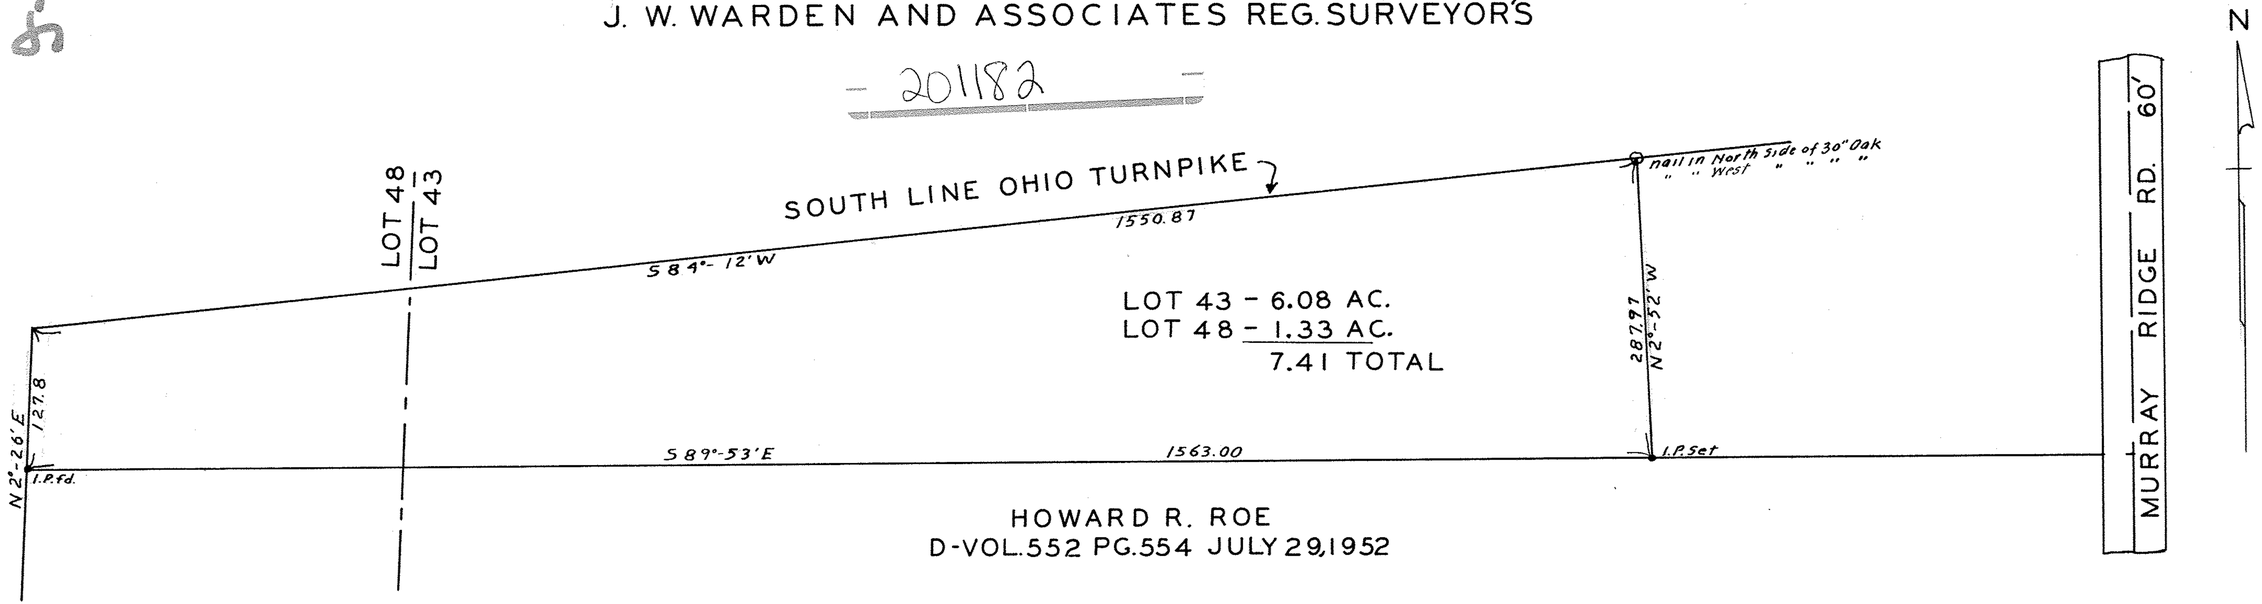

HOWARD R. ROE
D-VOL. 552 PG. 554 JULY 29, 1952