

PP N 04-00-030-103-014
015

MAP P9 04-00-030-A


West line Section #30

D Vol-152-Pg 75
Ross W. B. Craft to Dora Williamson
July 2-1918-94ft

D Vol-145-Pg 566 - Sept 18-1917
Ross W. B. Craft
to
Dora Williamson

D Vol-145-Pg 565 - Sept 15-1917 Survey for
William M Cunningham Dora Williamson
Marie A " Lots 10-11 & part 12 - Avon Lake Hamlet
to Dora Williamson Recorded in Map Vol-4-Pg 20.
Section 30. Avon Lake Village,
Lorain Co., Ohio.
Scale 1 inch = 30 ft. Sept 23, 1924.

The Avon Dover Land Co.

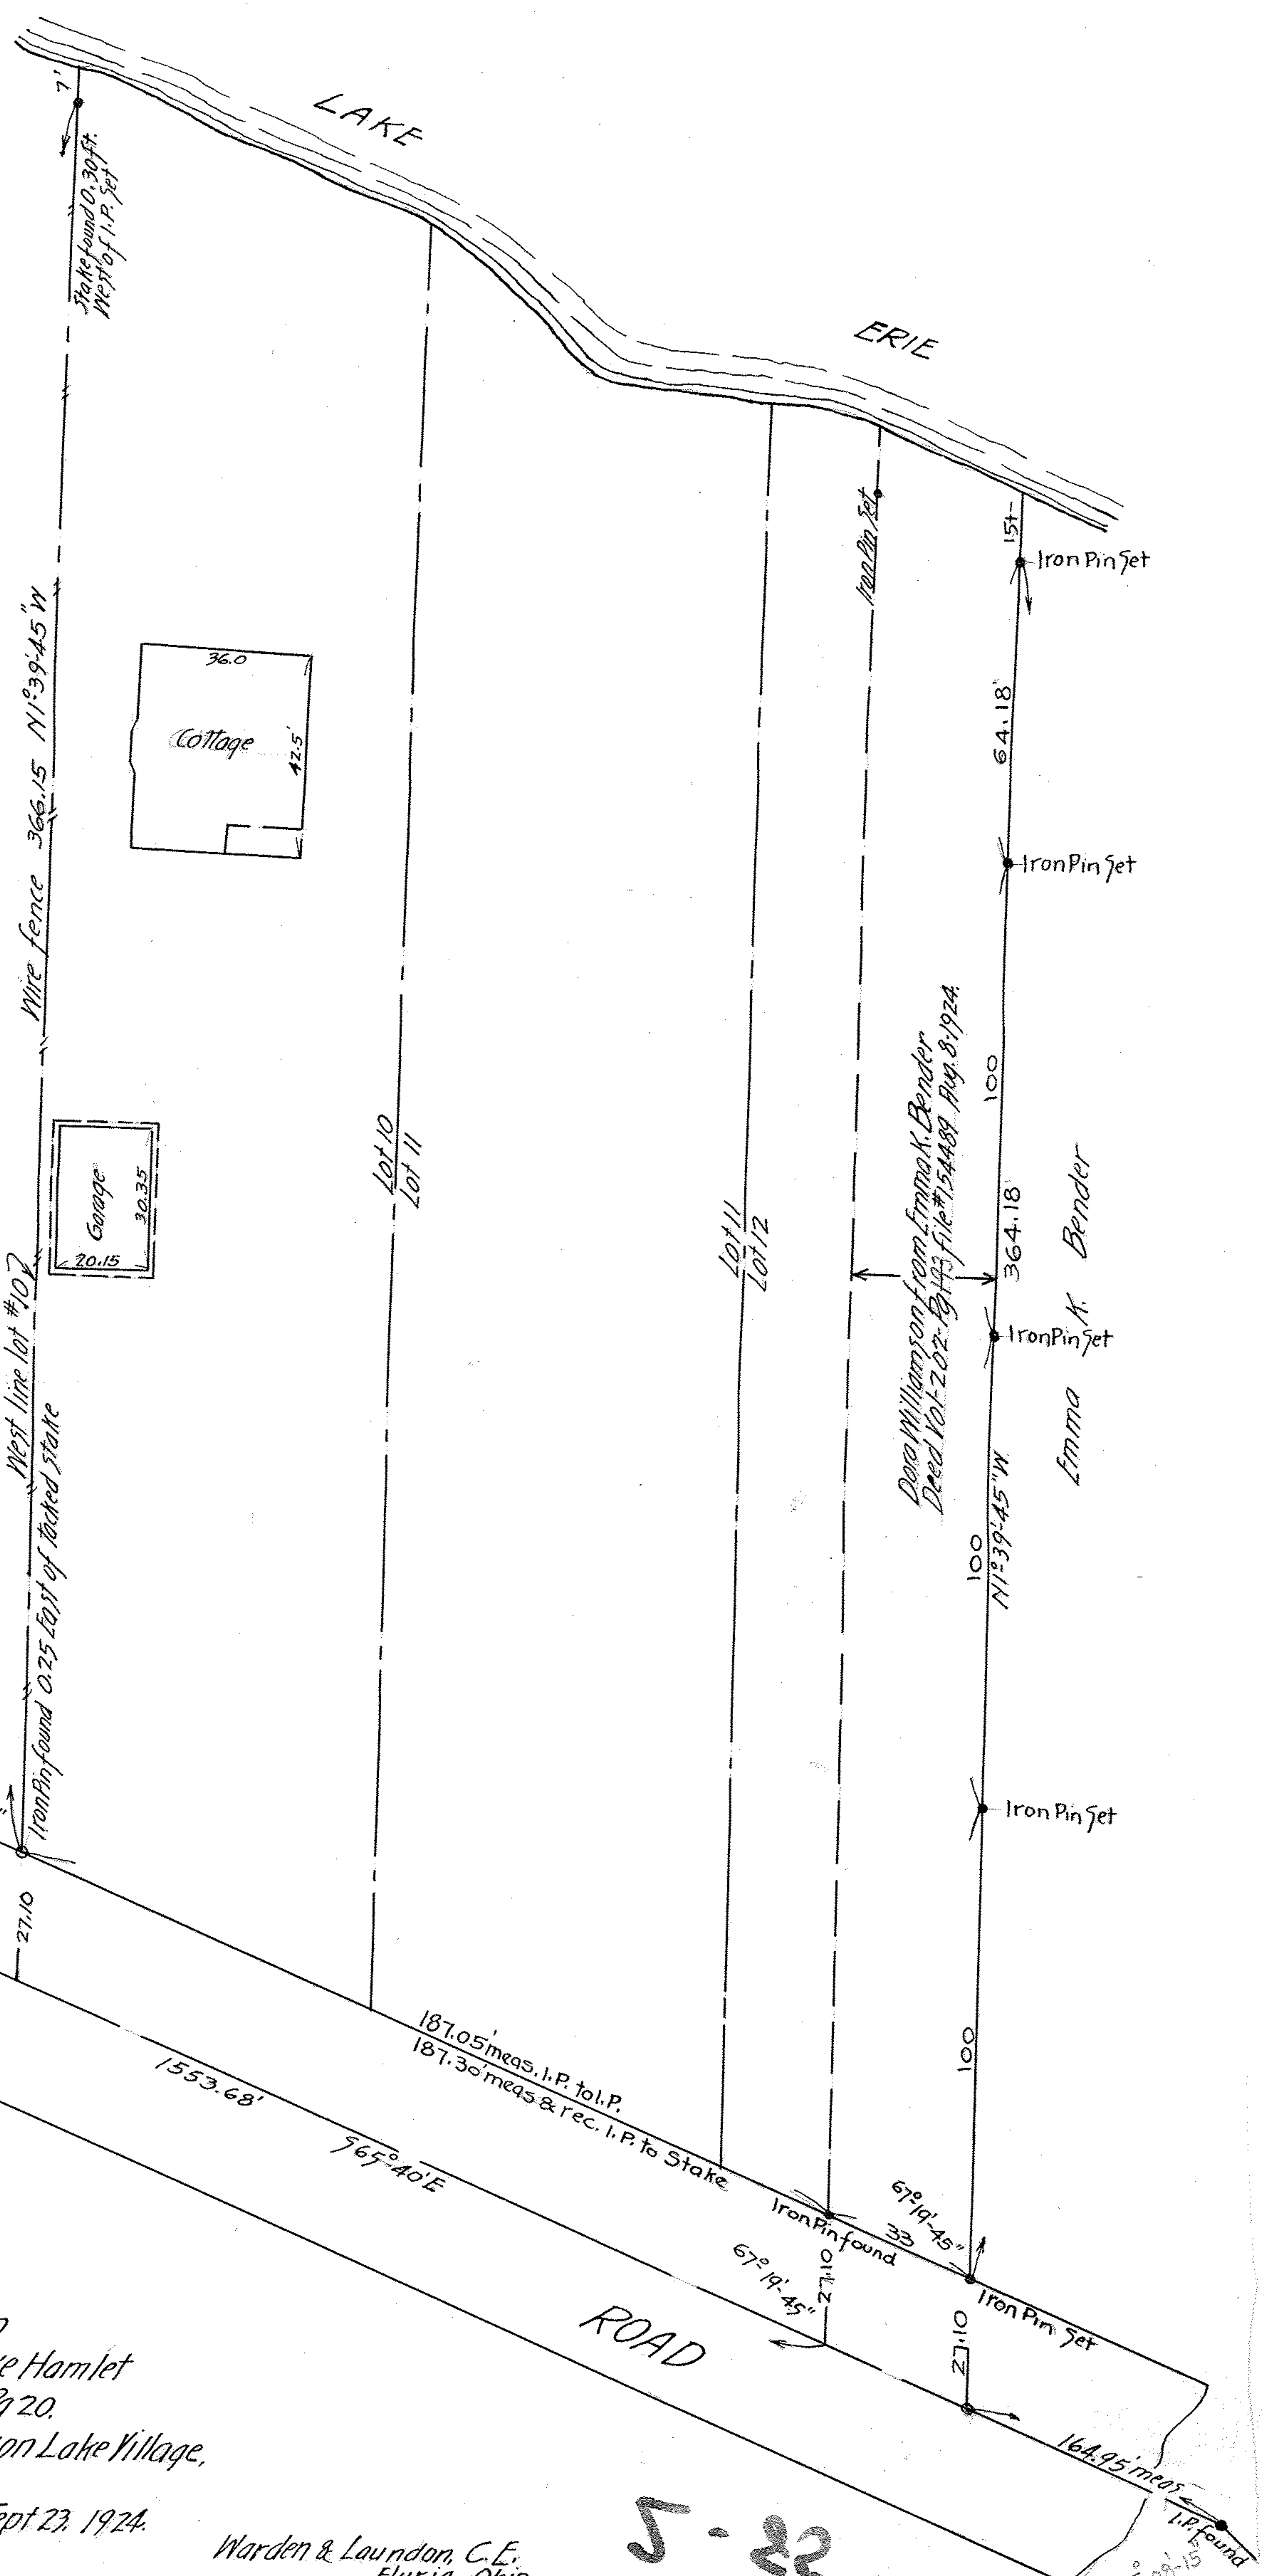

Warden & Laundon, C.E.
Eluria, Ohio.

5-22

75-08-15
I.P. found