PPN 06-24-085104-???

MAP Pg 6-99
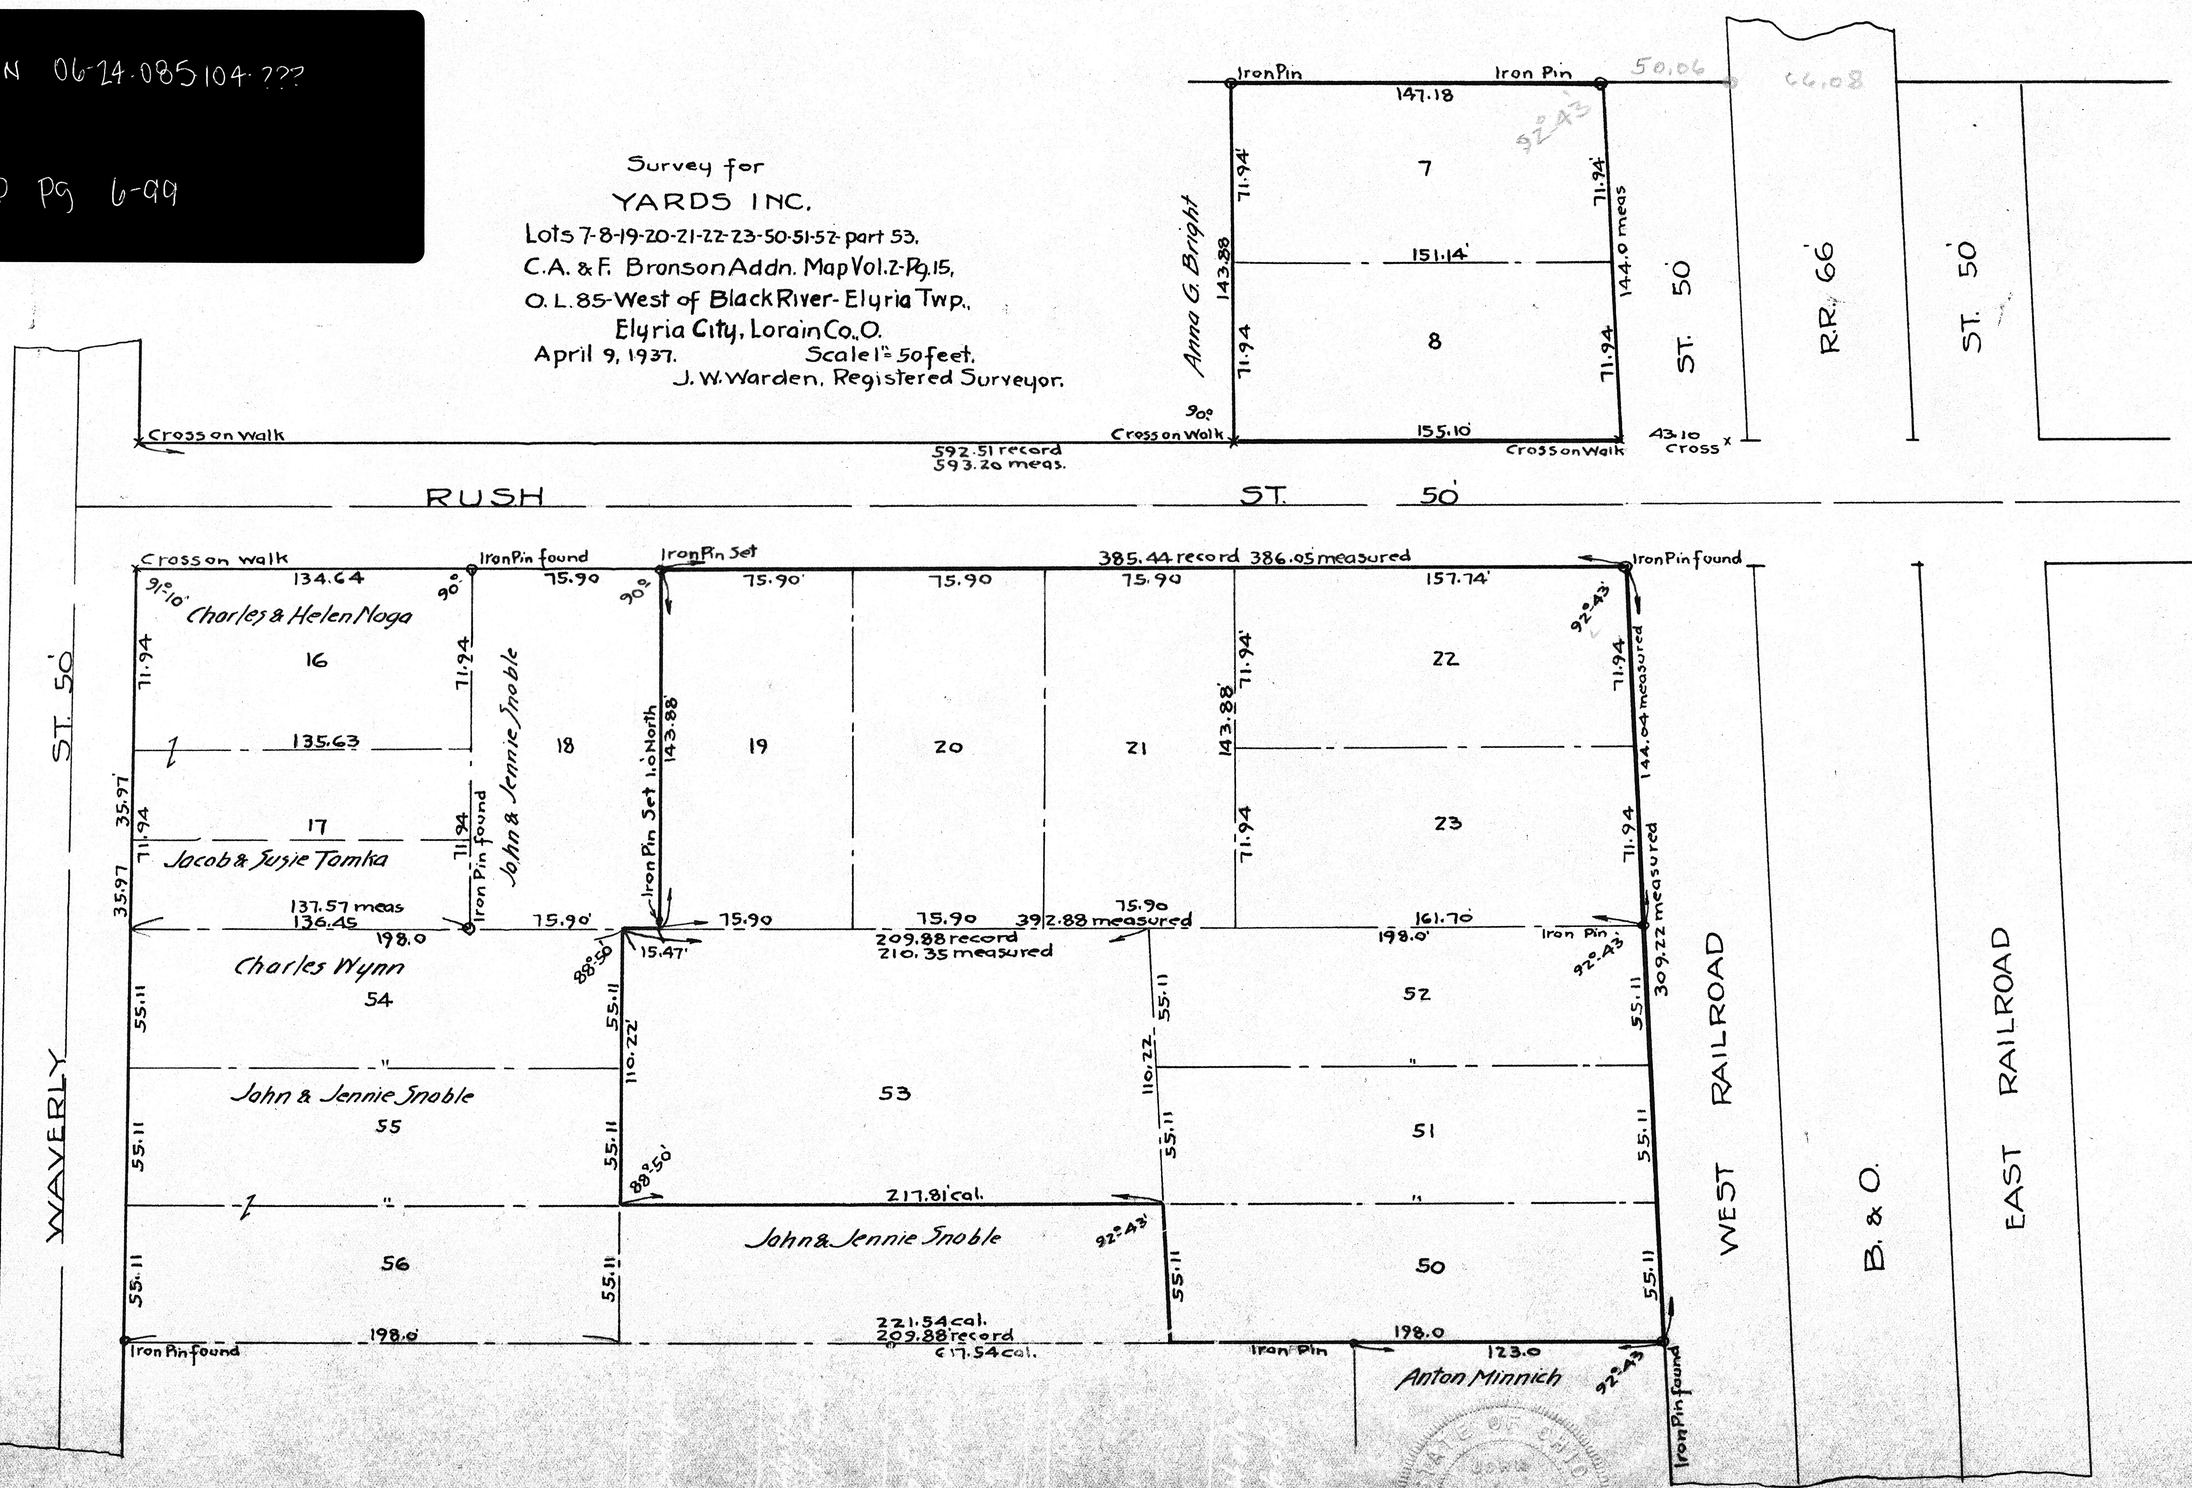
Survey for
YARDS INC.
Lots 7-8-19-20-21-22-23-50-51-52-part 53.
C.A. & F. Bronson Addn. Map Vol. 2-Pg. 15,
O.L. 85-West of Black River-Elyria Twp.,
Elyria City, Lorain Co., O.
April 9, 1937. Scale 1" = 50 feet.
J. W. Warden, Registered Surveyor.