Map of
Land to be sold by
The Board of Education of Oberlin Village School District
Village of Oberlin - Lorain Co., Ohio.

March 7, 1923. Scale 1 inch = 30 feet.

Warden and Launden.
Civil Engineers.

Note:- At all points marked thus •, iron pins have been set.
W. & L.

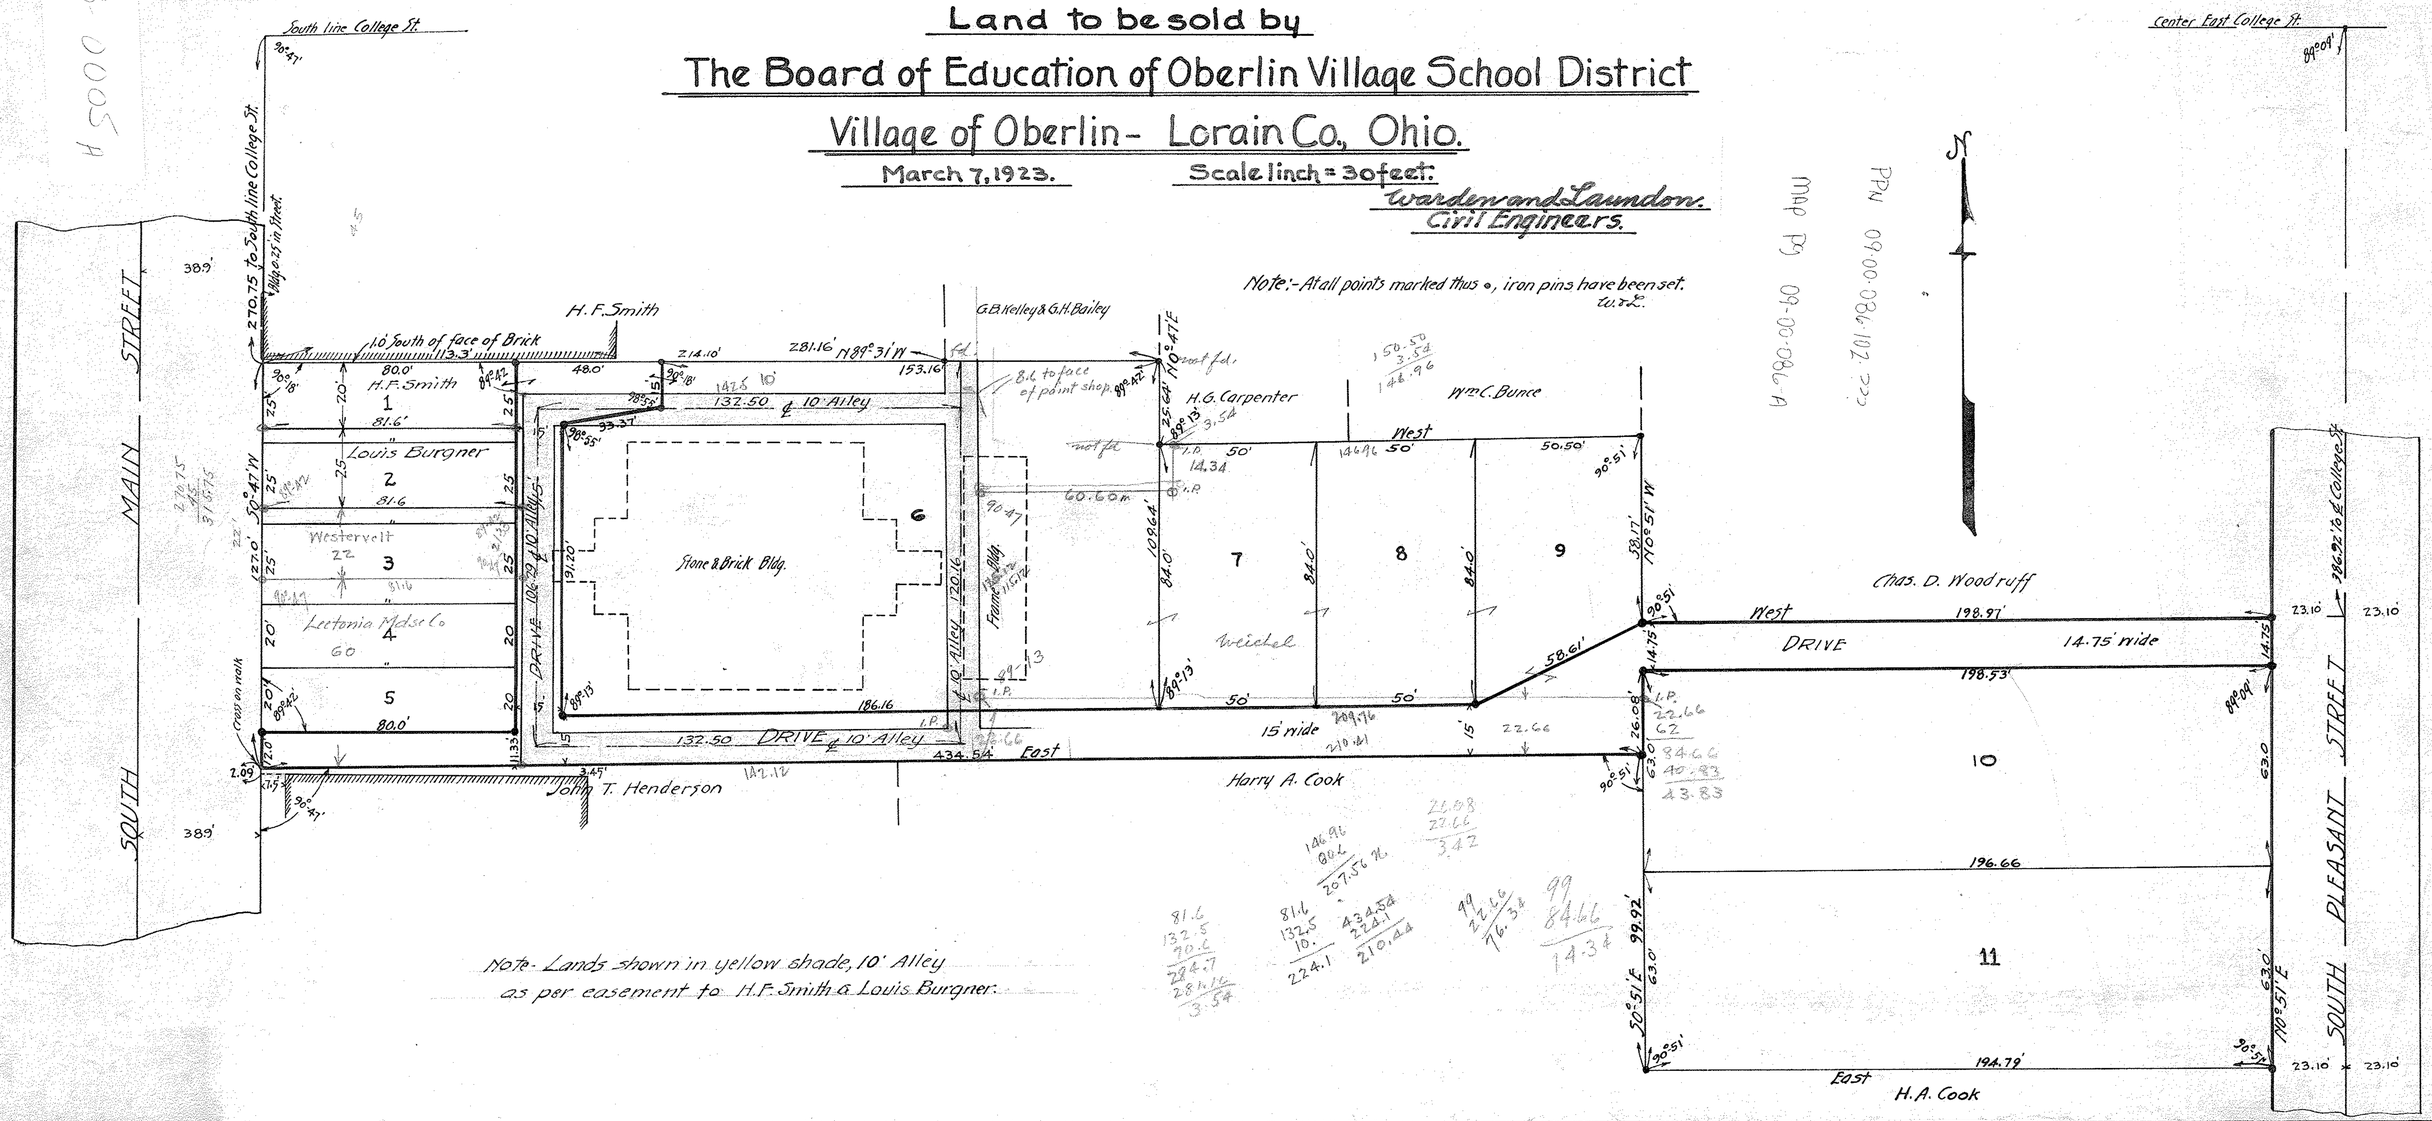

Note- Lands shown in yellow shade, 10' Alley as per easement to H. F. Smith & Louis Burgner.

13 0005 H