13-0174

PLAT OF SURVEY OF
LEAPOLD HOFFMAN PROPERTY

Lots #2 & 3 - Village of Grafton - Lorain Co. Ohio.

Scale 1" = 10ft. April 17, 1913.

T. L. Gibson C.E.

Red line = Occupation line as per Gibson survey 1905.
Green " = As per deed distances used on ground this survey.

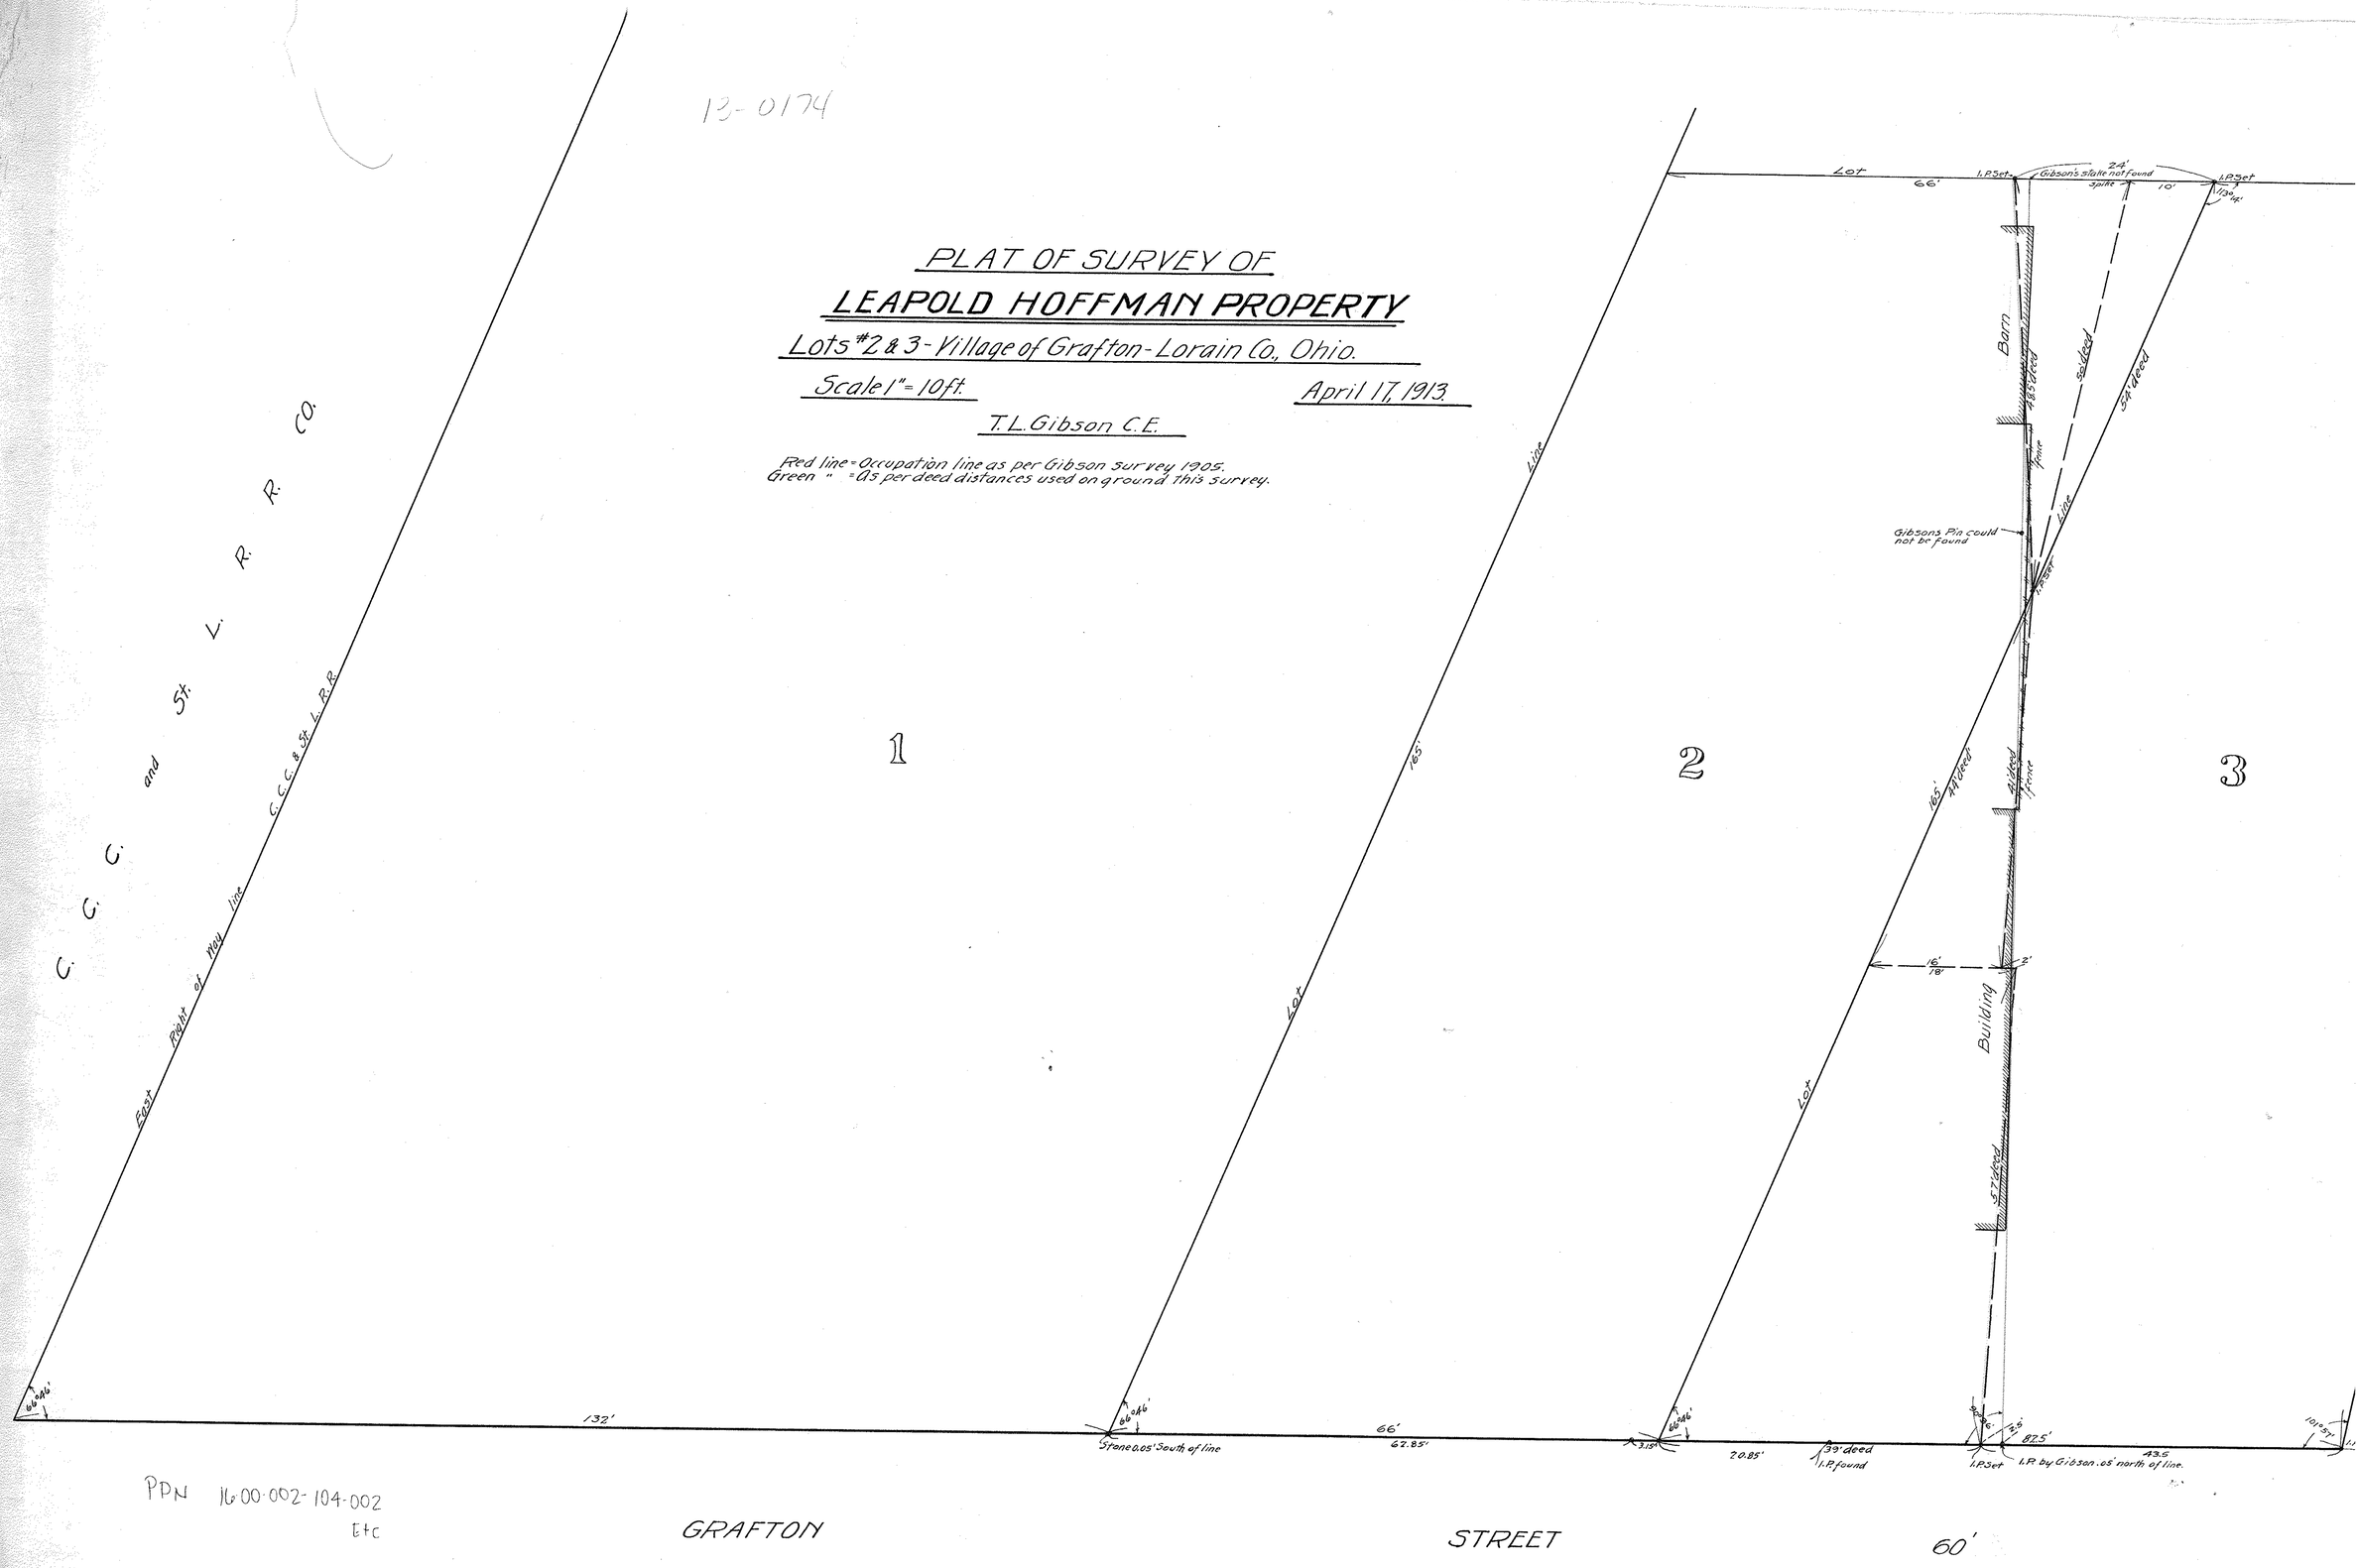

PPN 16-00-002-104-002
Etc

MAP Pg 16-00-001-D

13-1174