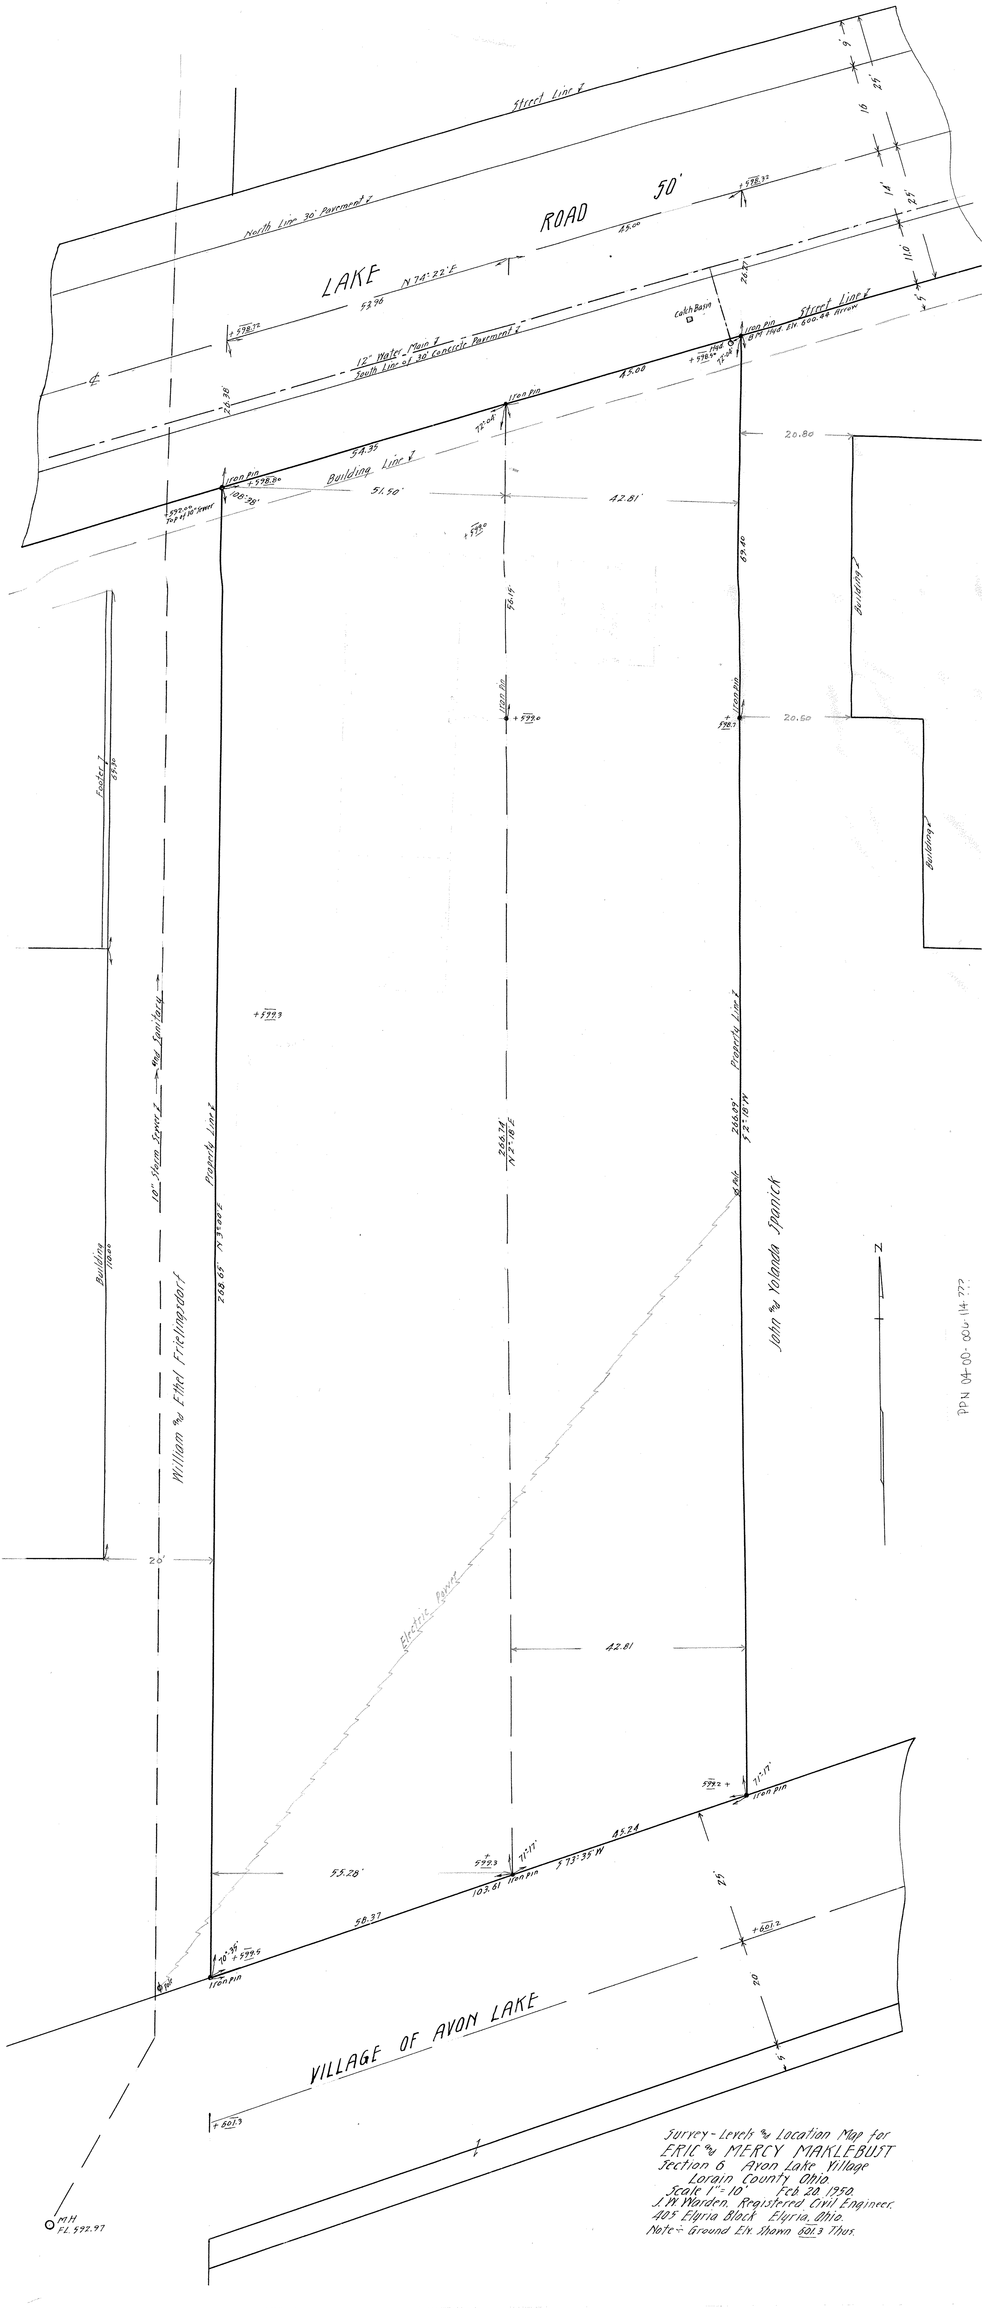

Survey - Levels & Location Map for
ERIC & MERCY MAKLEBUST
Section 6 Avon Lake Village
Lorain County Ohio
Scale 1" = 10' Feb 20 1950
J. W. Warden, Registered Civil Engineer,
405 Elyria Block Elyria Ohio.
