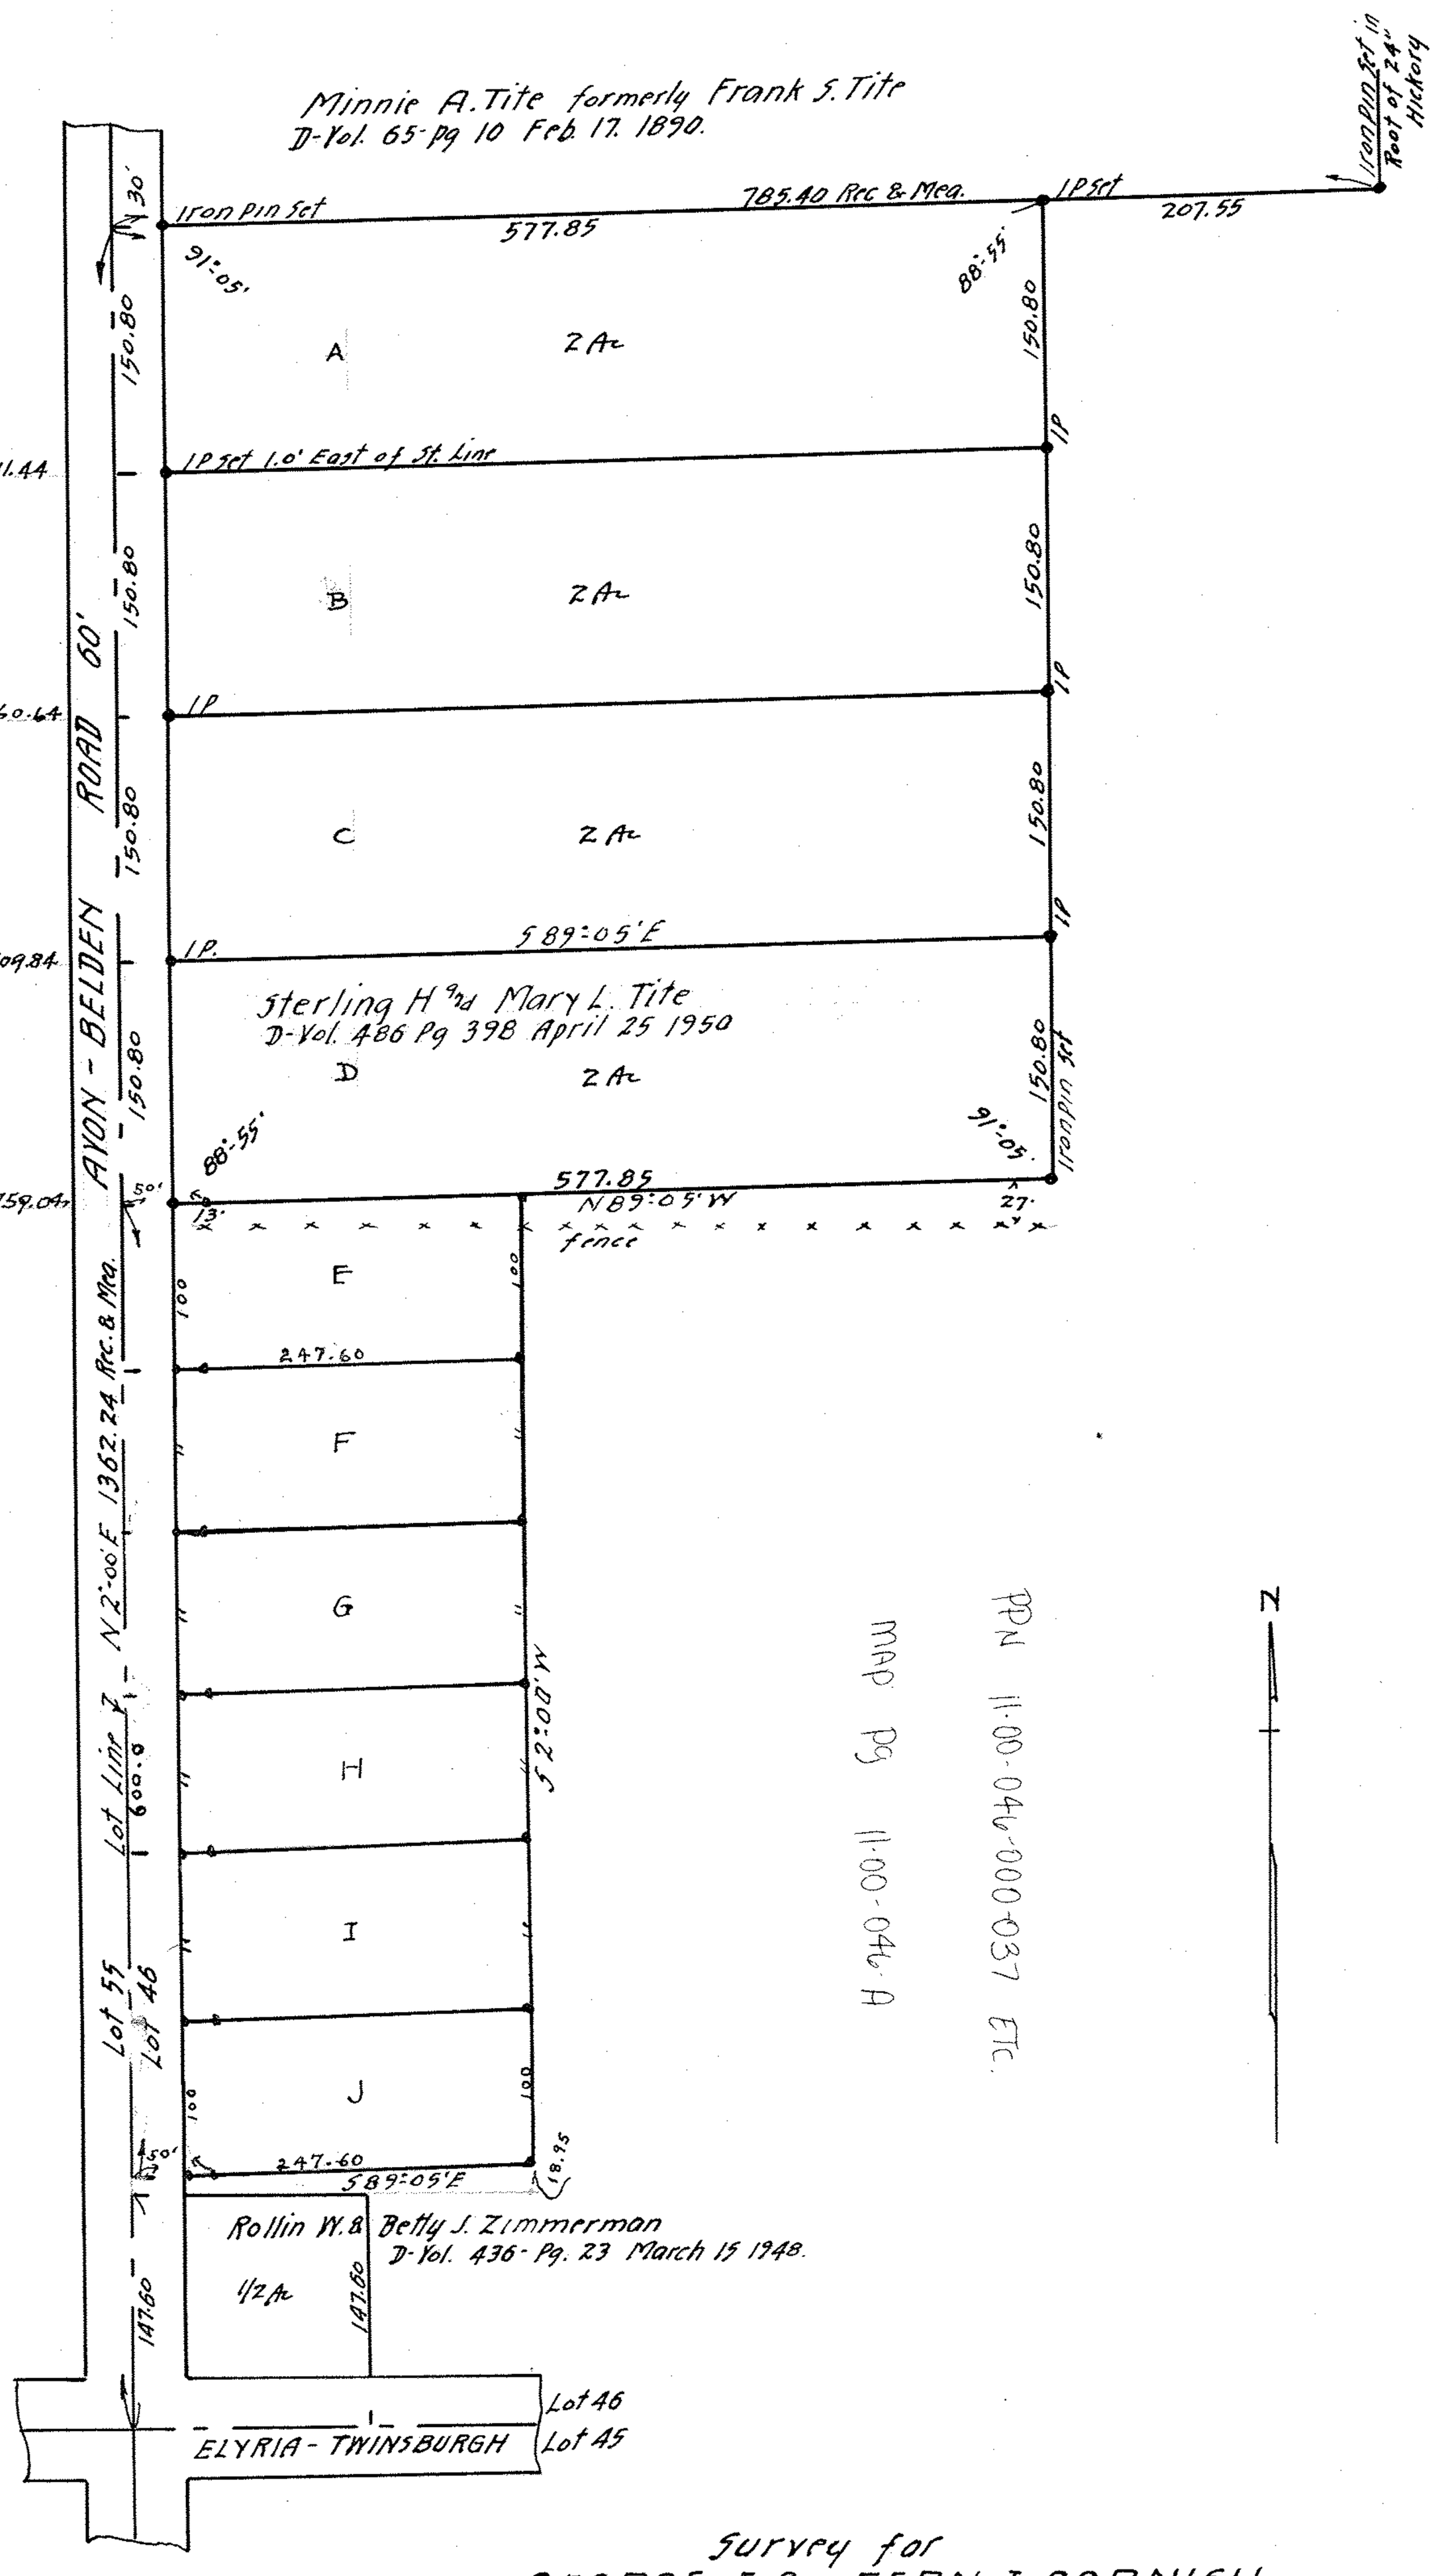

Survey for
GEORGE E. and FERN I. CORNISH
D-Vol. 343-Pg 158 March 16. 1945.
Lot 46 Eaton Township
Lorain County Ohio.
Scale 1" = 100' June 23, 1948.
J. W. Warden. Registered Surveyor.

13-1018 A