PPN 09-00-076-102-001 Etc

MAP 79 09-00-076-A

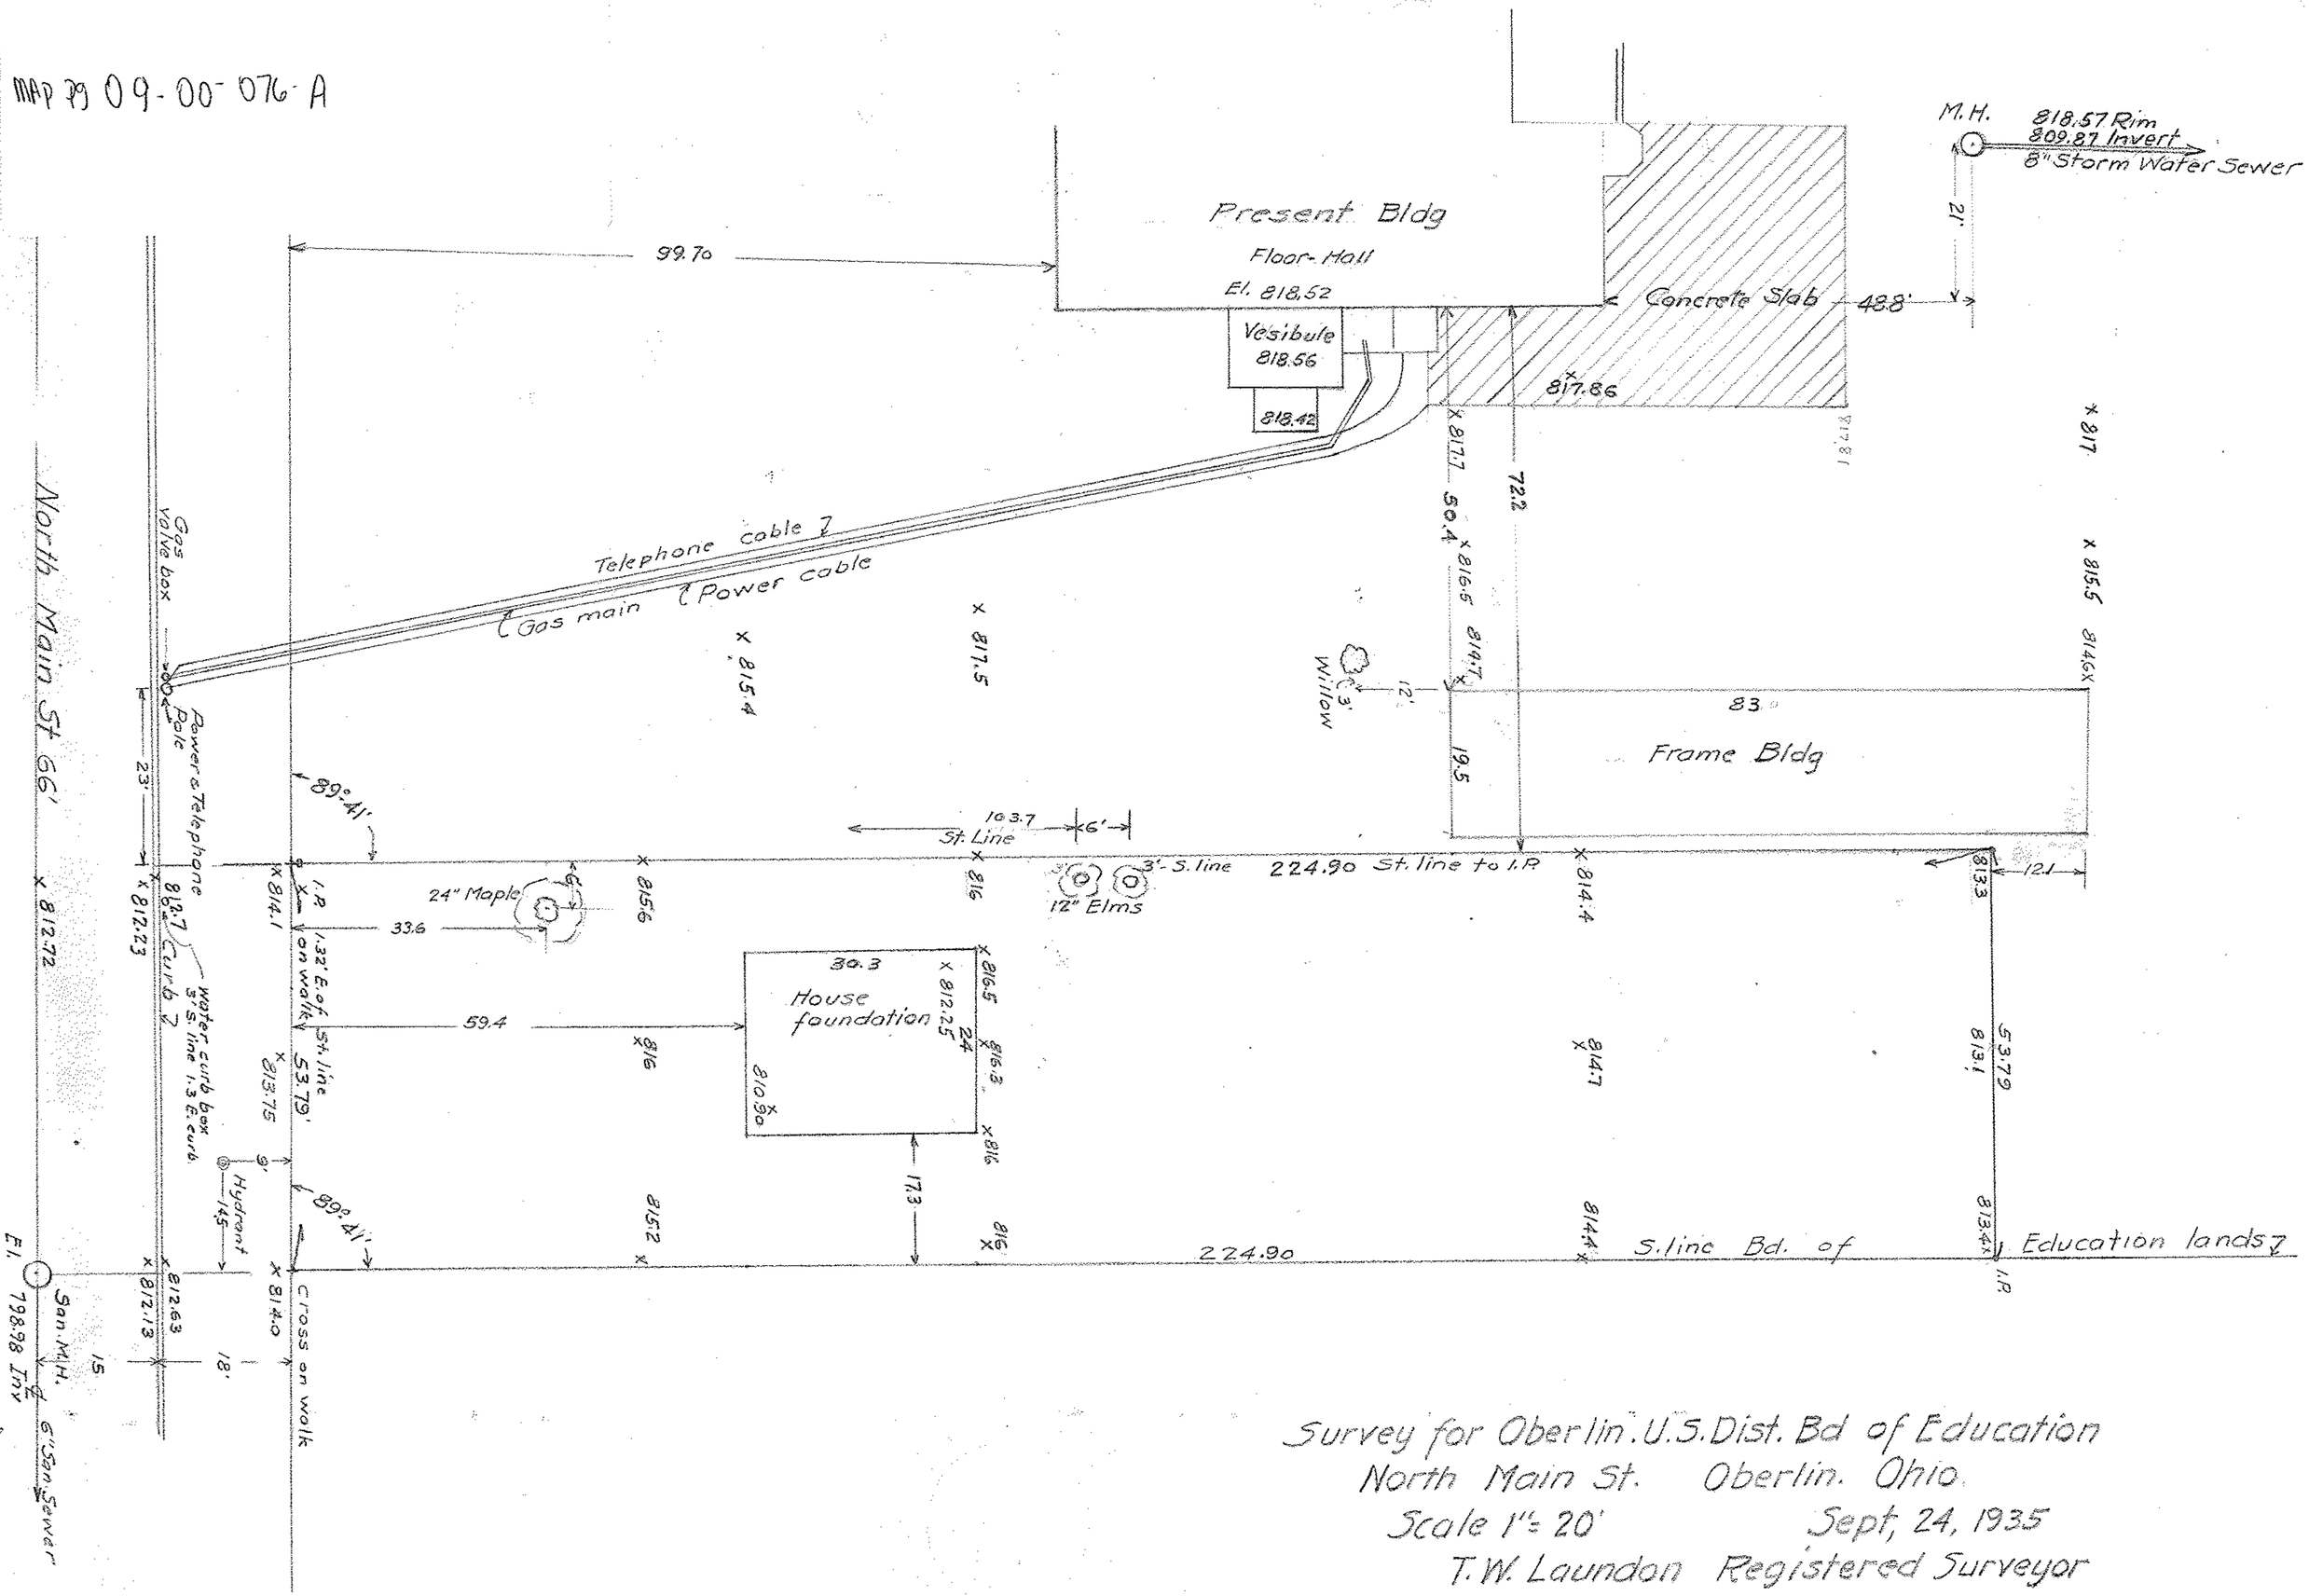

Survey for Oberlin. U.S. Dist. Bd of Education
North Main St. Oberlin. Ohio.
Scale 1"= 20' Sept, 24, 1935
T.W. Laundon Registered Surveyor