


Walter & Nancy Green
June 9-1947-Deed Vol-416-Pg-537

Walter & Nancy Green
June 9-1947-Deed Vol-416-Pg-537

Alexandra Gregorzik
Dec. 11-1947-Deed Vol-479-Pg-191
0.572 Acres

Wm. H. & Leona I. Cooley, incorrect
Jan. 29-1944-Deed Vol-333-Pg-124

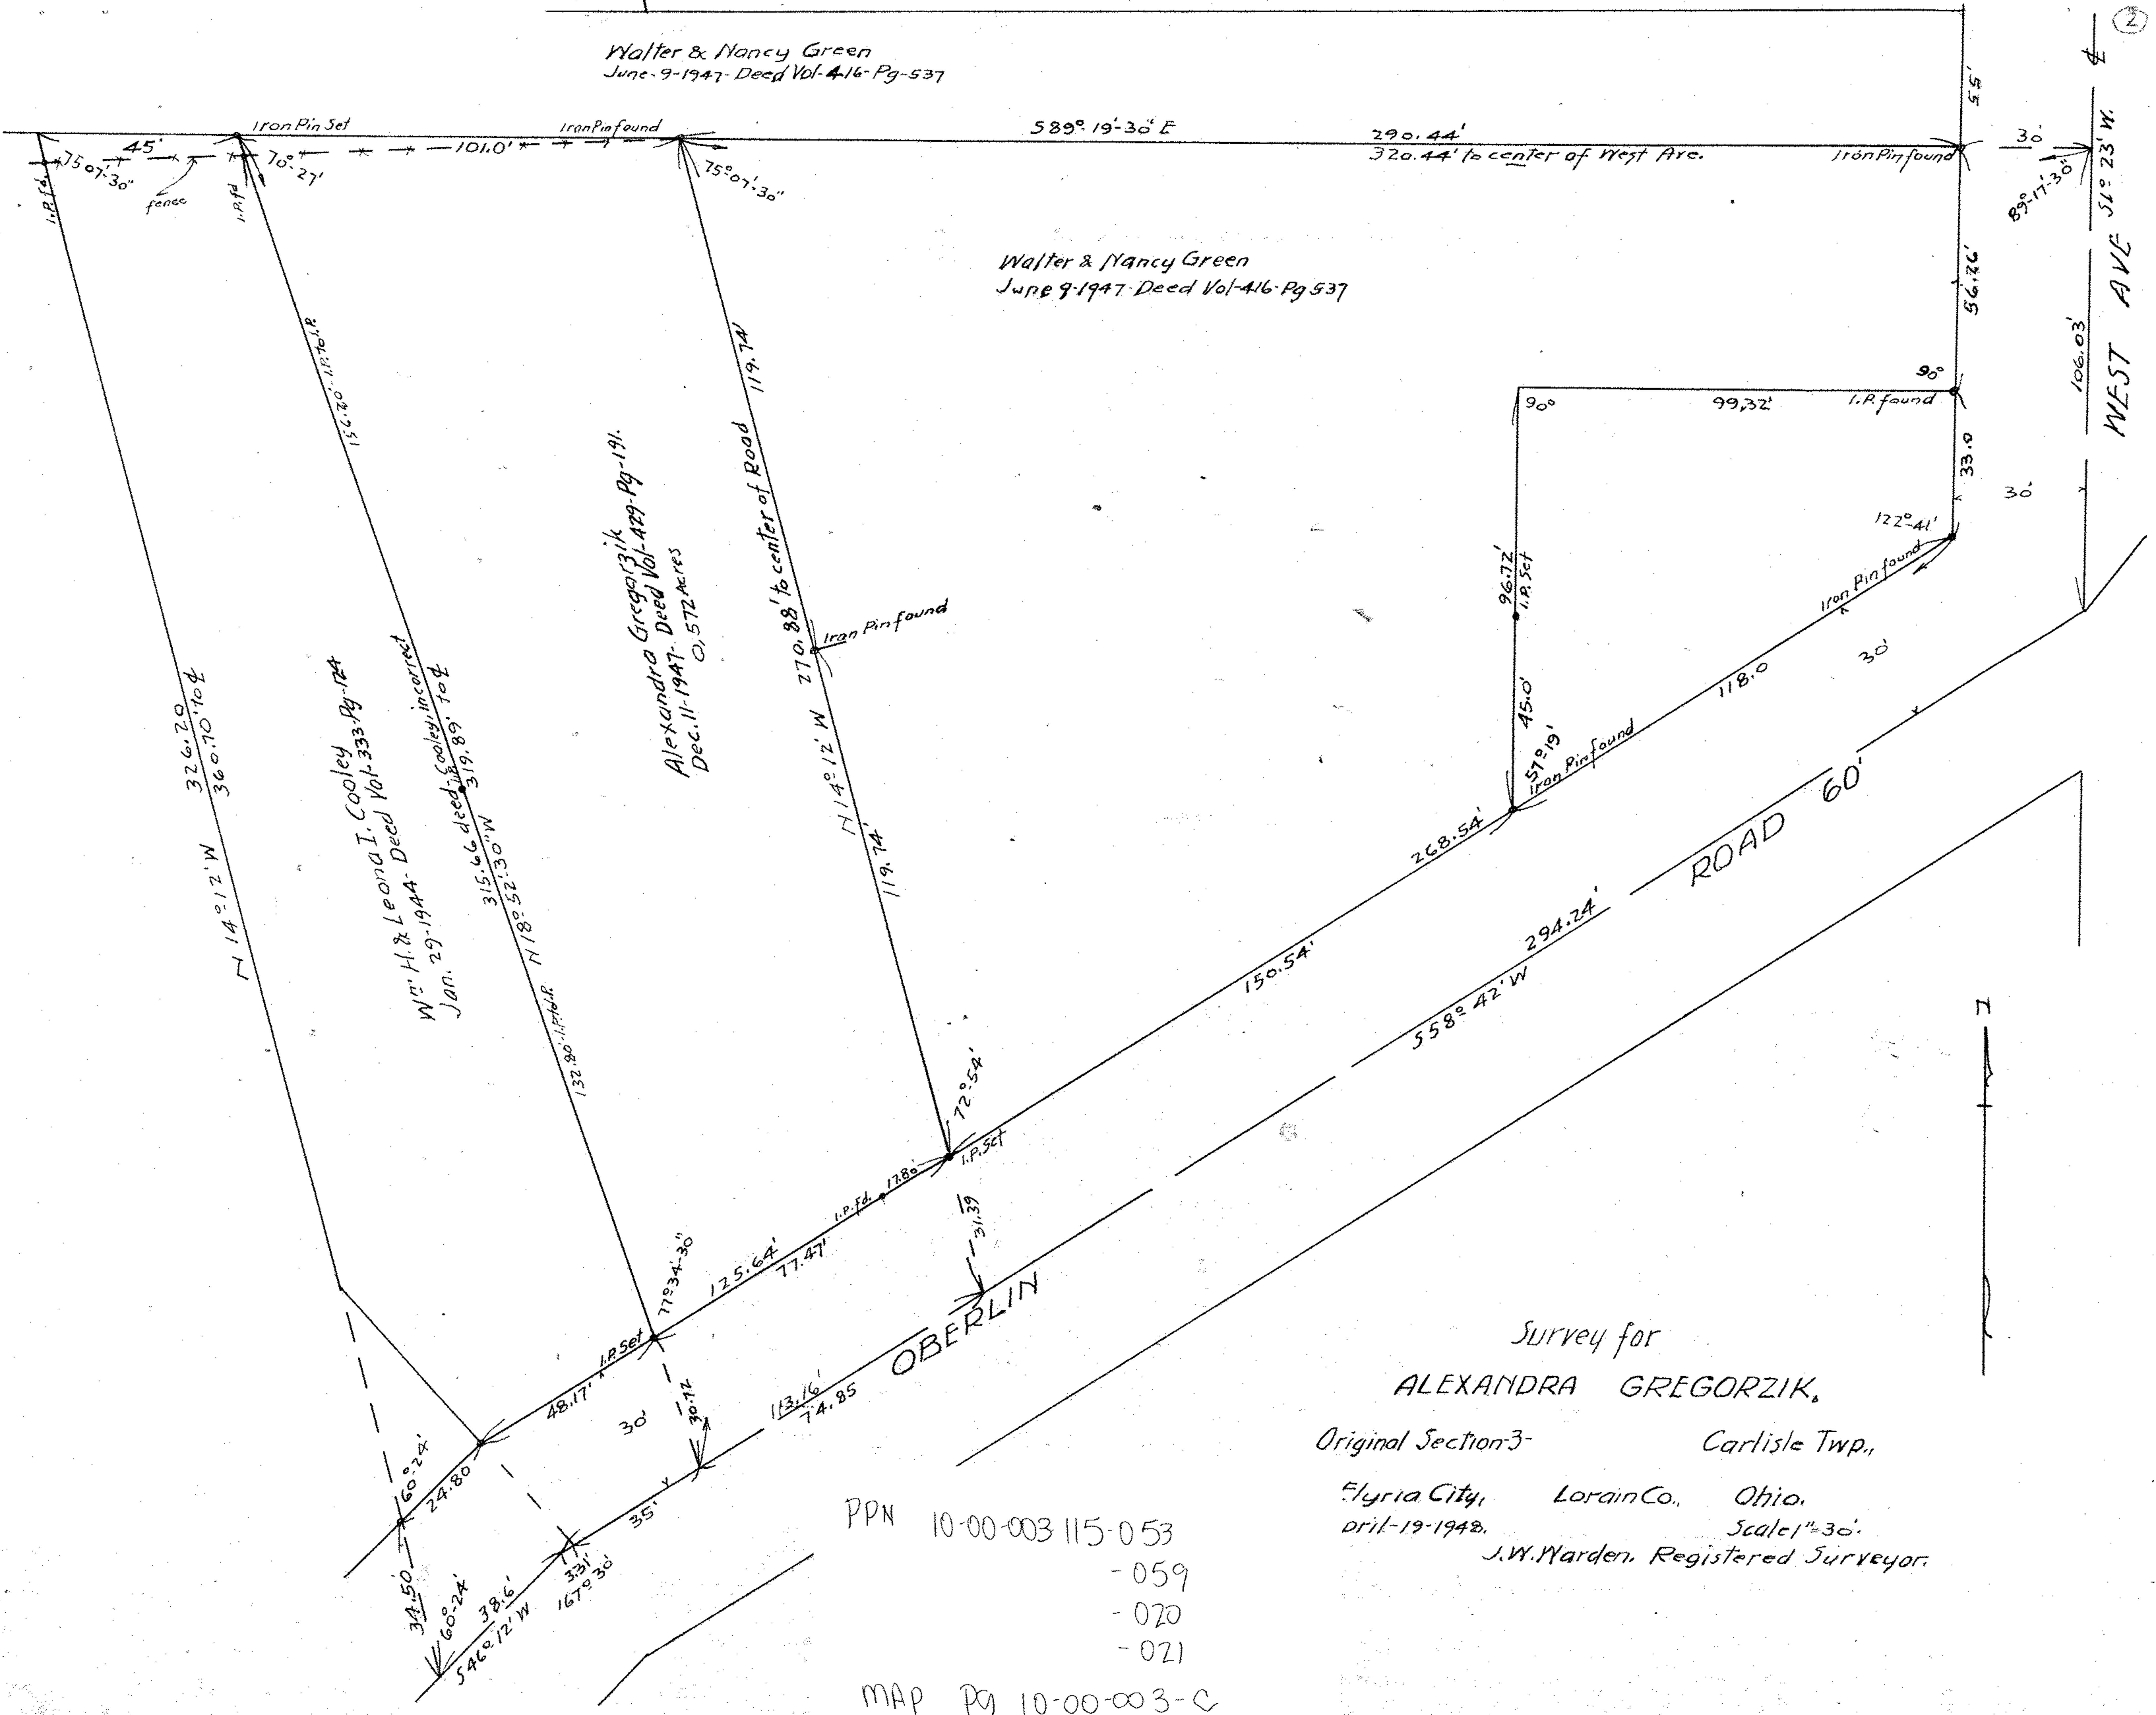

Survey for
ALEXANDRA GREGORZIK,
 Original Section-3- Carlisle Twp.,
 Elyria City, Lorain Co., Ohio,
 April-19-1948. Scale 1"=30'.
 J.W. Warden, Registered Surveyor.

PPN 10-00-003 115-053
 -059
 -070
 -021
 MAP Pg 10-00-003-C