


Florence Dorow
D- Vol. 337 Pg. 130 March 21, 1944.

Flora Blackmer
D- Vol. 458 Pg. 228 Oct. 7 1942

Harold E. Cook
D- Vol. 458 Pg. 228 Oct. 7 1942.

Oberlin Village ^{no} Russia Township
D- Vol. 141 Pg. 625 Dec. 30, 1916.

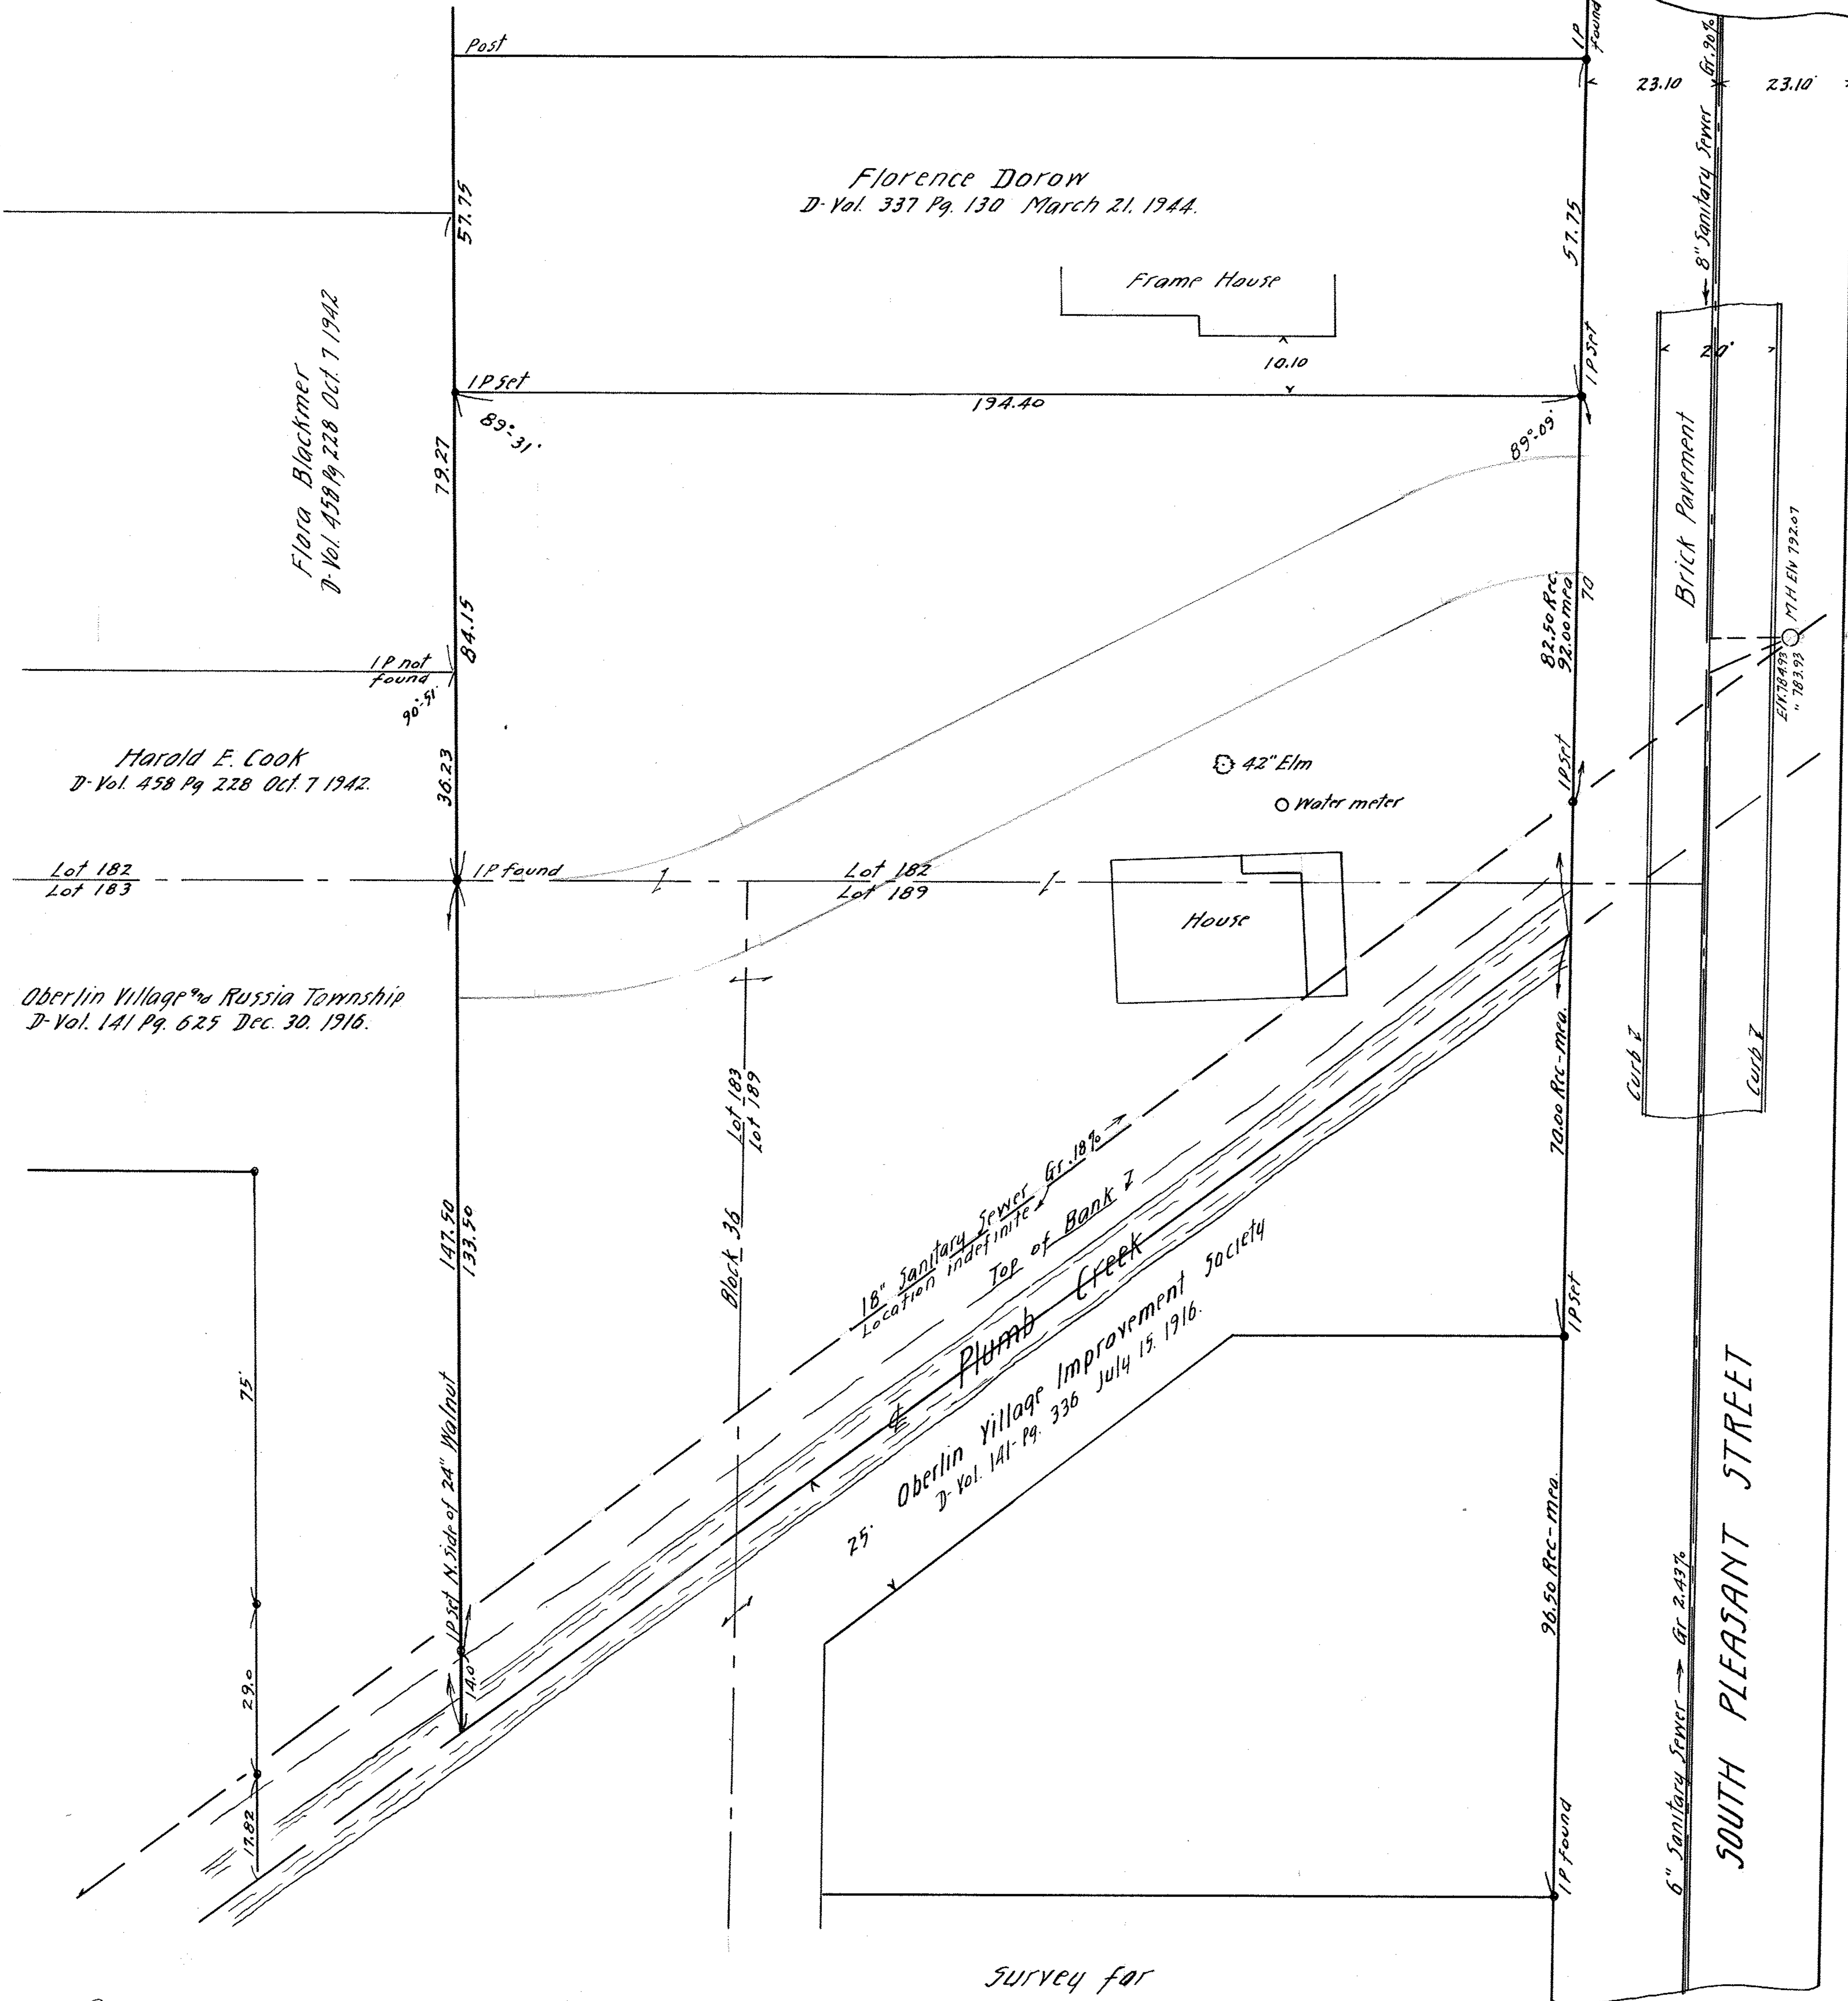

PPN 09-00-086-102 ???

MAP Pg 9-00-086 A

Survey for
C. A. ^{no} HARRIET C. BARDEN
D- Vol. 483- Pg. 95-97 Feb. 18, 1950.
Lots 182-183-189 Village Plat.
Oberlin Village Lorain County Ohio.
Scale 1" = 20' March 27 1950.
J. W. Warden, Registered Surveyor.
Note: Sewer information from Village Records.