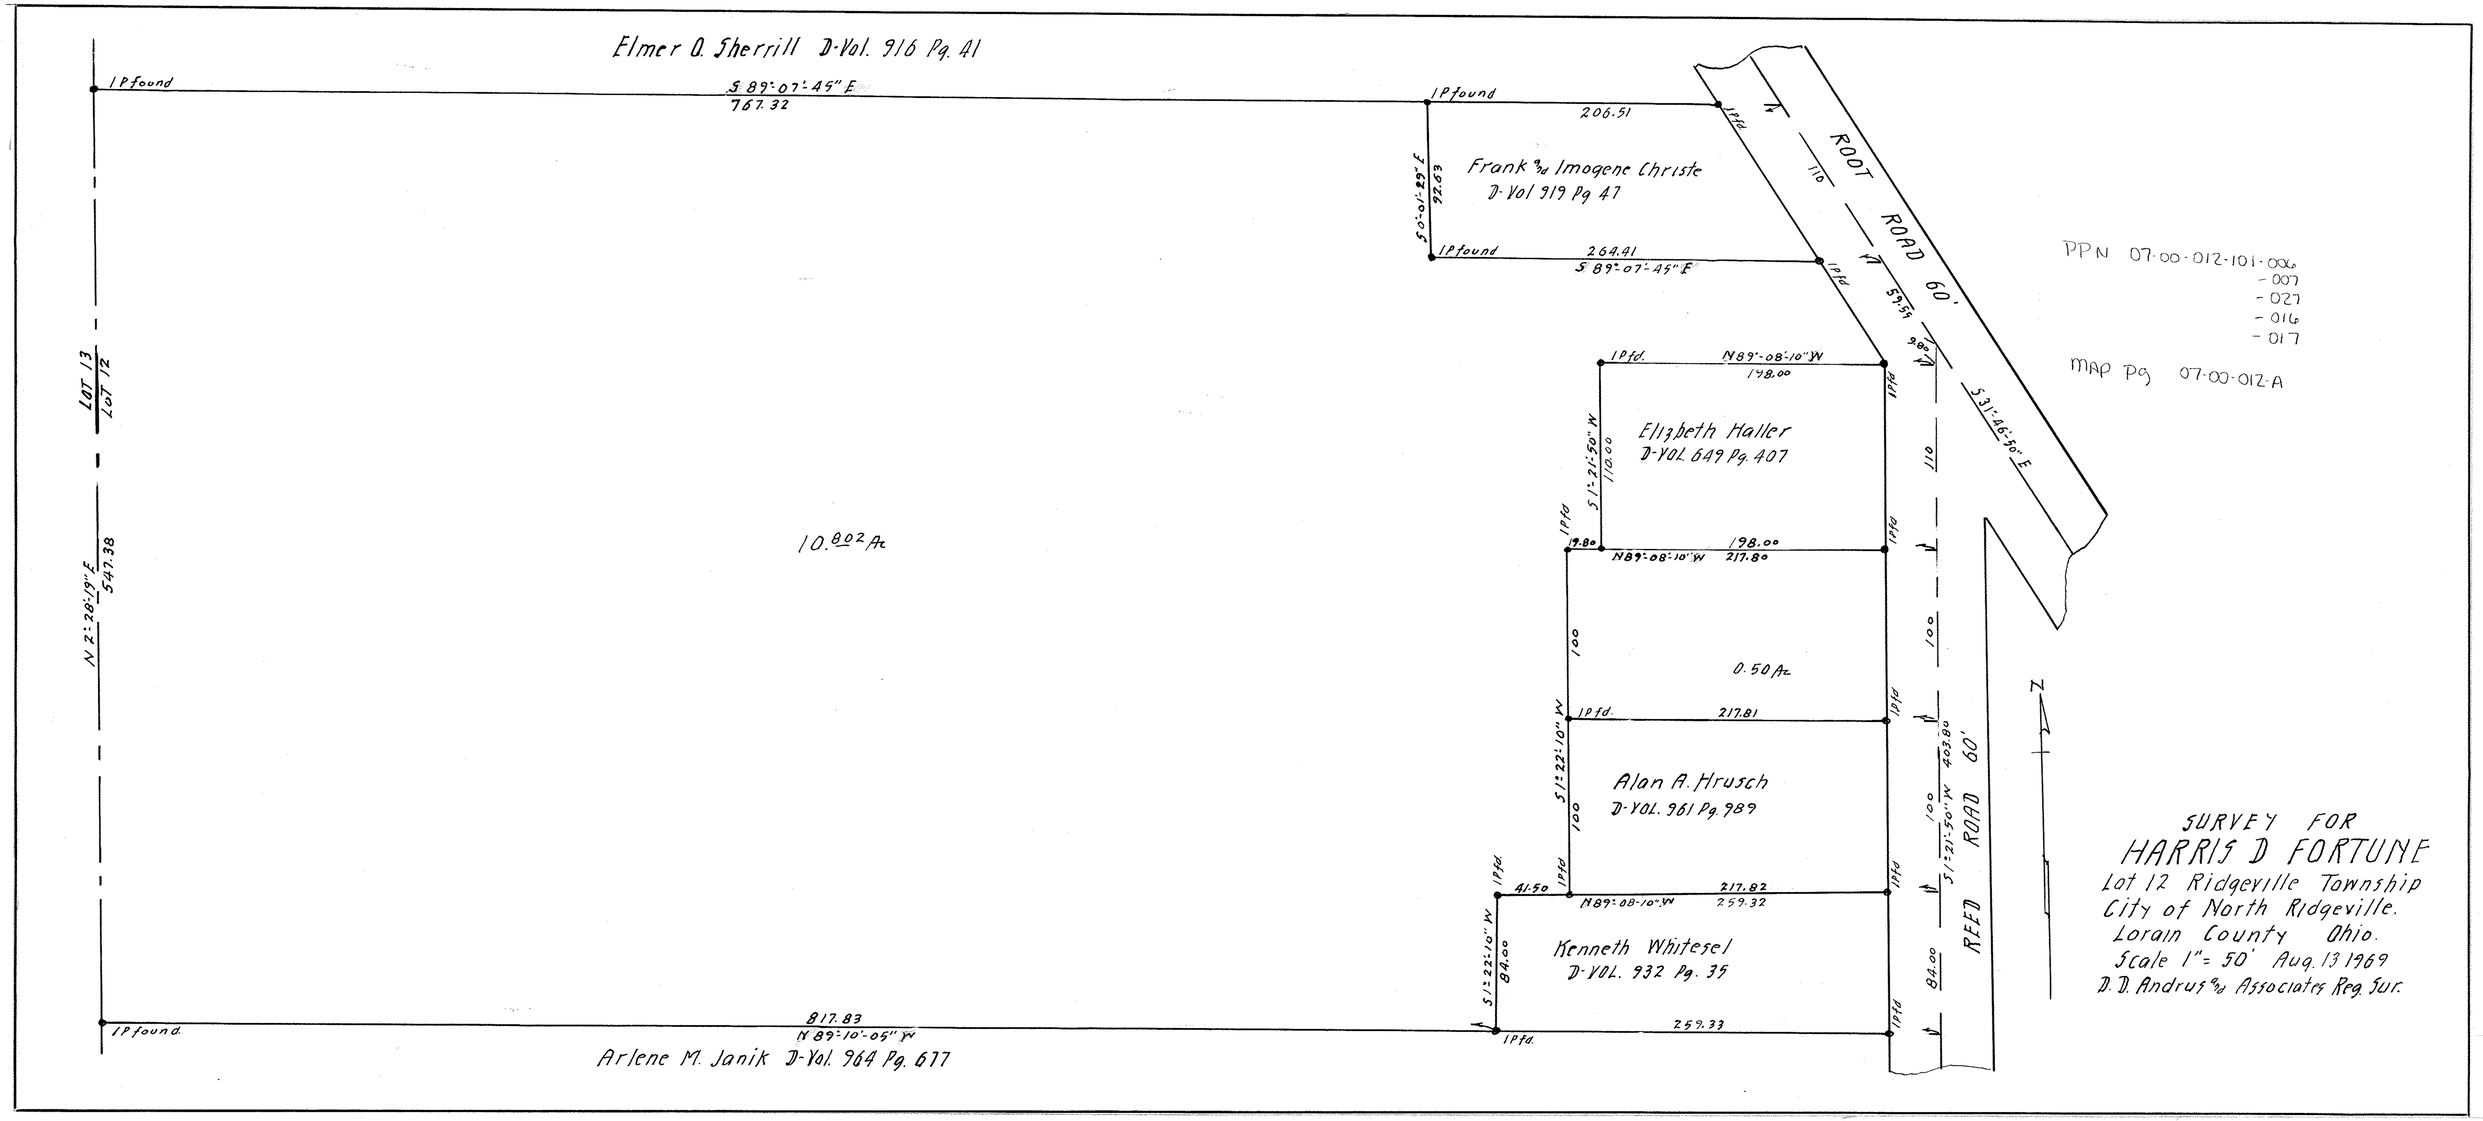
Elmer O. Sherrill D-Vol. 916 Pg. 41
1P found
S 89°-07'-45" E
767.32
1P found
206.51
Frank & Imogene Christe
D-Vol 919 Pg 47
S 0°-01'-29" E
92.03
1P found
264.41
S 89°-07'-45" E
ROOT ROAD 60'
110
59.59
9.80
S 31°-46'-50" E
PPN 07-00-012-101-000
-007
-027
-016
-017
MAP Pg 07-00-012-A
LOT 13
LOT 12
N 2°-28'-19" E
547.38
10.802 Ac
1Pfd.
N 89°-08'-10" W
198.00
Elizbeth Haller
D-VOL 649 Pg. 407
S 1°-21'-50" W
110.00
19.80
198.00
N 89°-08'-10" W
217.80
100
0.50 Ac
1Pfd.
217.81
S 1°-22'-10" W
Alan A. Hrusch
D-VOL. 961 Pg. 989
403.80
S 1°-21'-50" W
41.50
217.82
N 89°-08'-10" W
259.32
Kenneth Whitesel
D-VOL. 932 Pg. 35
S 1°-22'-10" W
84.00
REED ROAD 60'
1P found.
817.83
N 89°-10'-05" W
259.33
Arlene M. Janik D-Vol. 964 Pg. 677
SURVEY FOR
HARRIS D FORTUNE
Lot 12 Ridgeville Township
City of North Ridgeville.
Lorain County Ohio.
Scale 1" = 50' Aug. 13 1969
D. D. Andrus & Associates Reg. Sur.