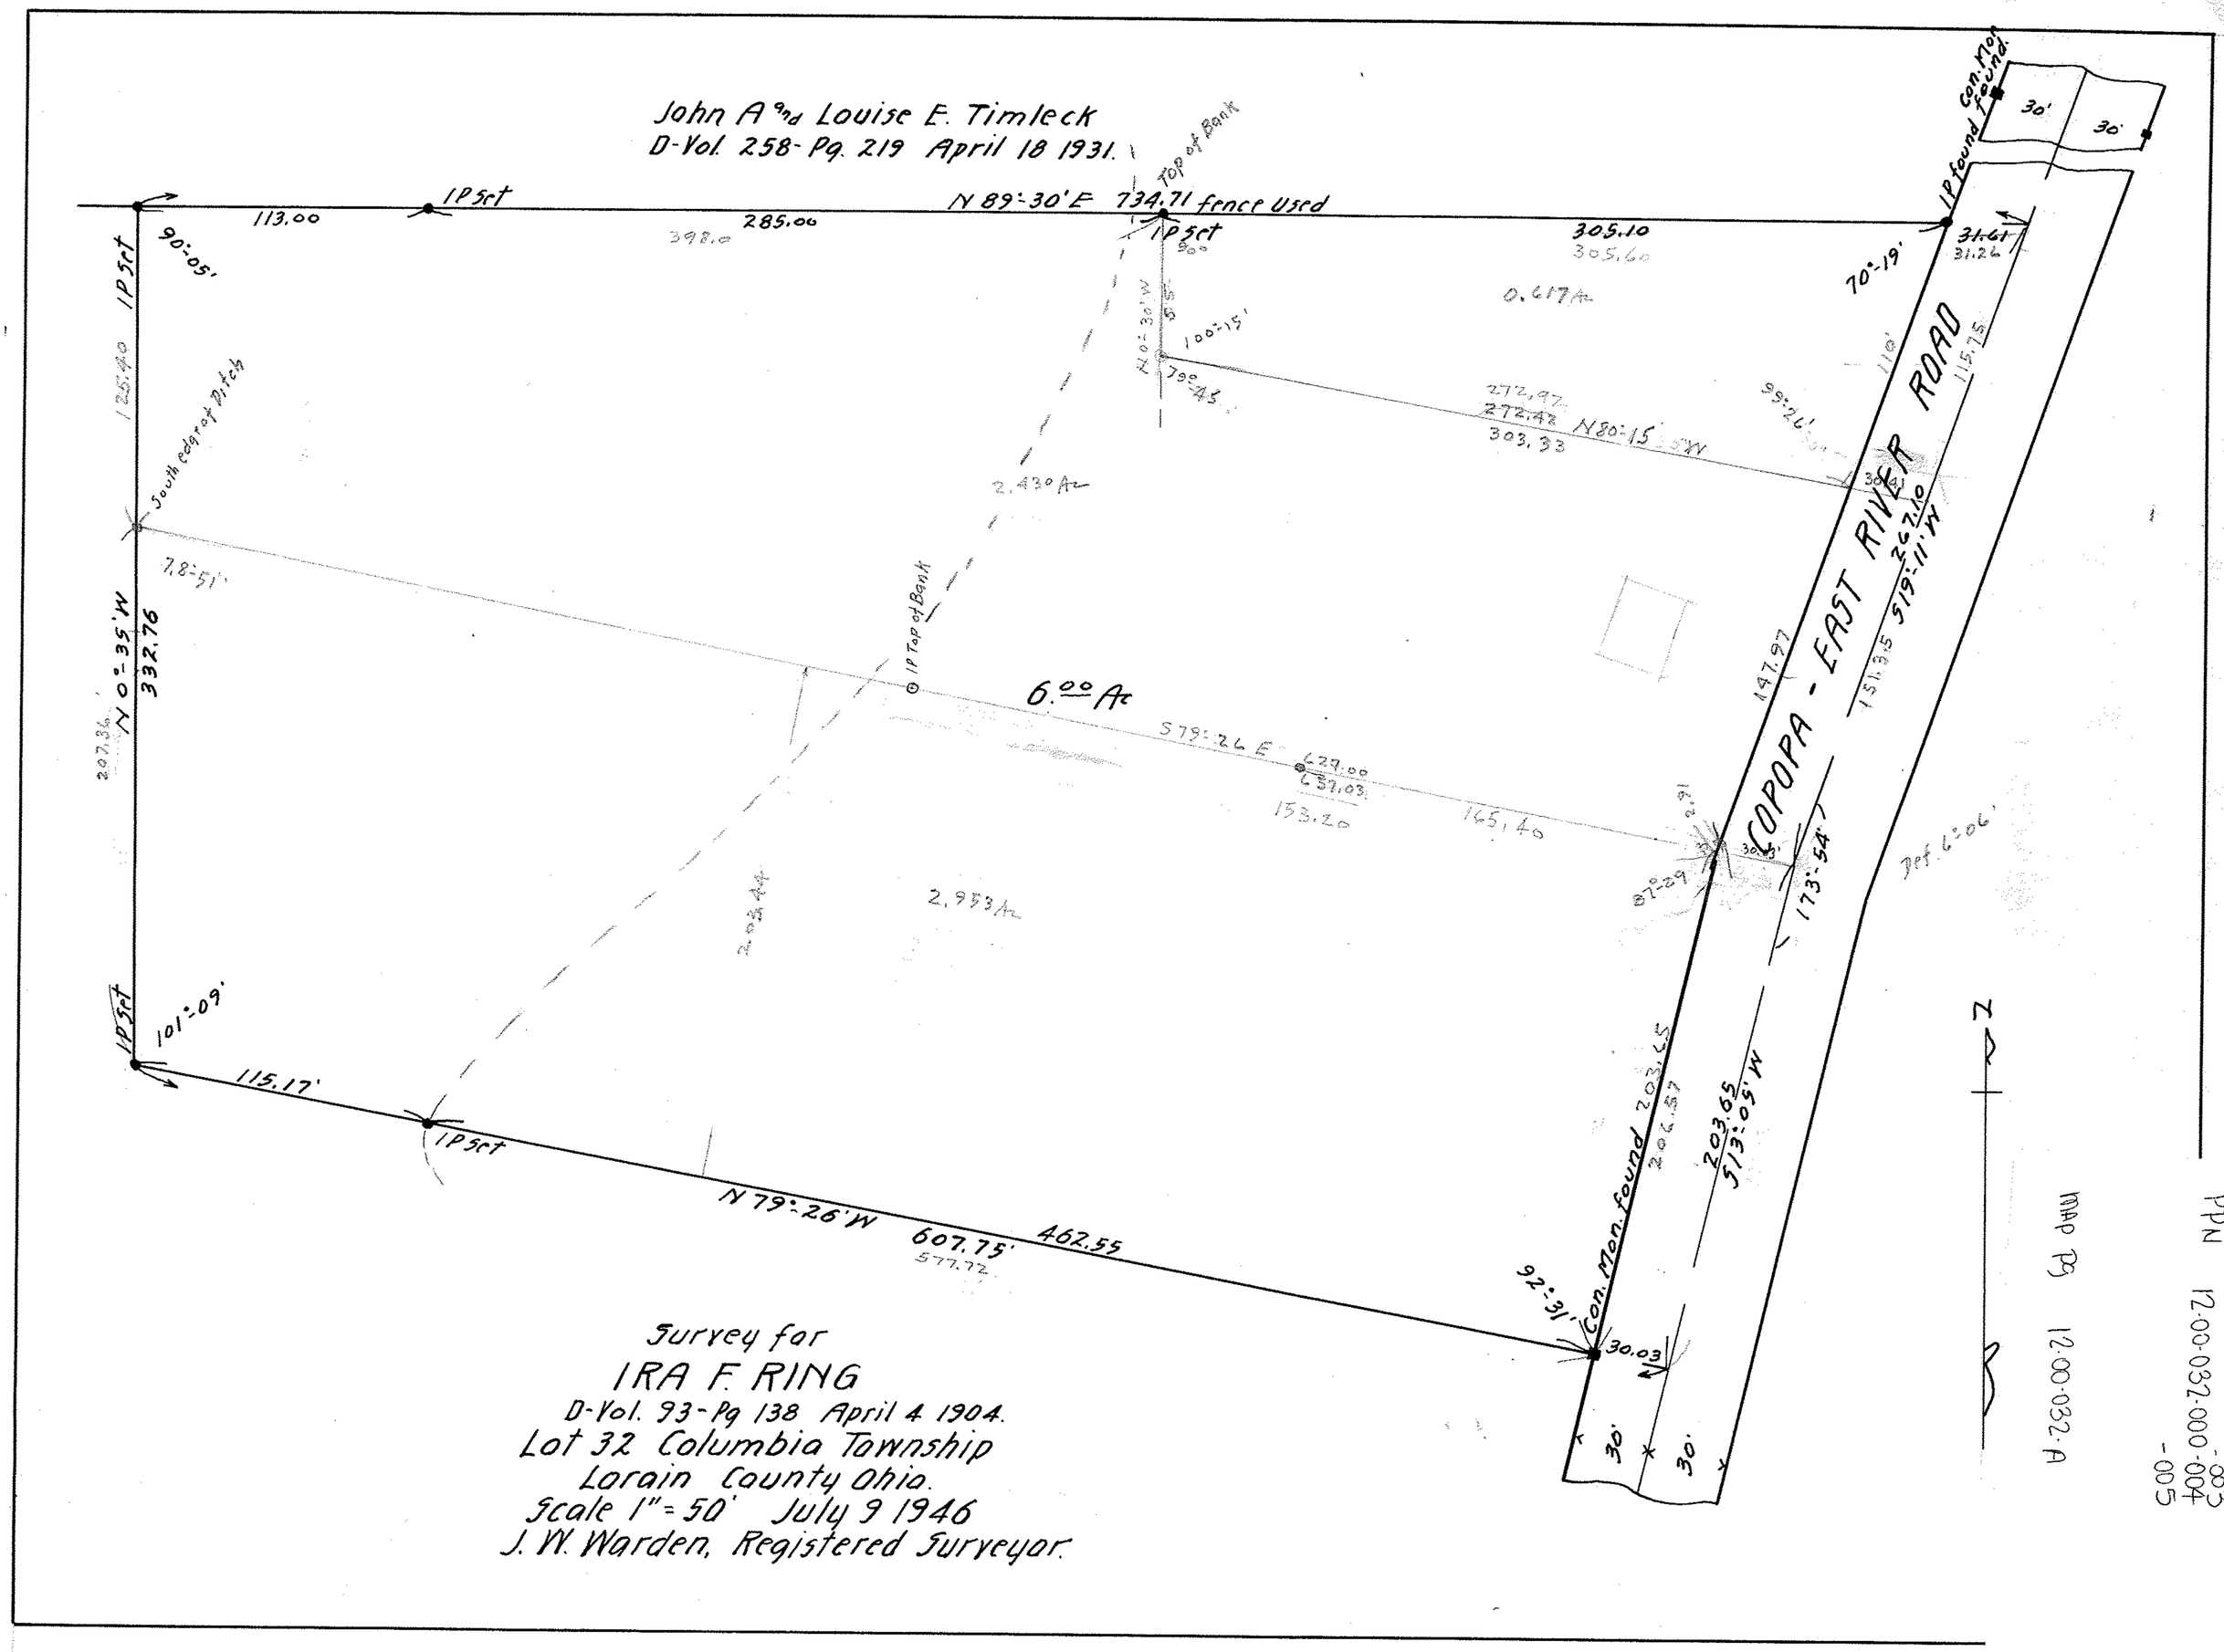
John A and Louise E. Timleck
D-Vol. 258-Pg. 219 April 18 1931.
N 89°-30' E 734.71 fence Used
113.00
285.00
398.0
305.10
305.60
1P Set
90°-05'
125.40
South edge of Ditch
7.8°-51'
N 0°-35' W
332.76
207.36
101°-09'
115.17'
N 79°-26' W
607.75'
577.72
462.55
92°-31'
30.03
Top of Bank
1P Top of Bank
2.430 Ac
6.00 Ac
S 79°-26 E
627.00
637.03
153.20
165.40
2.953 Ac
203.44
0.617 Ac
100°-15'
79°-45'
272.97
272.42
303.33
N 80°-15' W
99°-26'
70°-19'
31.61
31.26
110'
115.75
30'
30'
Con. Mon. found
1P found
COPOPA - EAST RIVER ROAD
267.10
S 19°-11' W
151.35
147.97
173°-54'
87°-29'
Def. 6°-06'
203.65
S 13°-05' W
203.65
206.57
Con. Mon. found
30'
30'
N
Survey for
IRA F. RING
D-Vol. 93-Pg 138 April 4 1904.
Lot 32 Columbia Township
Lorain County Ohio.
Scale 1" = 50' July 9 1946
J. W. Warden, Registered Surveyor.
MAP Pg 12-00-032-A
PPN 12-00-032-000-003
-004
-005