


PPN 04-00-007-104-722

MAP P9 04-00-007-B

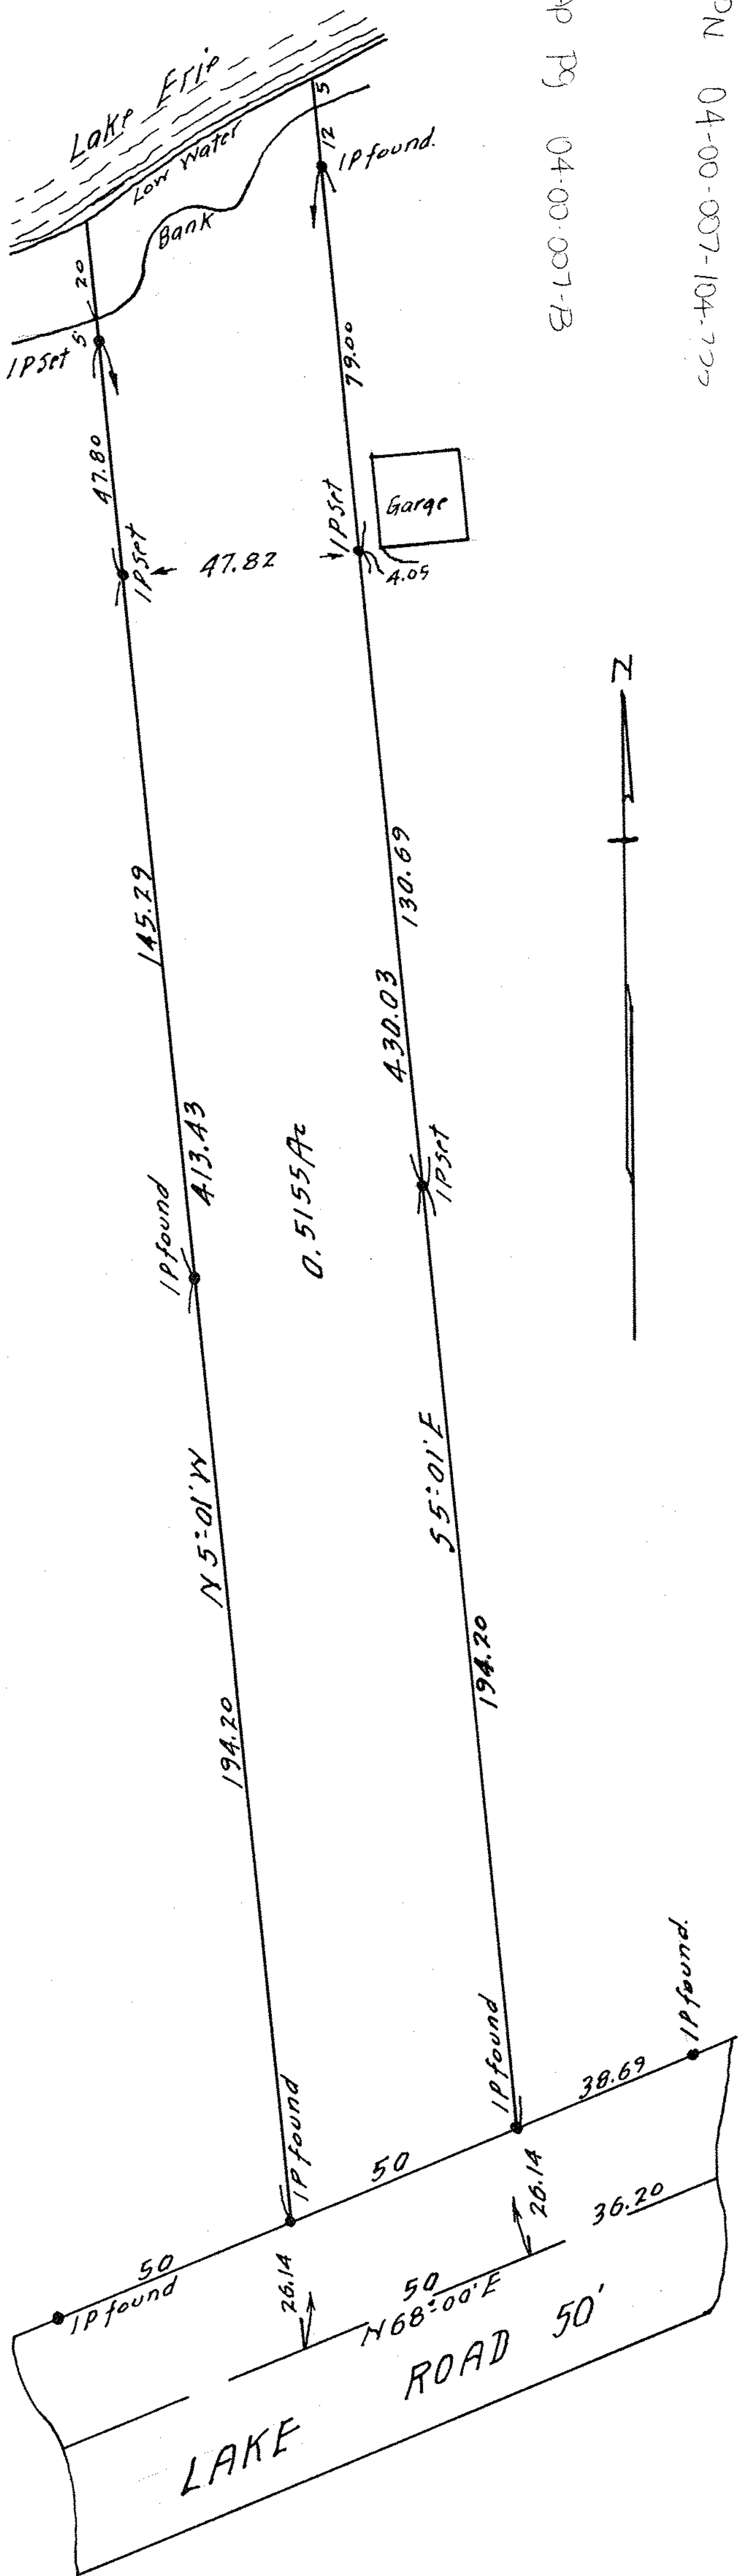

SURVEY FOR  
 MARY E. LANGE  
 Section 7 Avon Lake Village  
 Lorain County Ohio.  
 Scale 1" = 30' June 20 1952  
 J.W. Warden & Associates Surveyor's.