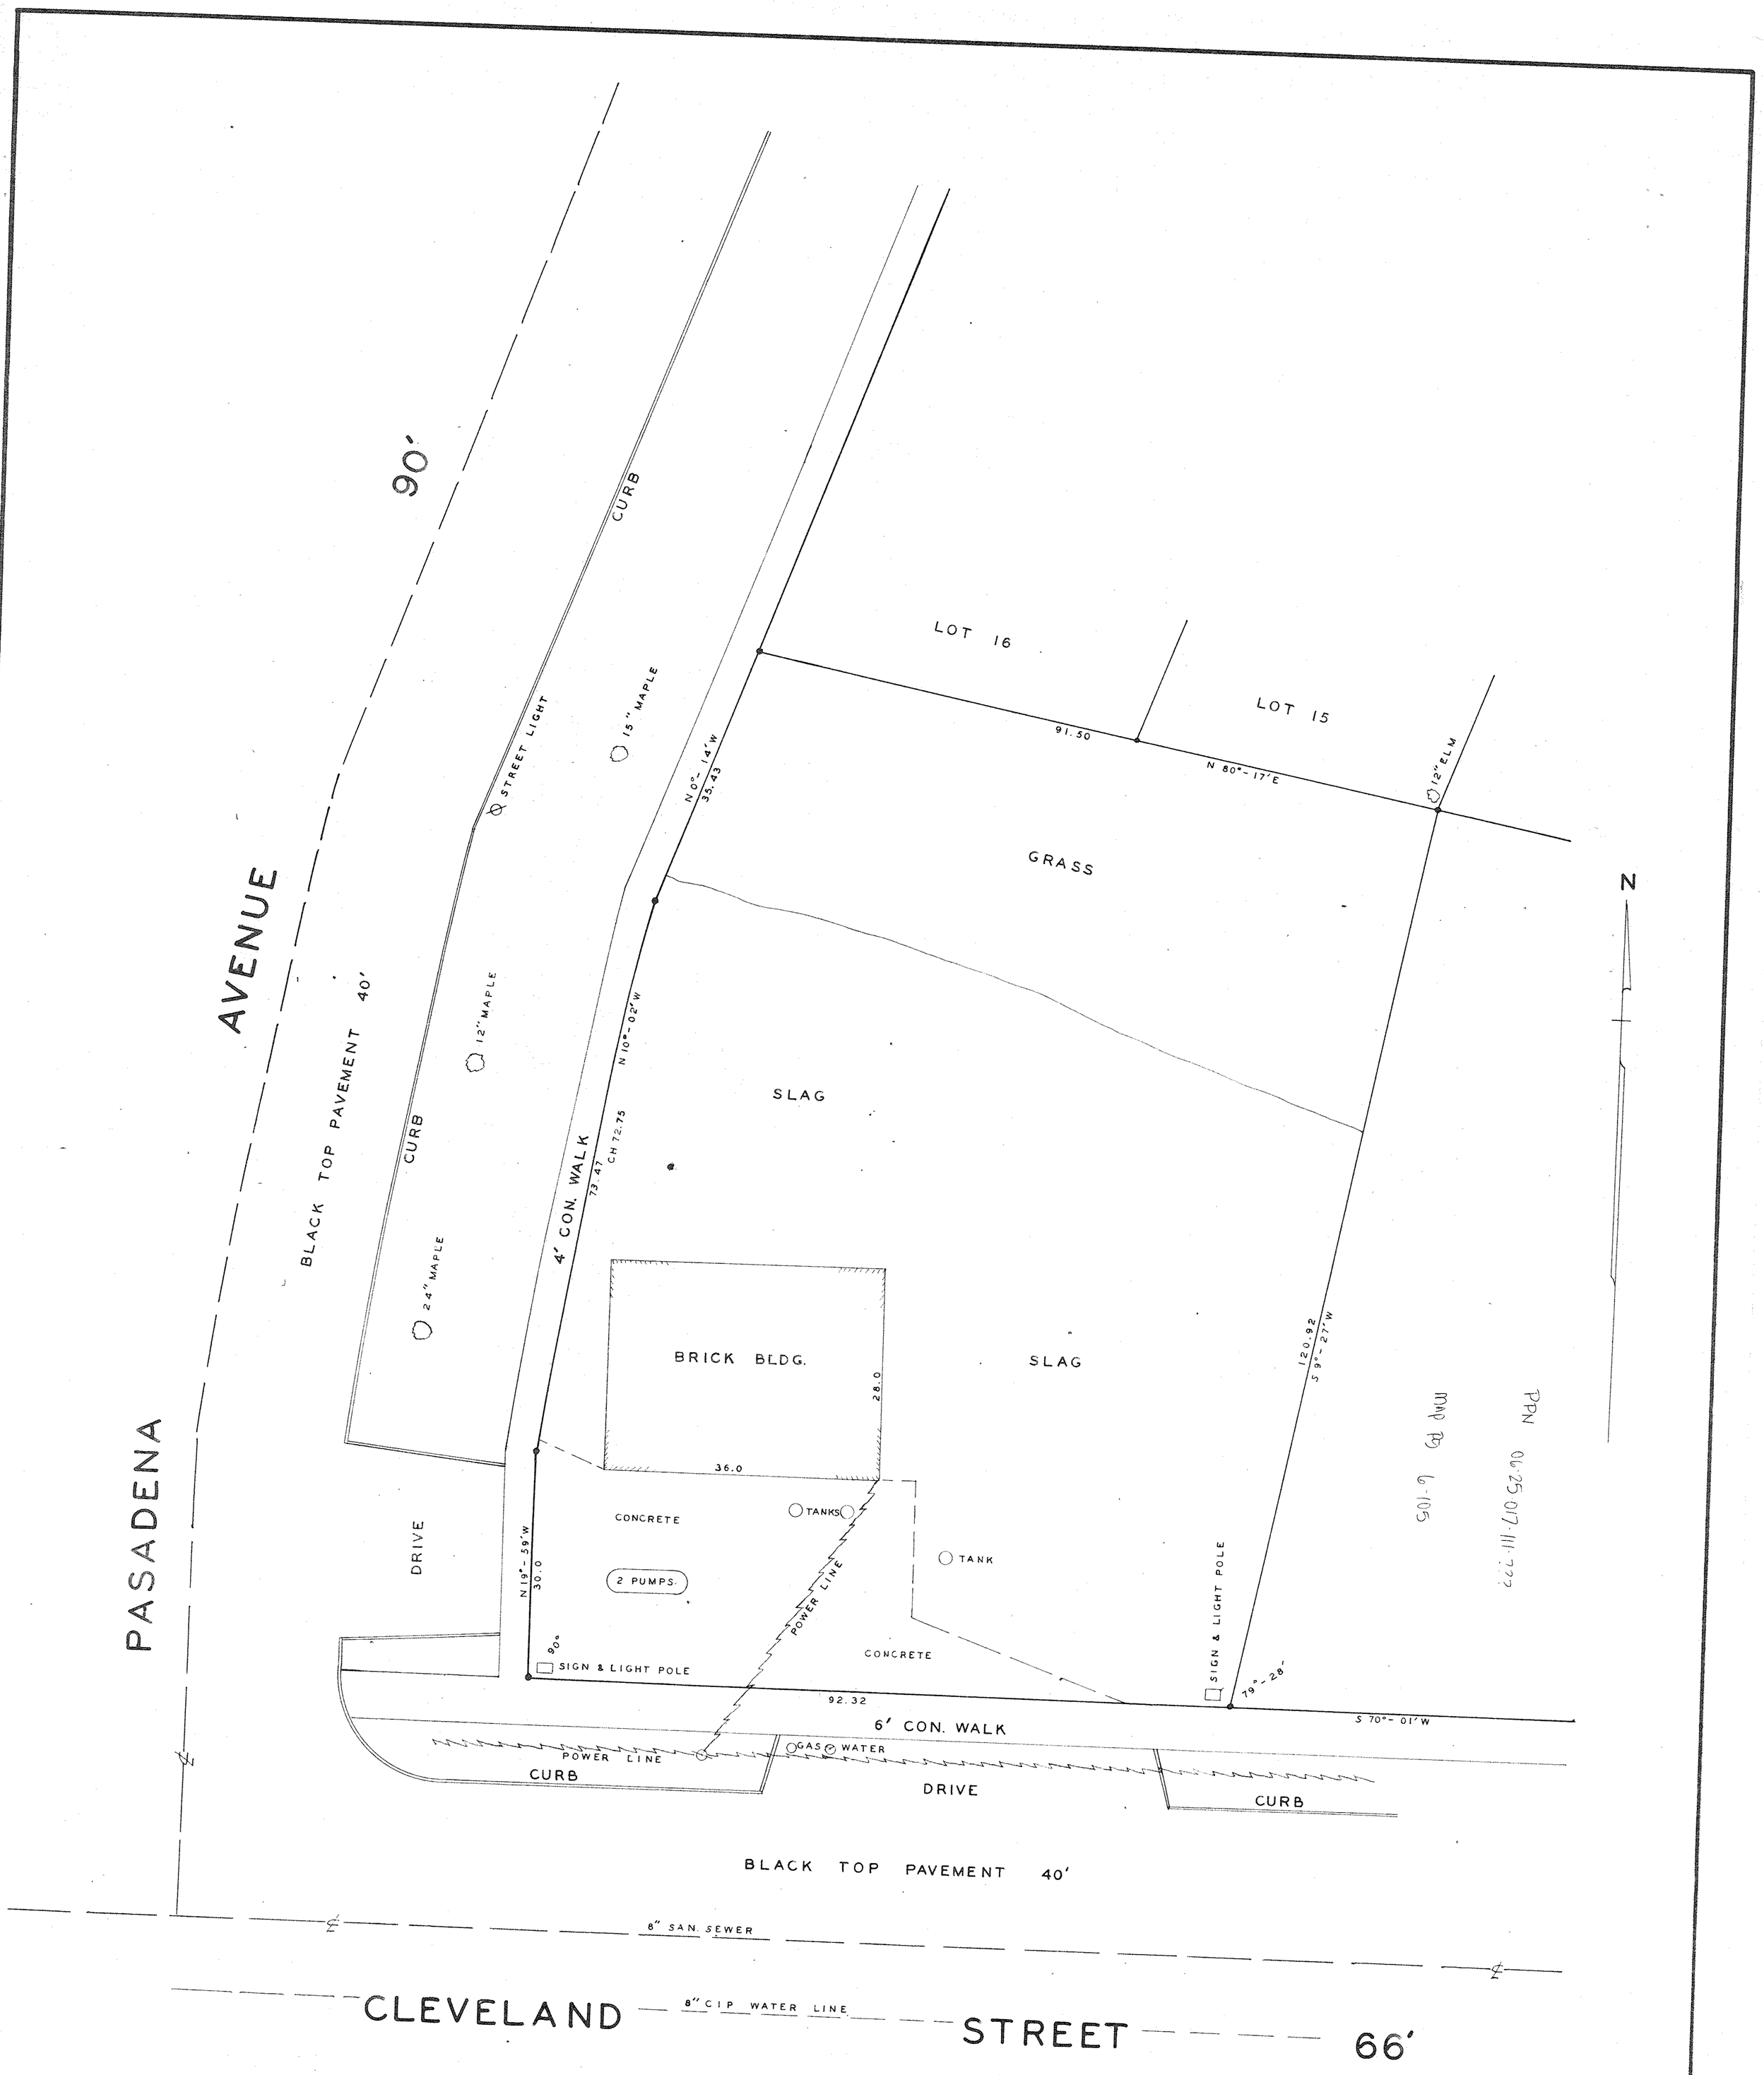

SURVEY AND LOCATION MAP
FOR
SHELL OIL COMPANY
O.L. 17 E. OF EAST BANCH OF BLACK RIVER
SUB LOTS 8-9 PART OF SUB LOT 7
PASADENA PARK ALLOTMENT
MAP VOL. 10 PG. 7
ELYRIA CITY, LORAIN COUNTY, OHIO
SCALE 1" = 10' FEB. 2 1959
J. W. WARDEN AND ASSOCIATES REG. SURVEYORS

IRON STAKES FOUND OR SET AT ALL POINTS INDICATED THUS •

BY D. D. Andrus
D. D. ANDRUS