


10-0530 A

PPN 04-00 019-104 727

MAP Pg 04-00 019-D

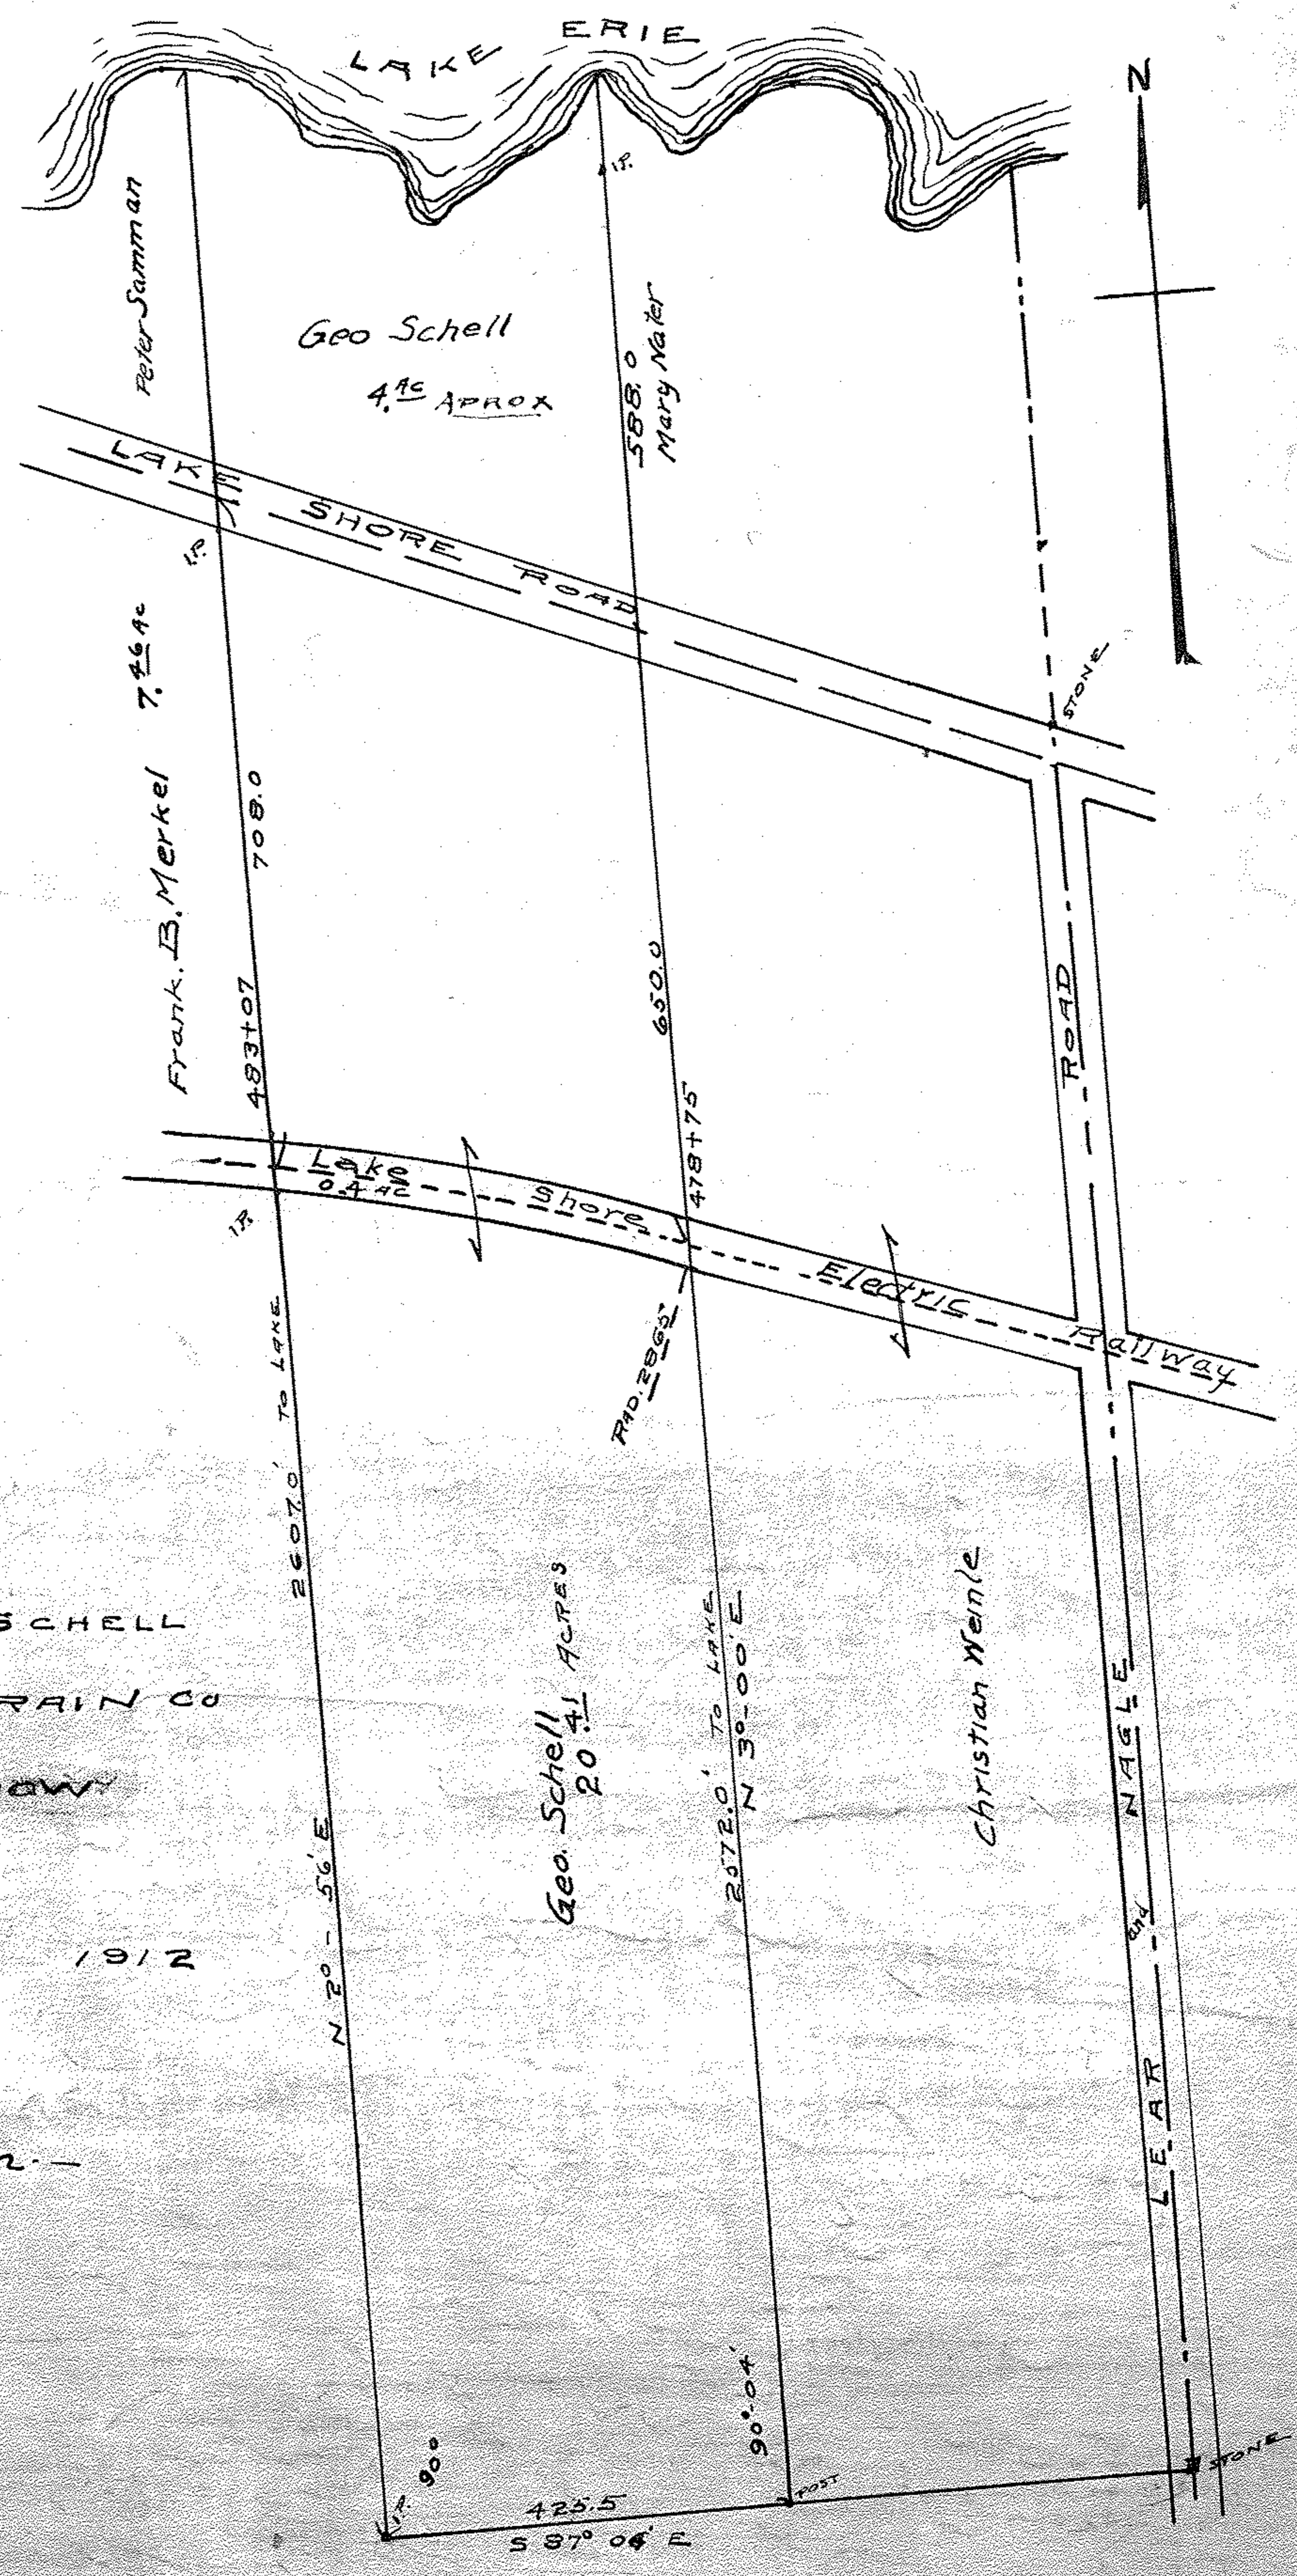

MAP

OF

SURVEY FOR GEO SCHELL

LOT 19 AVON TWP LORAIN CO

SURVEYED BY LOOFBOUROW

MARCH 1898

RESURVEYED MAY 1912

SCALE 1" = 200'

FC Randall
Surveyor -

Geo. Schell
20.41 ACRES

Christian Weinde

Geo Schell
4.15 APPROX

Peter Samman

Mary Nagler
588.0

Frank B. Merkel
7.46 AC

2607.0' TO LAKE

2672.0' TO LAKE

483107

708.0

650.0

478+75

90° 04'

90° 04'

425.5

S 87° 04' E

N

STONE

LEAR BY NAGLE ROAD

STONE

SHORE ROAD

ELECTRIC RAILWAY

Lake Shore

0.4 AC