


PPN 04-00-017-102-???

Survey for C.H. Clague  
Sec 17, Avon Lake Village  
Lorain County, Ohio  
Scale 1"=200' Feby. 9, 1920  
Warden & Laundon. Civil. Engrs.  
Elyria, Ohio

MAP Pg 4-00-017-B

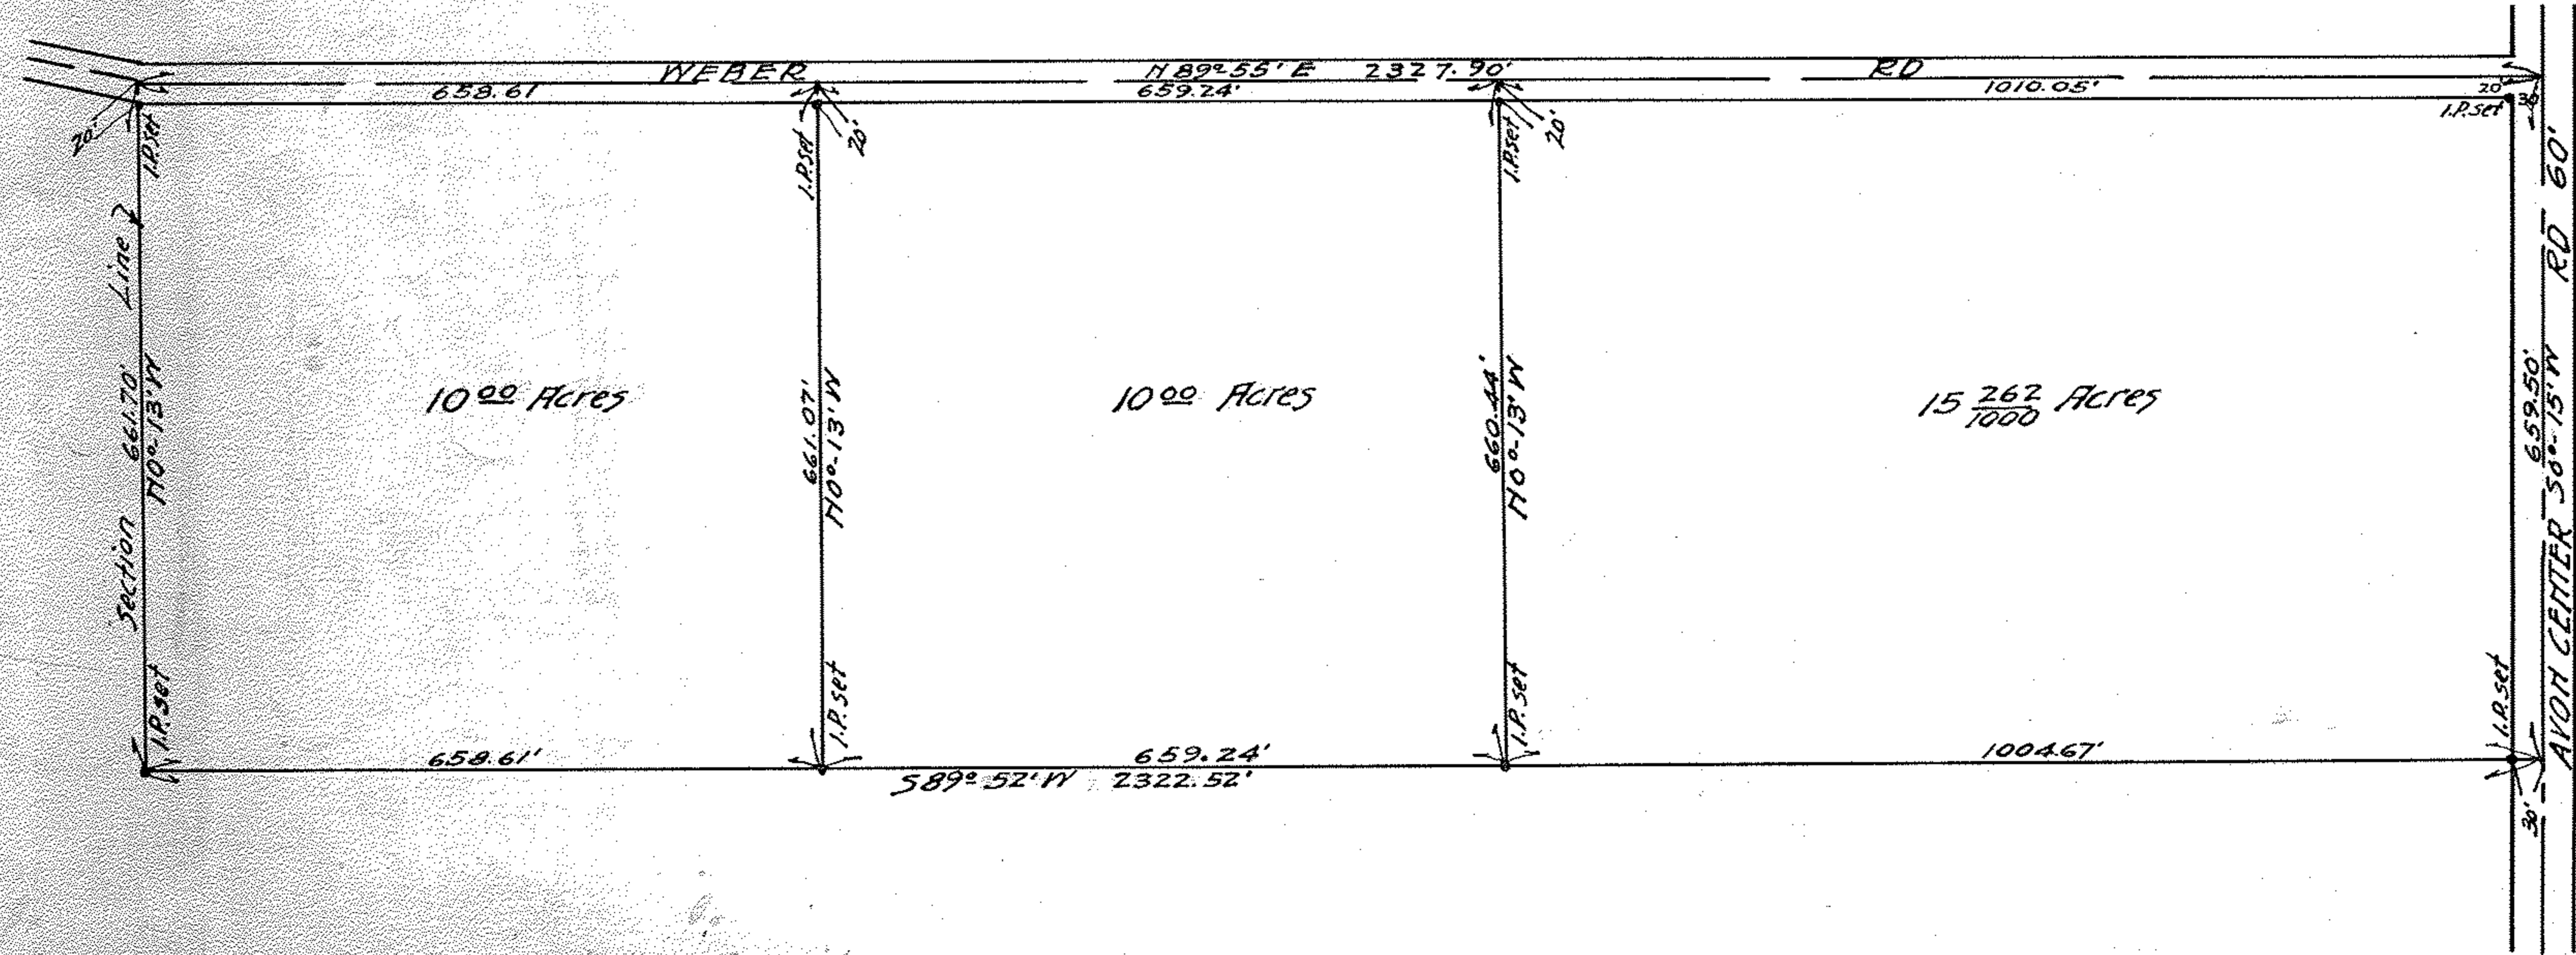

10-01