



PLAT OF PROPERTY SURVEY FOR
VIRGINIA BISHOP TRUST
 PART OF THE ORIGINAL EATON TOWNSHIP LOT 3
 EATON TOWNSHIP, LORAIN COUNTY, OHIO

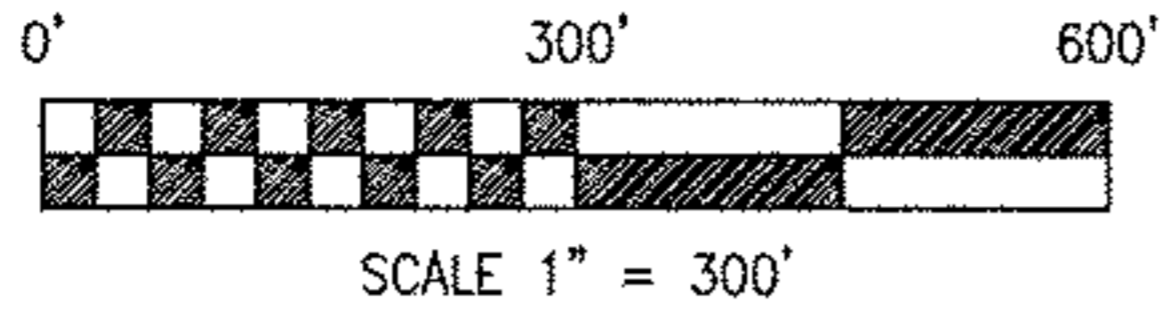

BASIS OF BEARINGS


BEARINGS ARE BASED ON AN ASSUMED MERIDIAN AND ARE USED FOR DETERMINATION OF ANGLES ONLY.

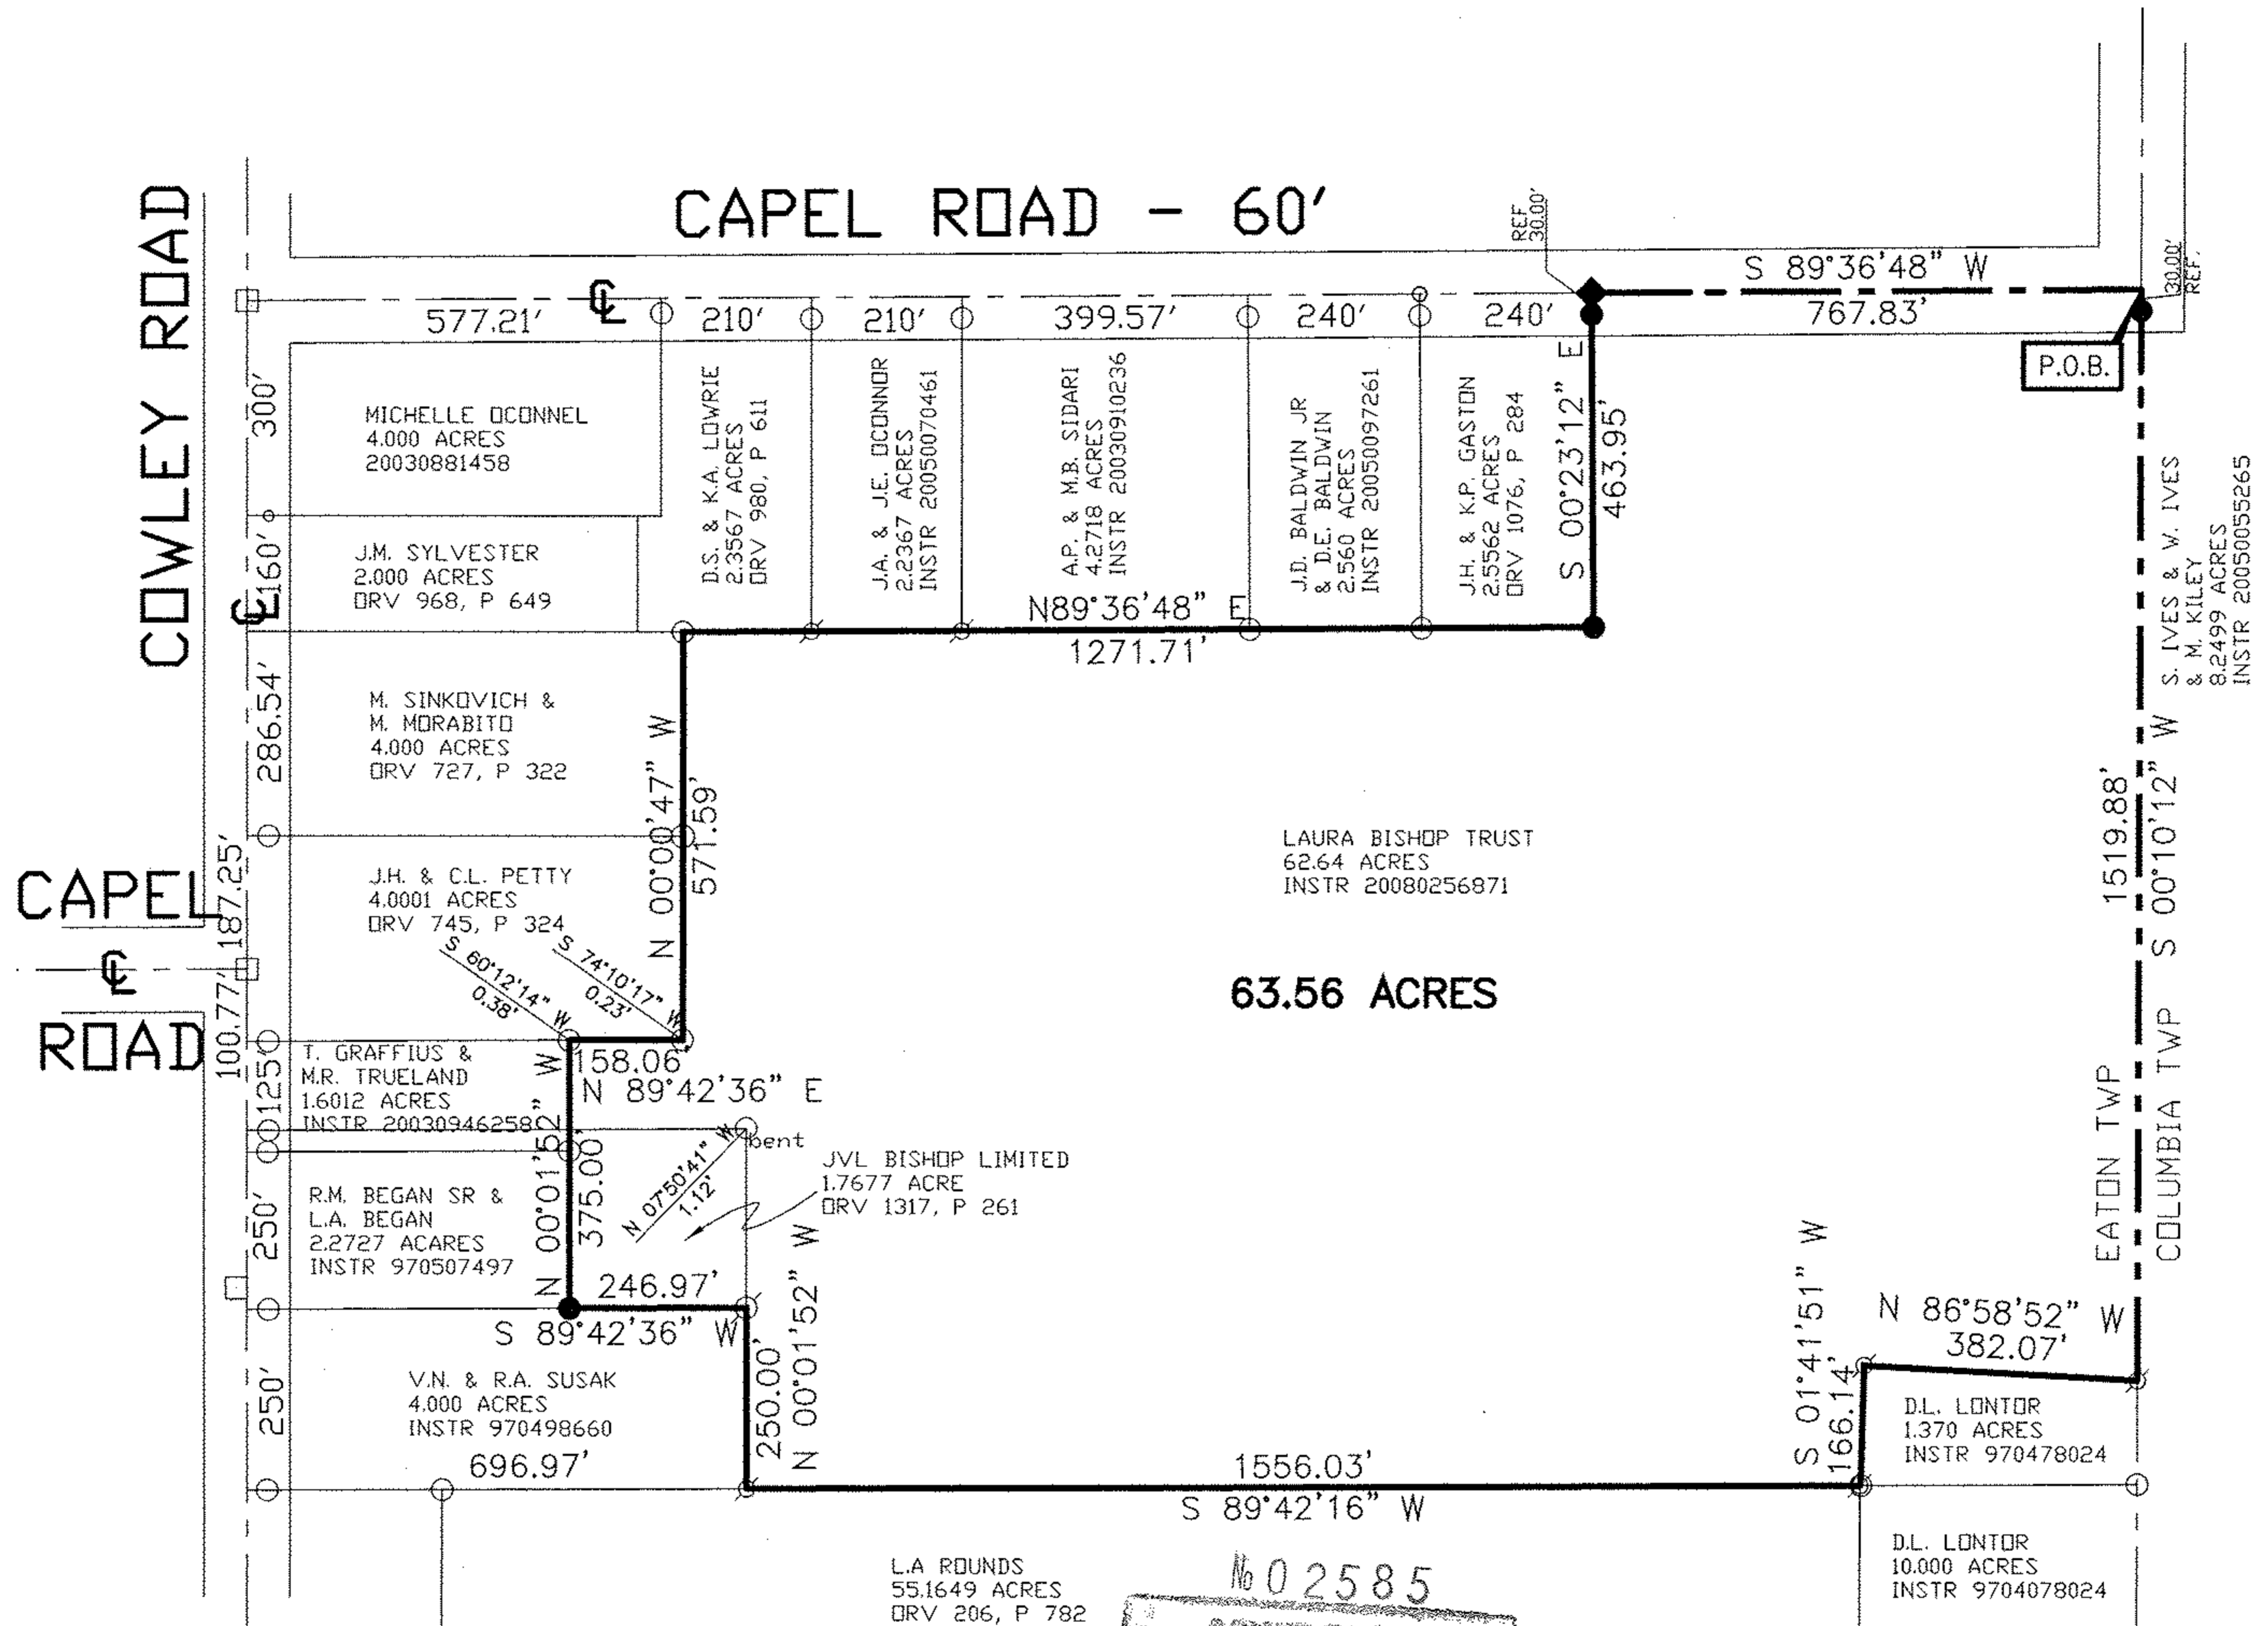

LEGEND

- 5/8" DIA. X 30" LONG REBAR SET WITH PLASTIC CAP STAMPED "LUTZ 6756"
- ◆ RAILROAD SPIKE SET
- IRON PIN FOUND
- ⊗ IRON PIPE FOUND
- MONUMENT BOX FOUND

No 02585
 APPROVED
 LORAIN CO.
 MAP DEPT
 DATE 7-8-08
 11-00-003-000-036-053
 PAGE 11-00-003-B
 BY JHALFIEW
 #08-02585

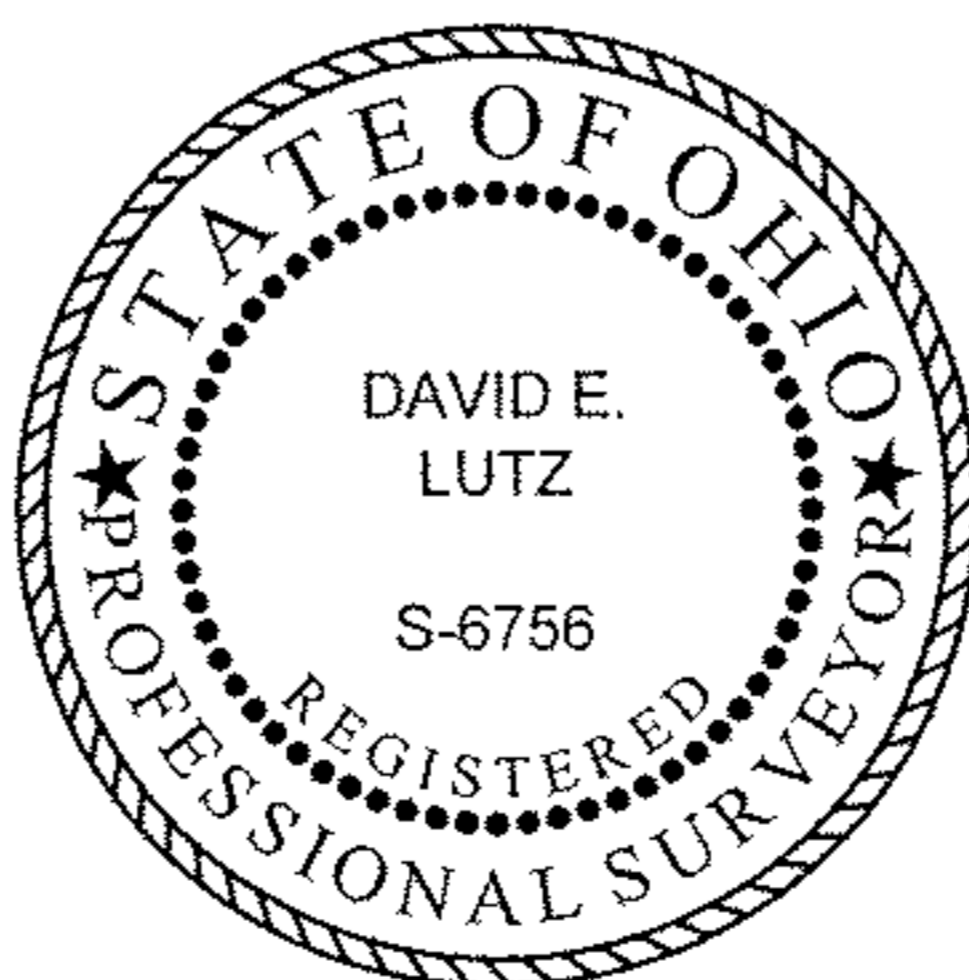

CERTIFICATION: I HEREBY CERTIFY THAT THE FOREGOING SURVEY WAS PREPARED FROM ACTUAL FIELD MEASUREMENTS IN ACCORDANCE WITH CHAPTER 4733-37, OHIO ADMINISTRATIVE CODE.
 PREPARED BY

David E. Lutz

DAVID E. LUTZ
 OHIO REGISTERED SURVEYOR NO. 6756
 DATE: July 2, 2008