PPN 04-00-017-102-???

MAP PG 4-00-017-F

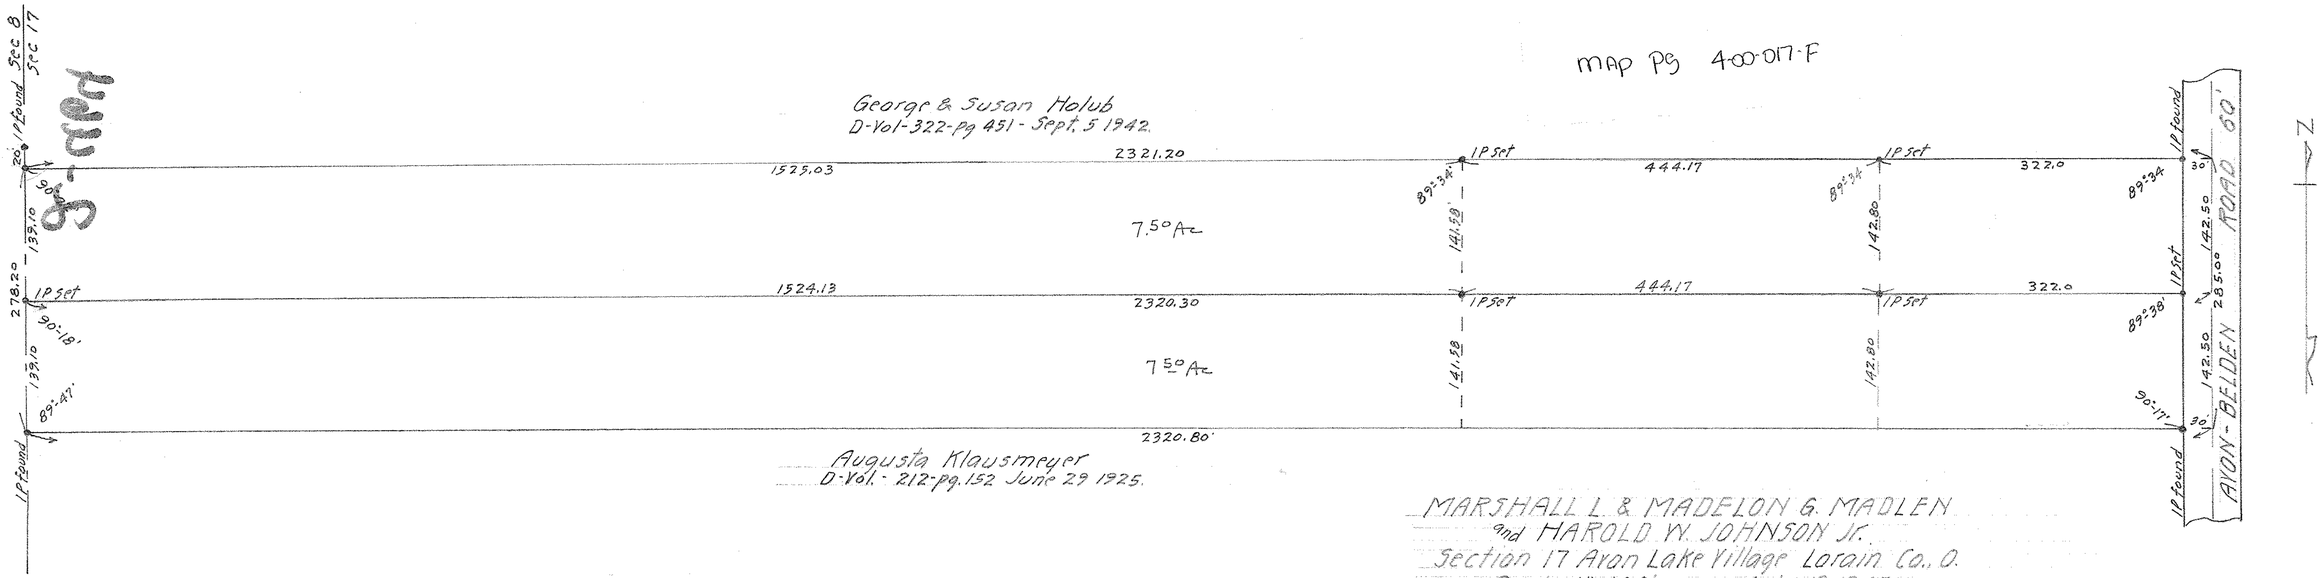

MARSHALL L. & MADELON G. MADLEN
and HAROLD W. JOHNSON Jr.
Section 17 Avon Lake Village Lorain Co., O.
Scale 1" = 100' July 19 1945
J. W. Warden. Registered Surveyor.
D-Vol - 351-pg 251 - April 10 1945