


BROAD

STREET

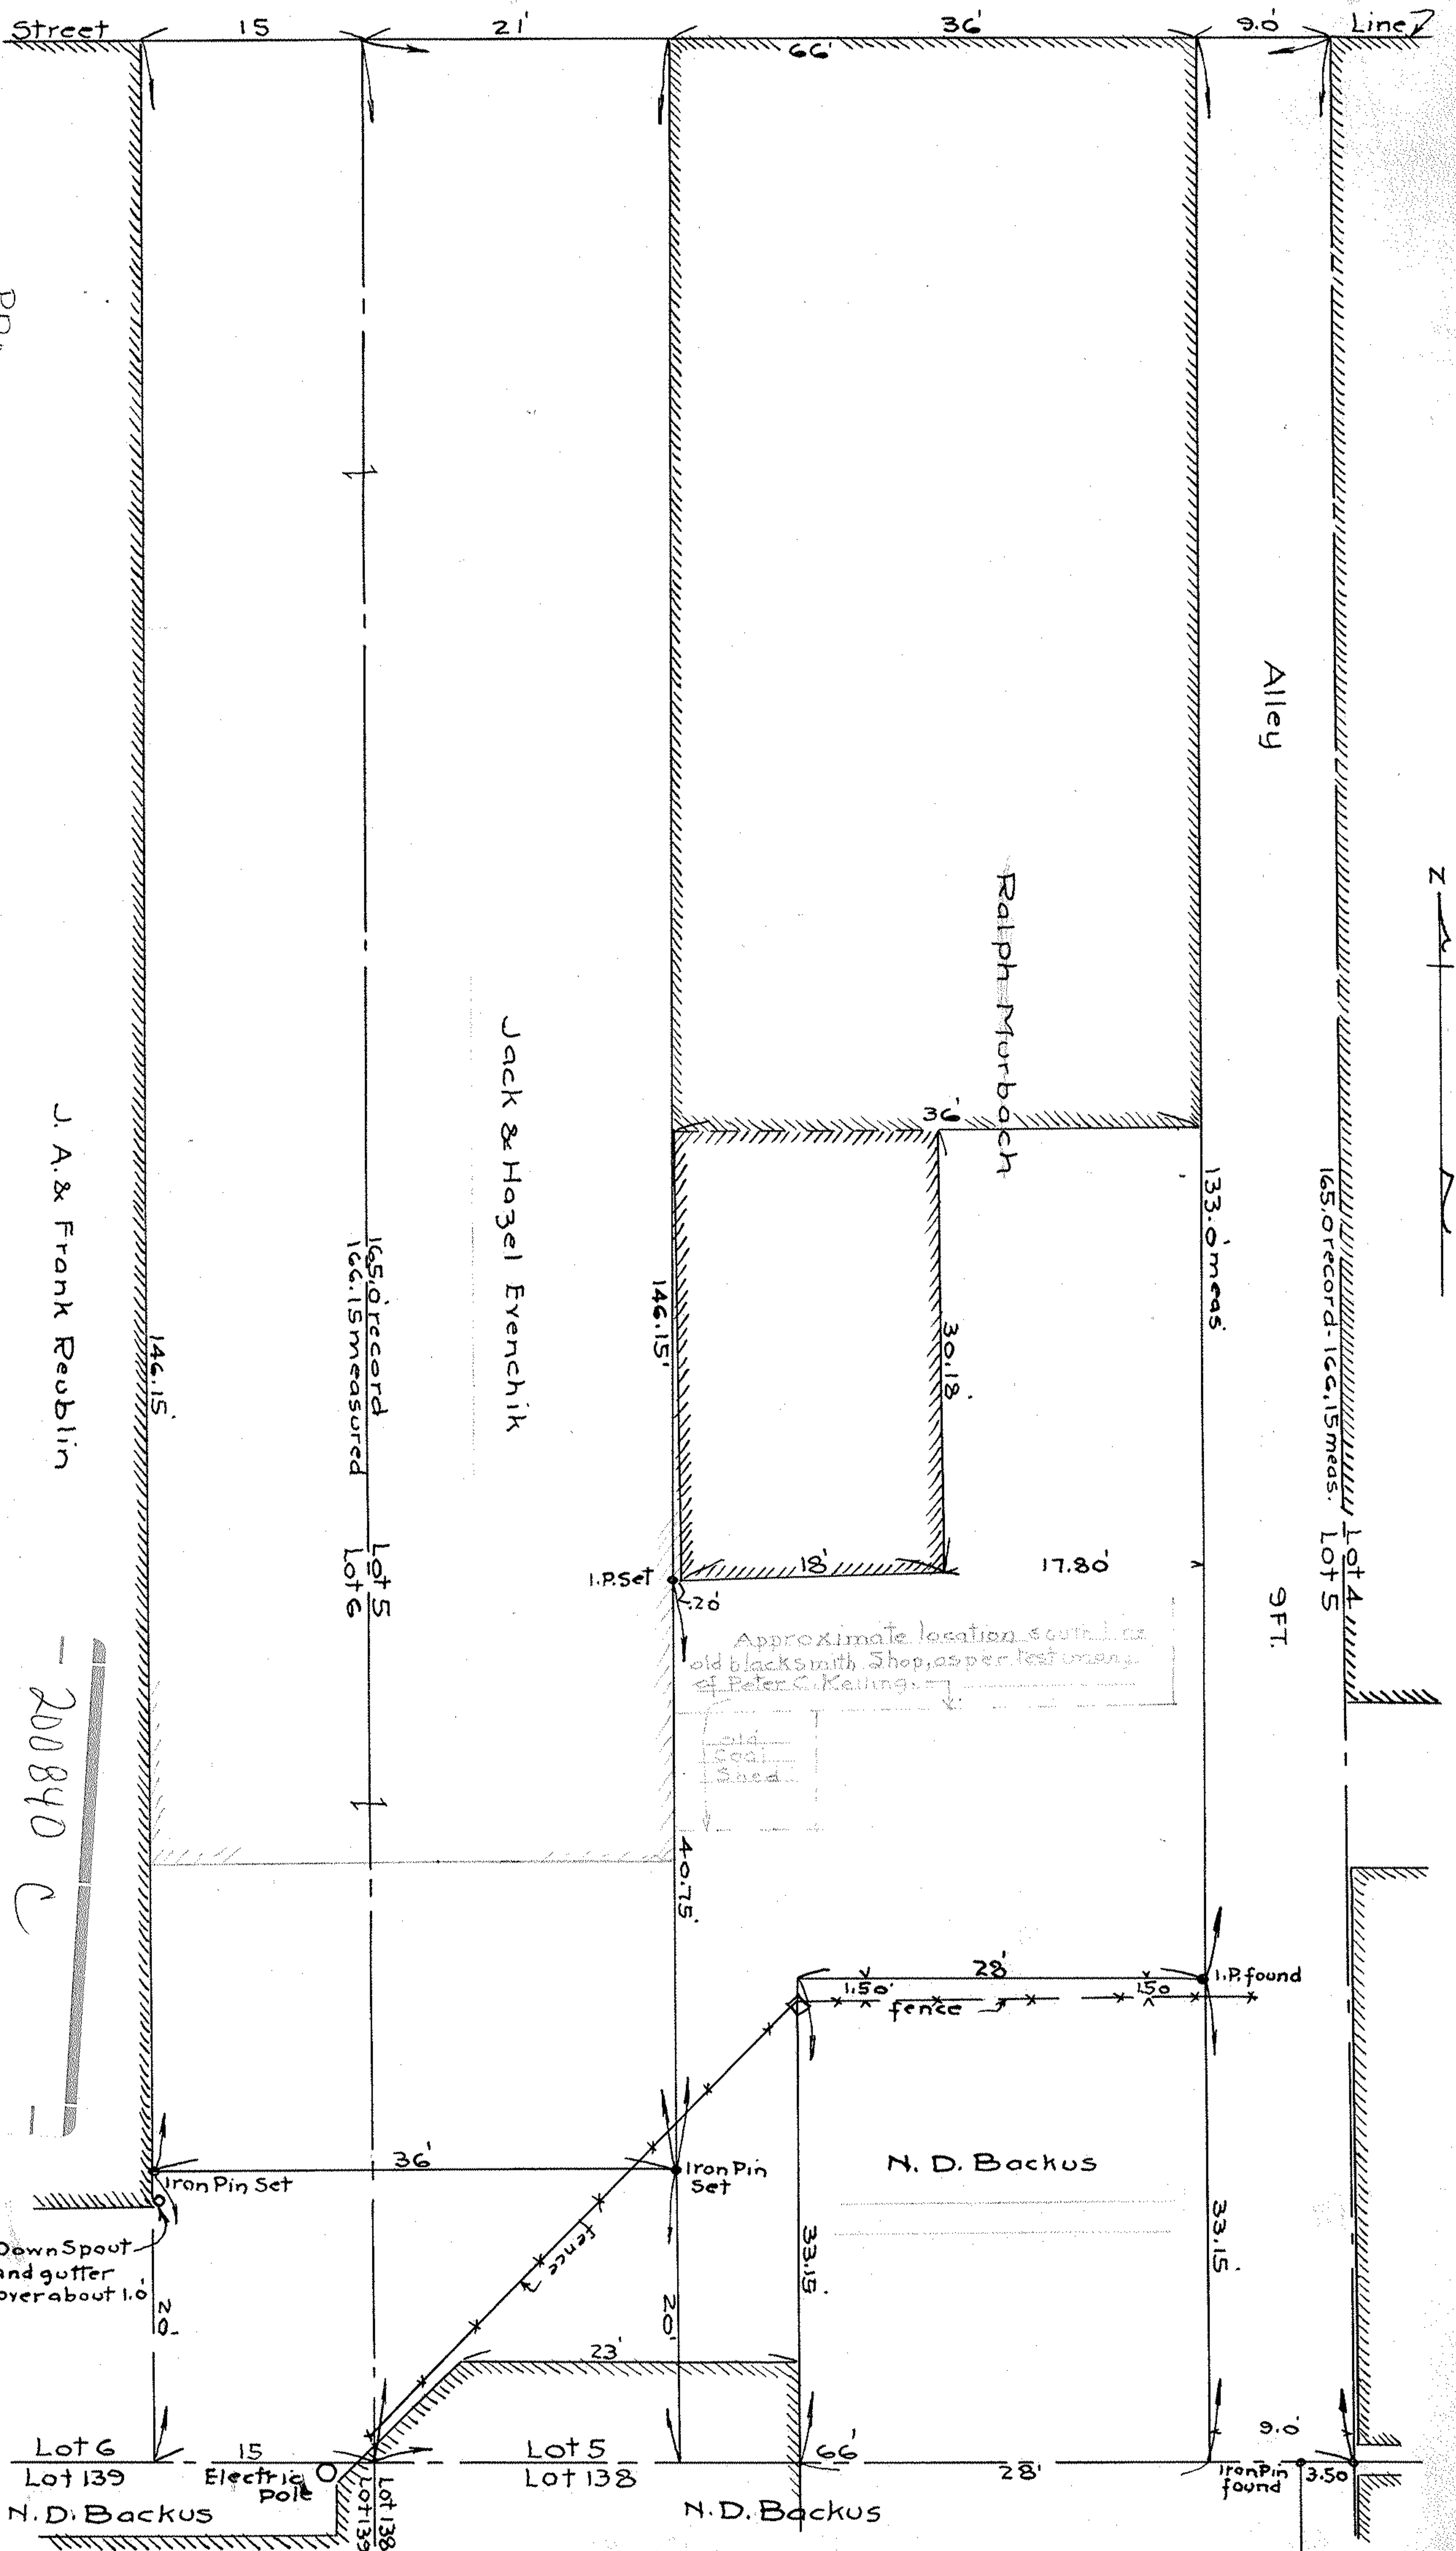

PPN 0626064-000-???

MAP PG 6-119

J. A. & Frank Reublin

200840

Survey for  
**JACK and HAZEL ERENCHIK.**  
 Part of Lots 5 & 6 Block 64 - Between Branches of Black River,  
 Original Village Plat of Elyria,  
 Map Vol. 3 - Pg. 14.

Elyria - Lorain Co., Ohio.  
 Oct. 18, 1941.  
 J. W. Marden, Registered Surveyor.

