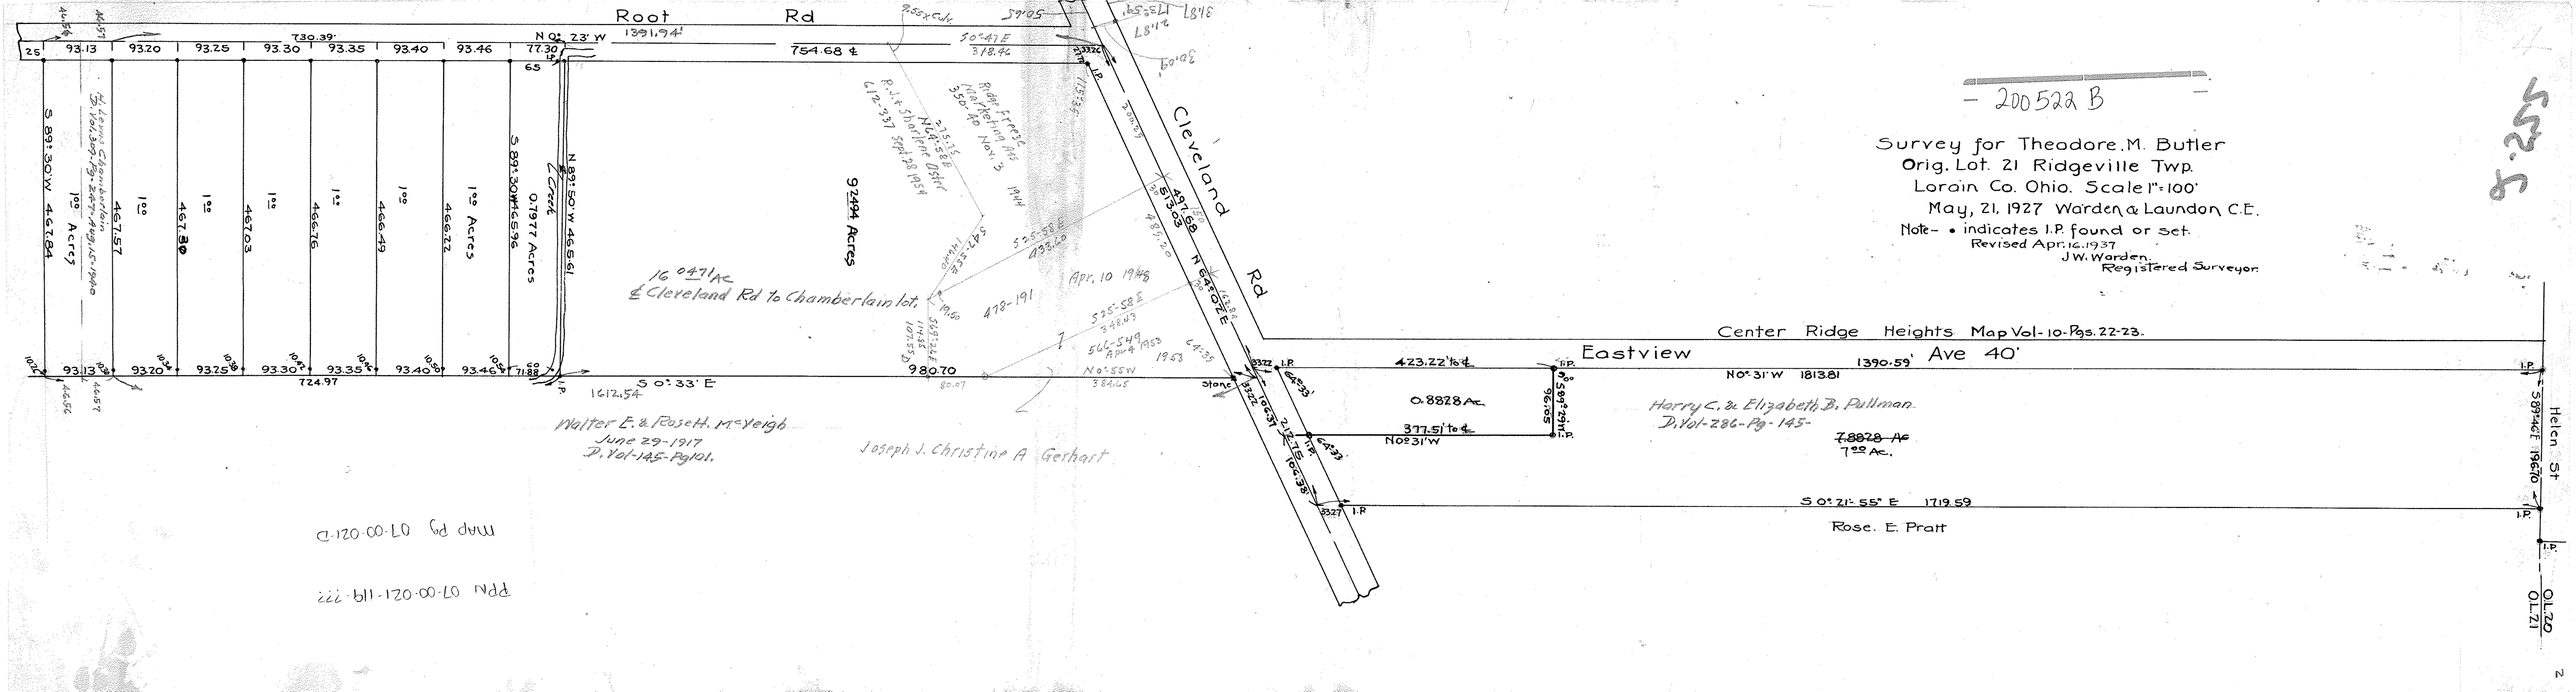

200522 B
Survey for Theodore M. Butler
Orig. Lot. 21 Ridgeville Twp.
Lorain Co. Ohio. Scale 1" = 100'
May, 21, 1927 Warden & Laundon C.E.
Note- • indicates I.P. found or set.
Revised Apr. 16. 1937
J.W. Warden
Registered Surveyor.
Root Rd
Cleveland Rd
Center Ridge Heights Map Vol-10-Pgs. 22-23.
Eastview Ave 40'
Helen St
Rose. E. Pratt
Walter E. & Rose H. McVeigh
June 29-1917
D. Vol-145-Pg 101.
Joseph J. Christine A Gerhart
Harry C. & Elizabeth B. Pullman
D. Vol-286-Pg-145-
7.8828 Ac
7.00 Ac.
16.0471 Ac
℄ Cleveland Rd to Chamberlain lot.
Apr. 10 1948
9.2494 Acres
0.7977 Acres
0.8828 Ac.
S 0° 33' E
S 0° 21' 55" E 1719.59
N 0° 31' W 1813.81
N 0° 23' W
S 89° 30' W 467.84
S 89° 30' W 465.96
N 89° 50' W 465.61
S 89° 46' E 196.70
OL 20
OL 21