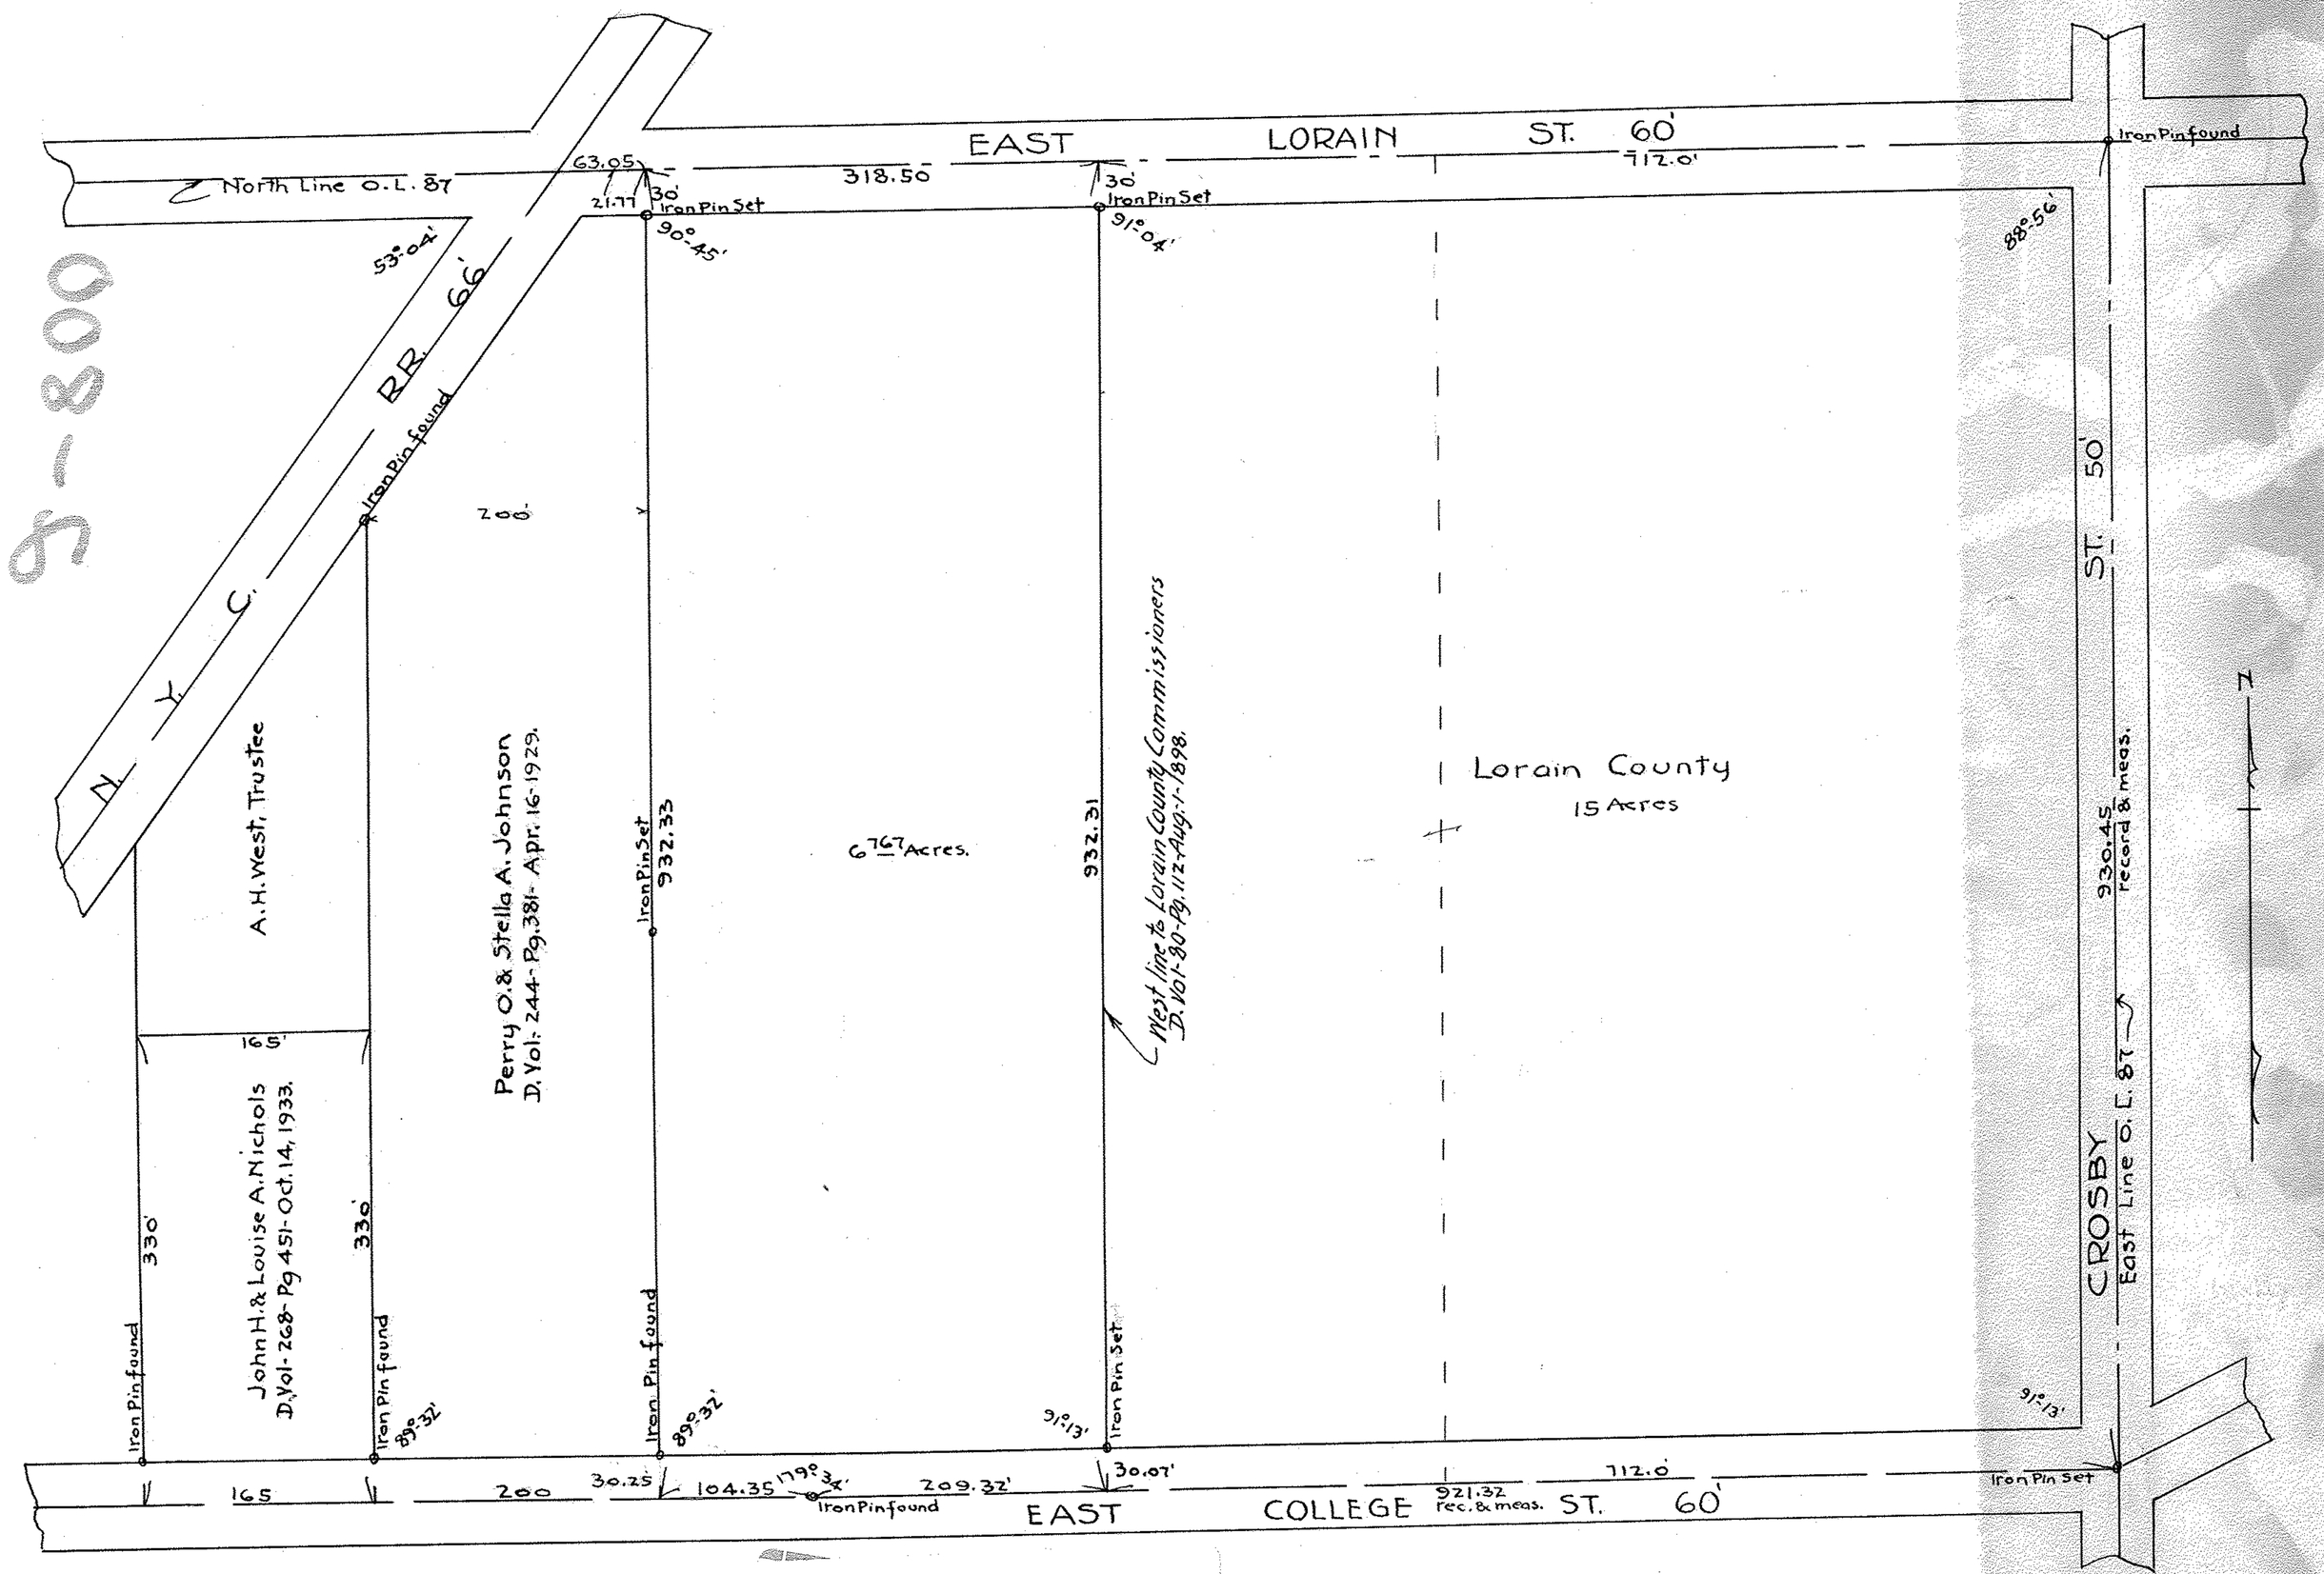

PPN 09-00-087-103-???

MAP Pg 09-00-087-A

Survey for
Flora B. Caskey.
Original Twp., Lot 87- Russia Twp.,
Oberlin Village, Lorain Co.,
Ohio.
Dec. 20-1939. Scale 1" = 100'.
J. W. Warden- Registered Surveyor.