


PPN 06-24-150-000-???
 06-24-151-000-???
 06-24-152-000-???

MAP PG 6-100

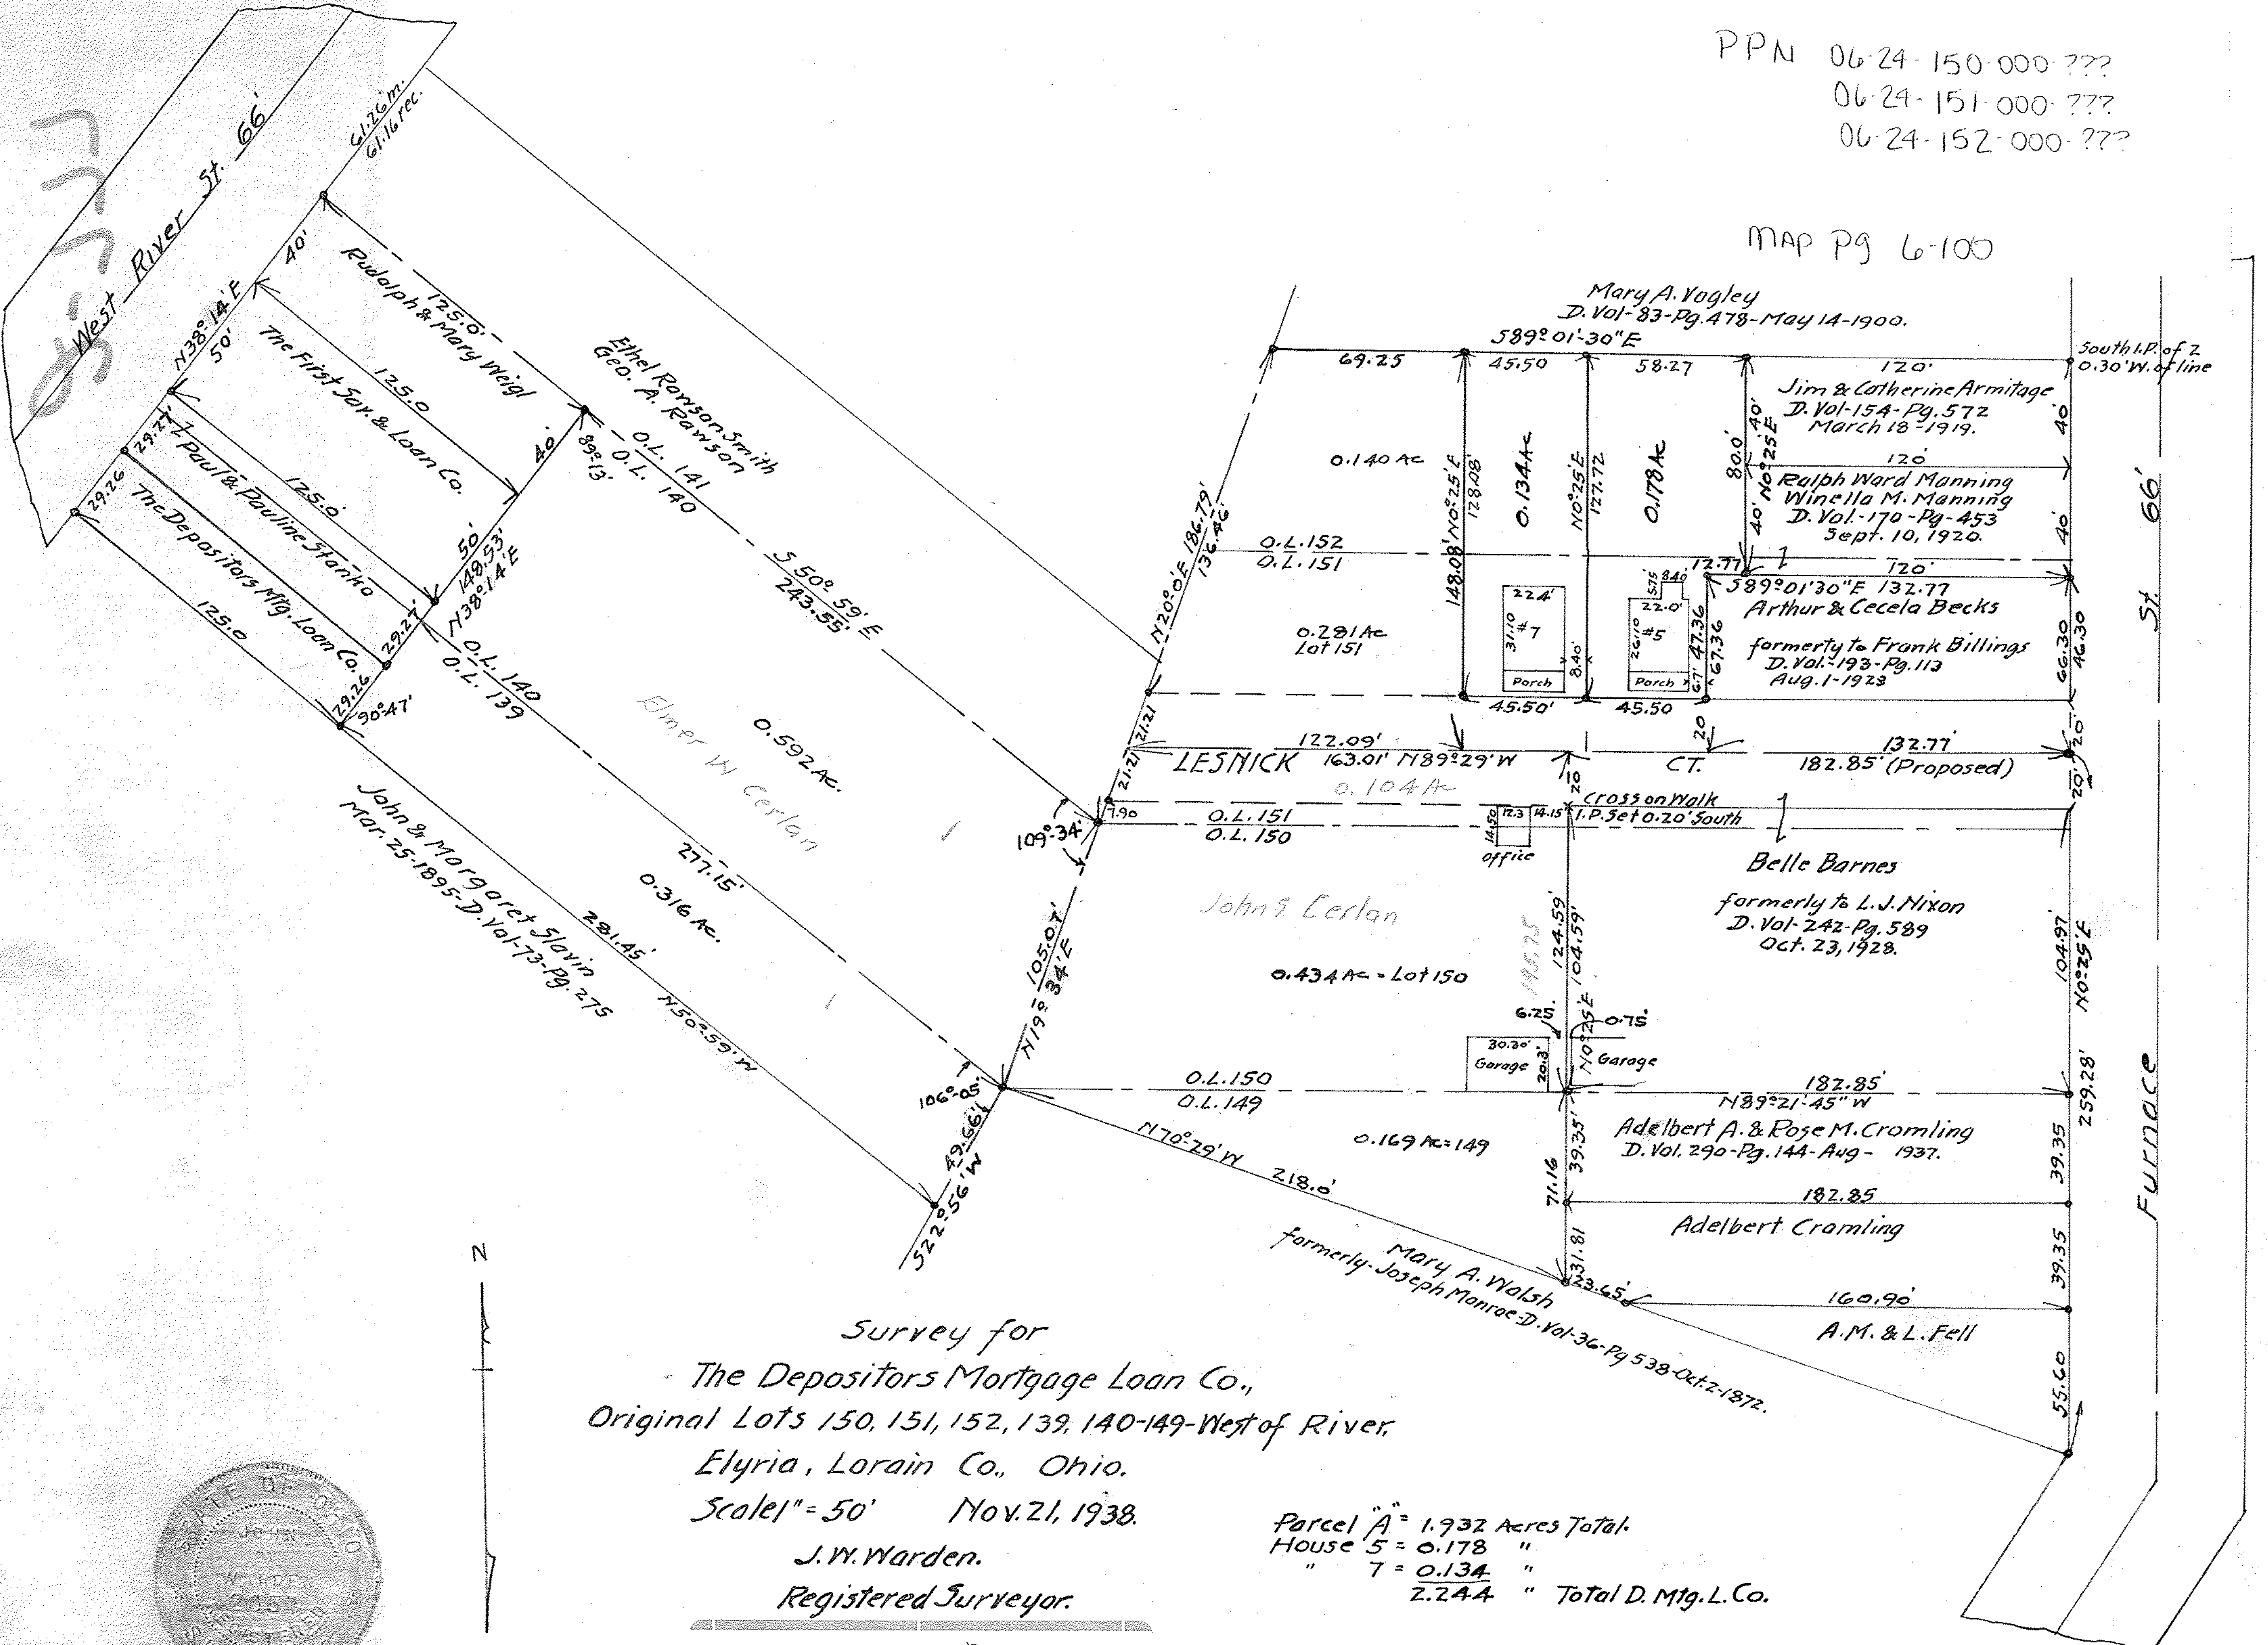

Survey for
 The Depositors Mortgage Loan Co.,
 Original Lots 150, 151, 152, 139, 140-149-West of River,

Elyria, Lorain Co., Ohio.
 Scale" = 50' Nov. 21, 1938.
 J. W. Warden.
 Registered Surveyor.

Parcel "A" = 1.932 Acres Total.
 House 5 = 0.178 "
 " 7 = 0.134 "
 2.244 " Total D. Mtg. L. Co.

200777 B

