


Survey for
 J.F. & Blodwin Kovatch.
 Lot 16- Avon Lake Subdivision.
 Section 18-Avon Twp., Avon Lake Village,
 Lorain Co., Ohio.
 July 8-1939. Scale 1"=10 feet.

200787

PPN 04-00-016-101-???
 MAP PG 04-00-016 B

J.W. Warden, Registered Surveyor.
 ST. 50

DRUMMOND

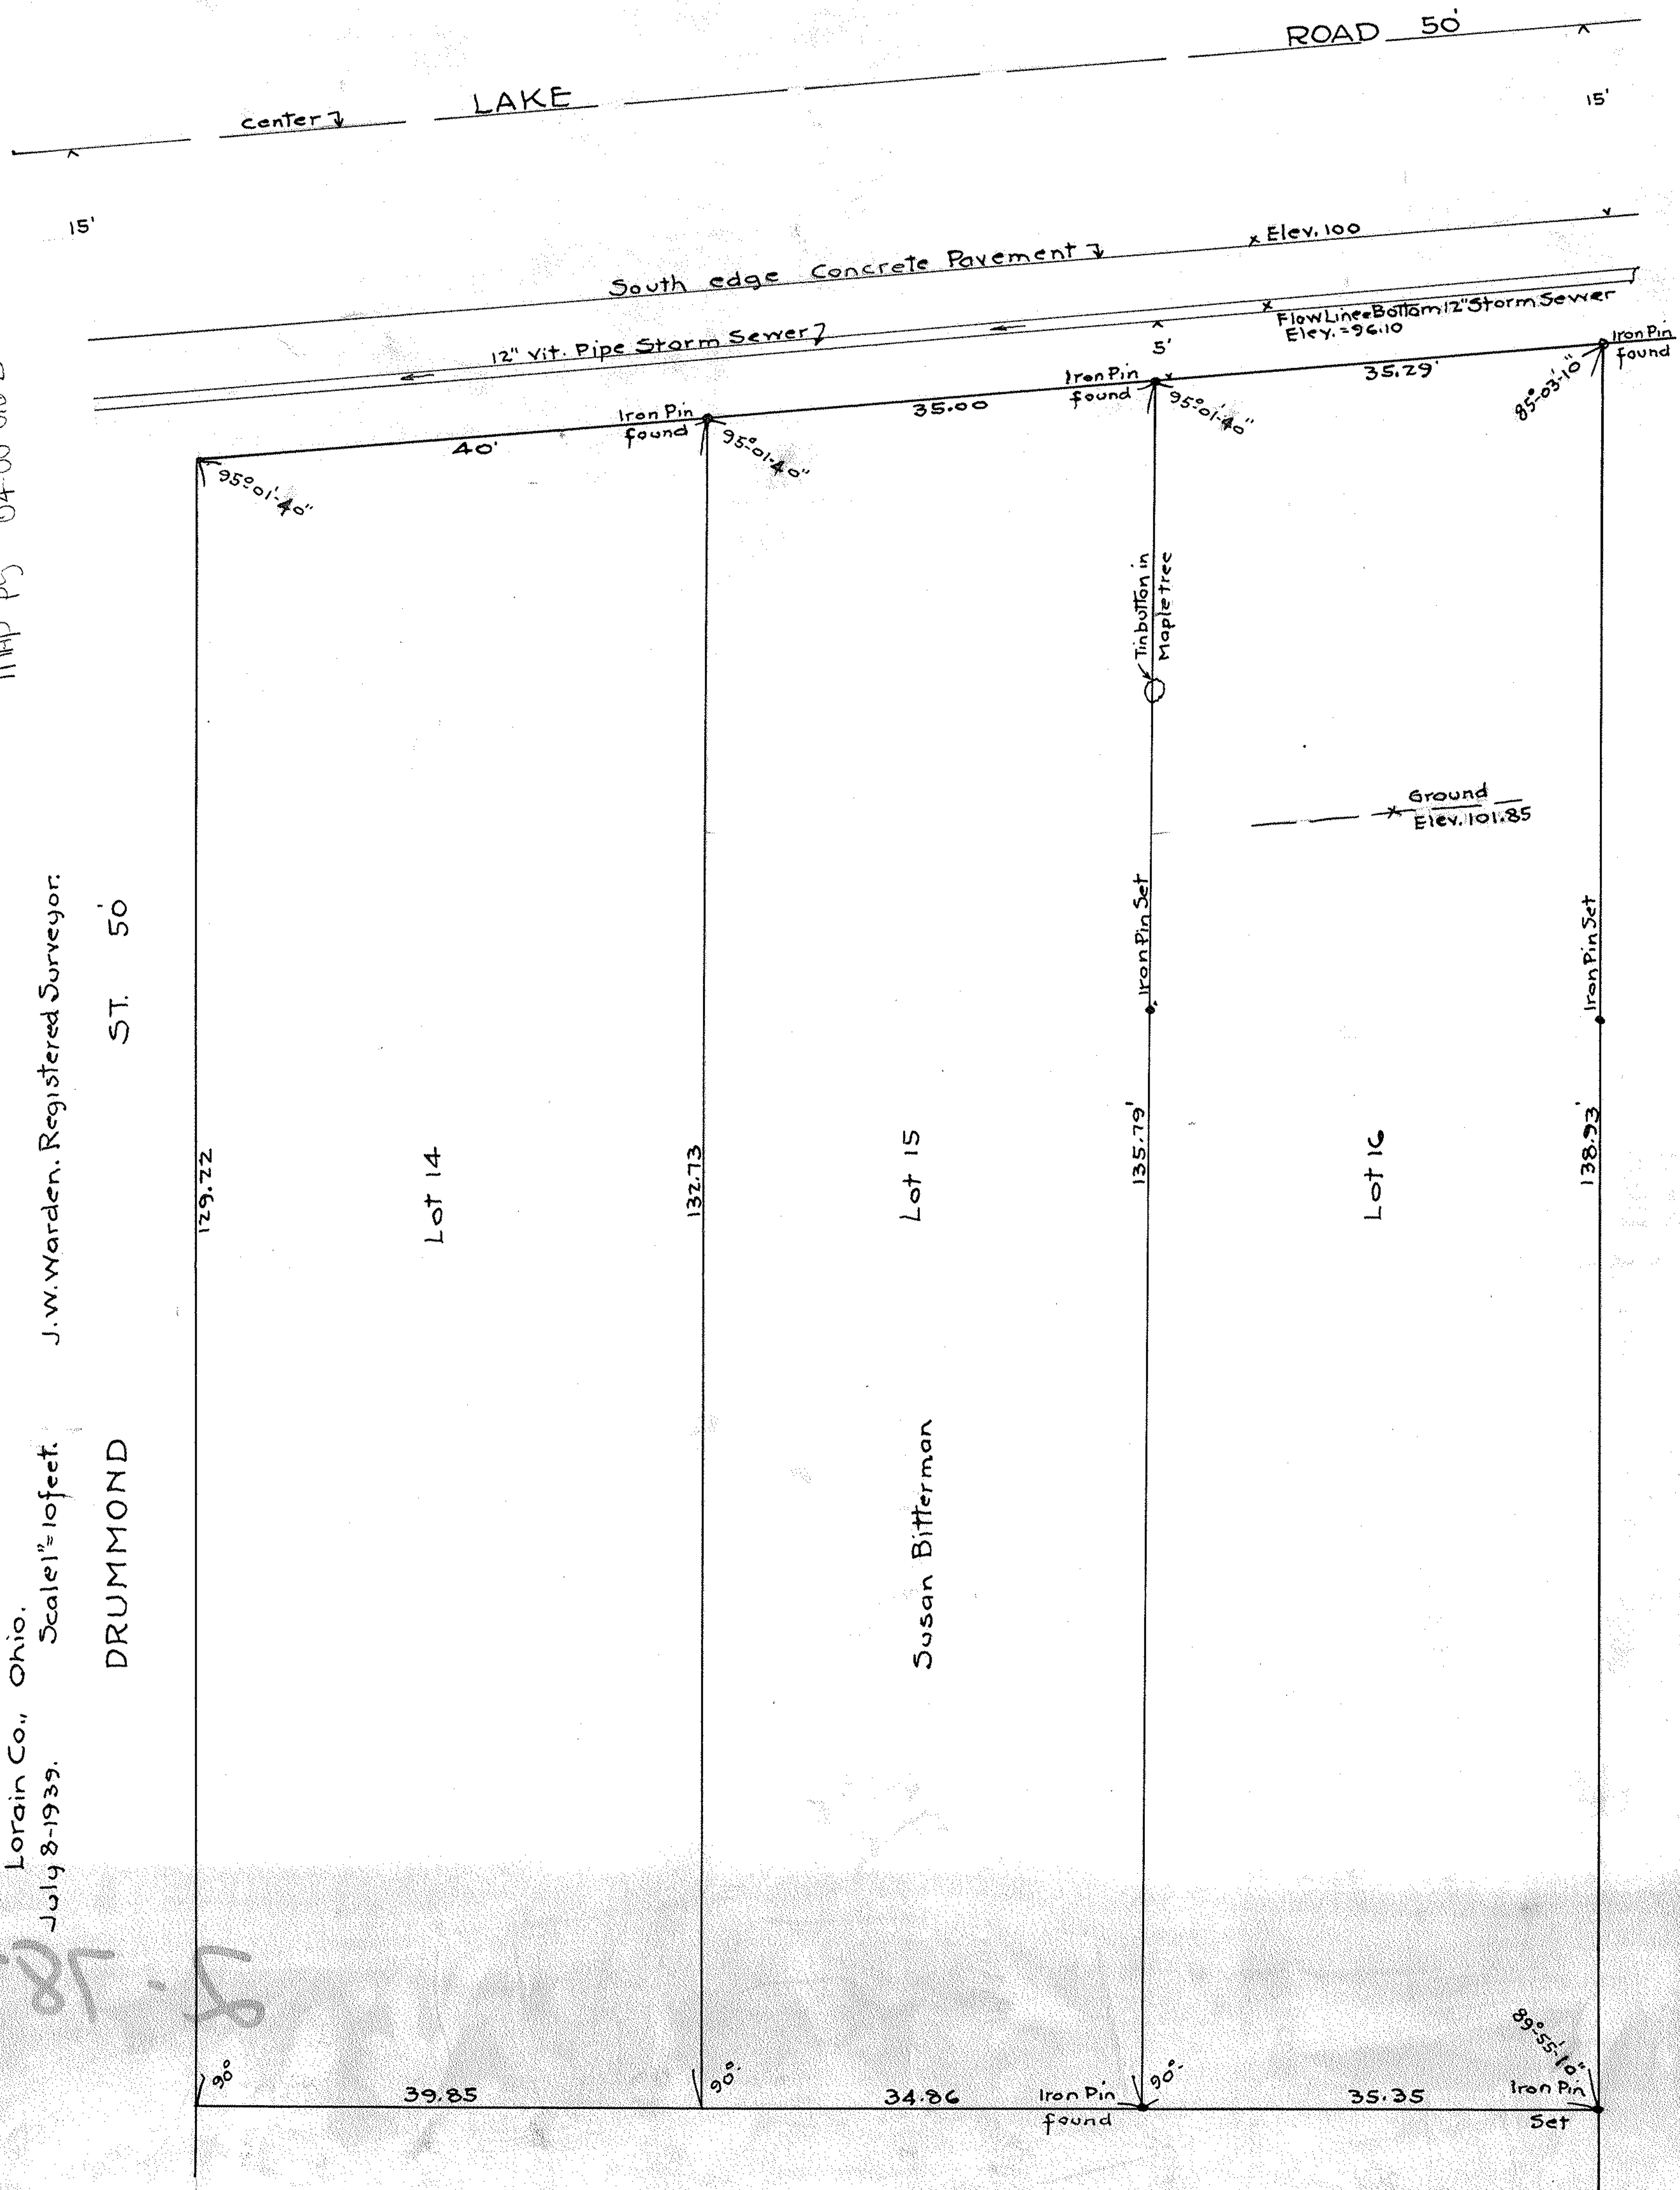

Susan Bitterman

Ground Elev. 101.85

Tributton in Maple tree

Iron Pin found

Iron Pin found

Iron Pin found

Iron Pin found

Iron Pin Set

Iron Pin Set

Iron Pin Set

132.73

135.79'

138.93'

Lot 14

Lot 15

Lot 16

39.85

34.86

35.35

40'

35.00

35.29'

129.72

95°01'40"

95°01'40"

95°01'40"

89°55'10"

90°

90°

90°

center

LAKE

ROAD 50

15'

15'

Elev. 100

Flow Line Bottom 12" Storm Sewer Elev. = 96.10