


PPN 0624-083-102-???

MAP PG 6-80

200736 A

Survey for
The Depositors Mortgage Loan Co.,
Part Lot 78- W¹²A. Braman Addn.,
Map Vol-3-Pg-1.
Original Twp., Lot 83- West of Black River,
Elyria Twp., - Elyria City - Lorain Co., O.
June-9-1939. Scale-1"=20ft.
J. W. Warden-Registered Surveyor.

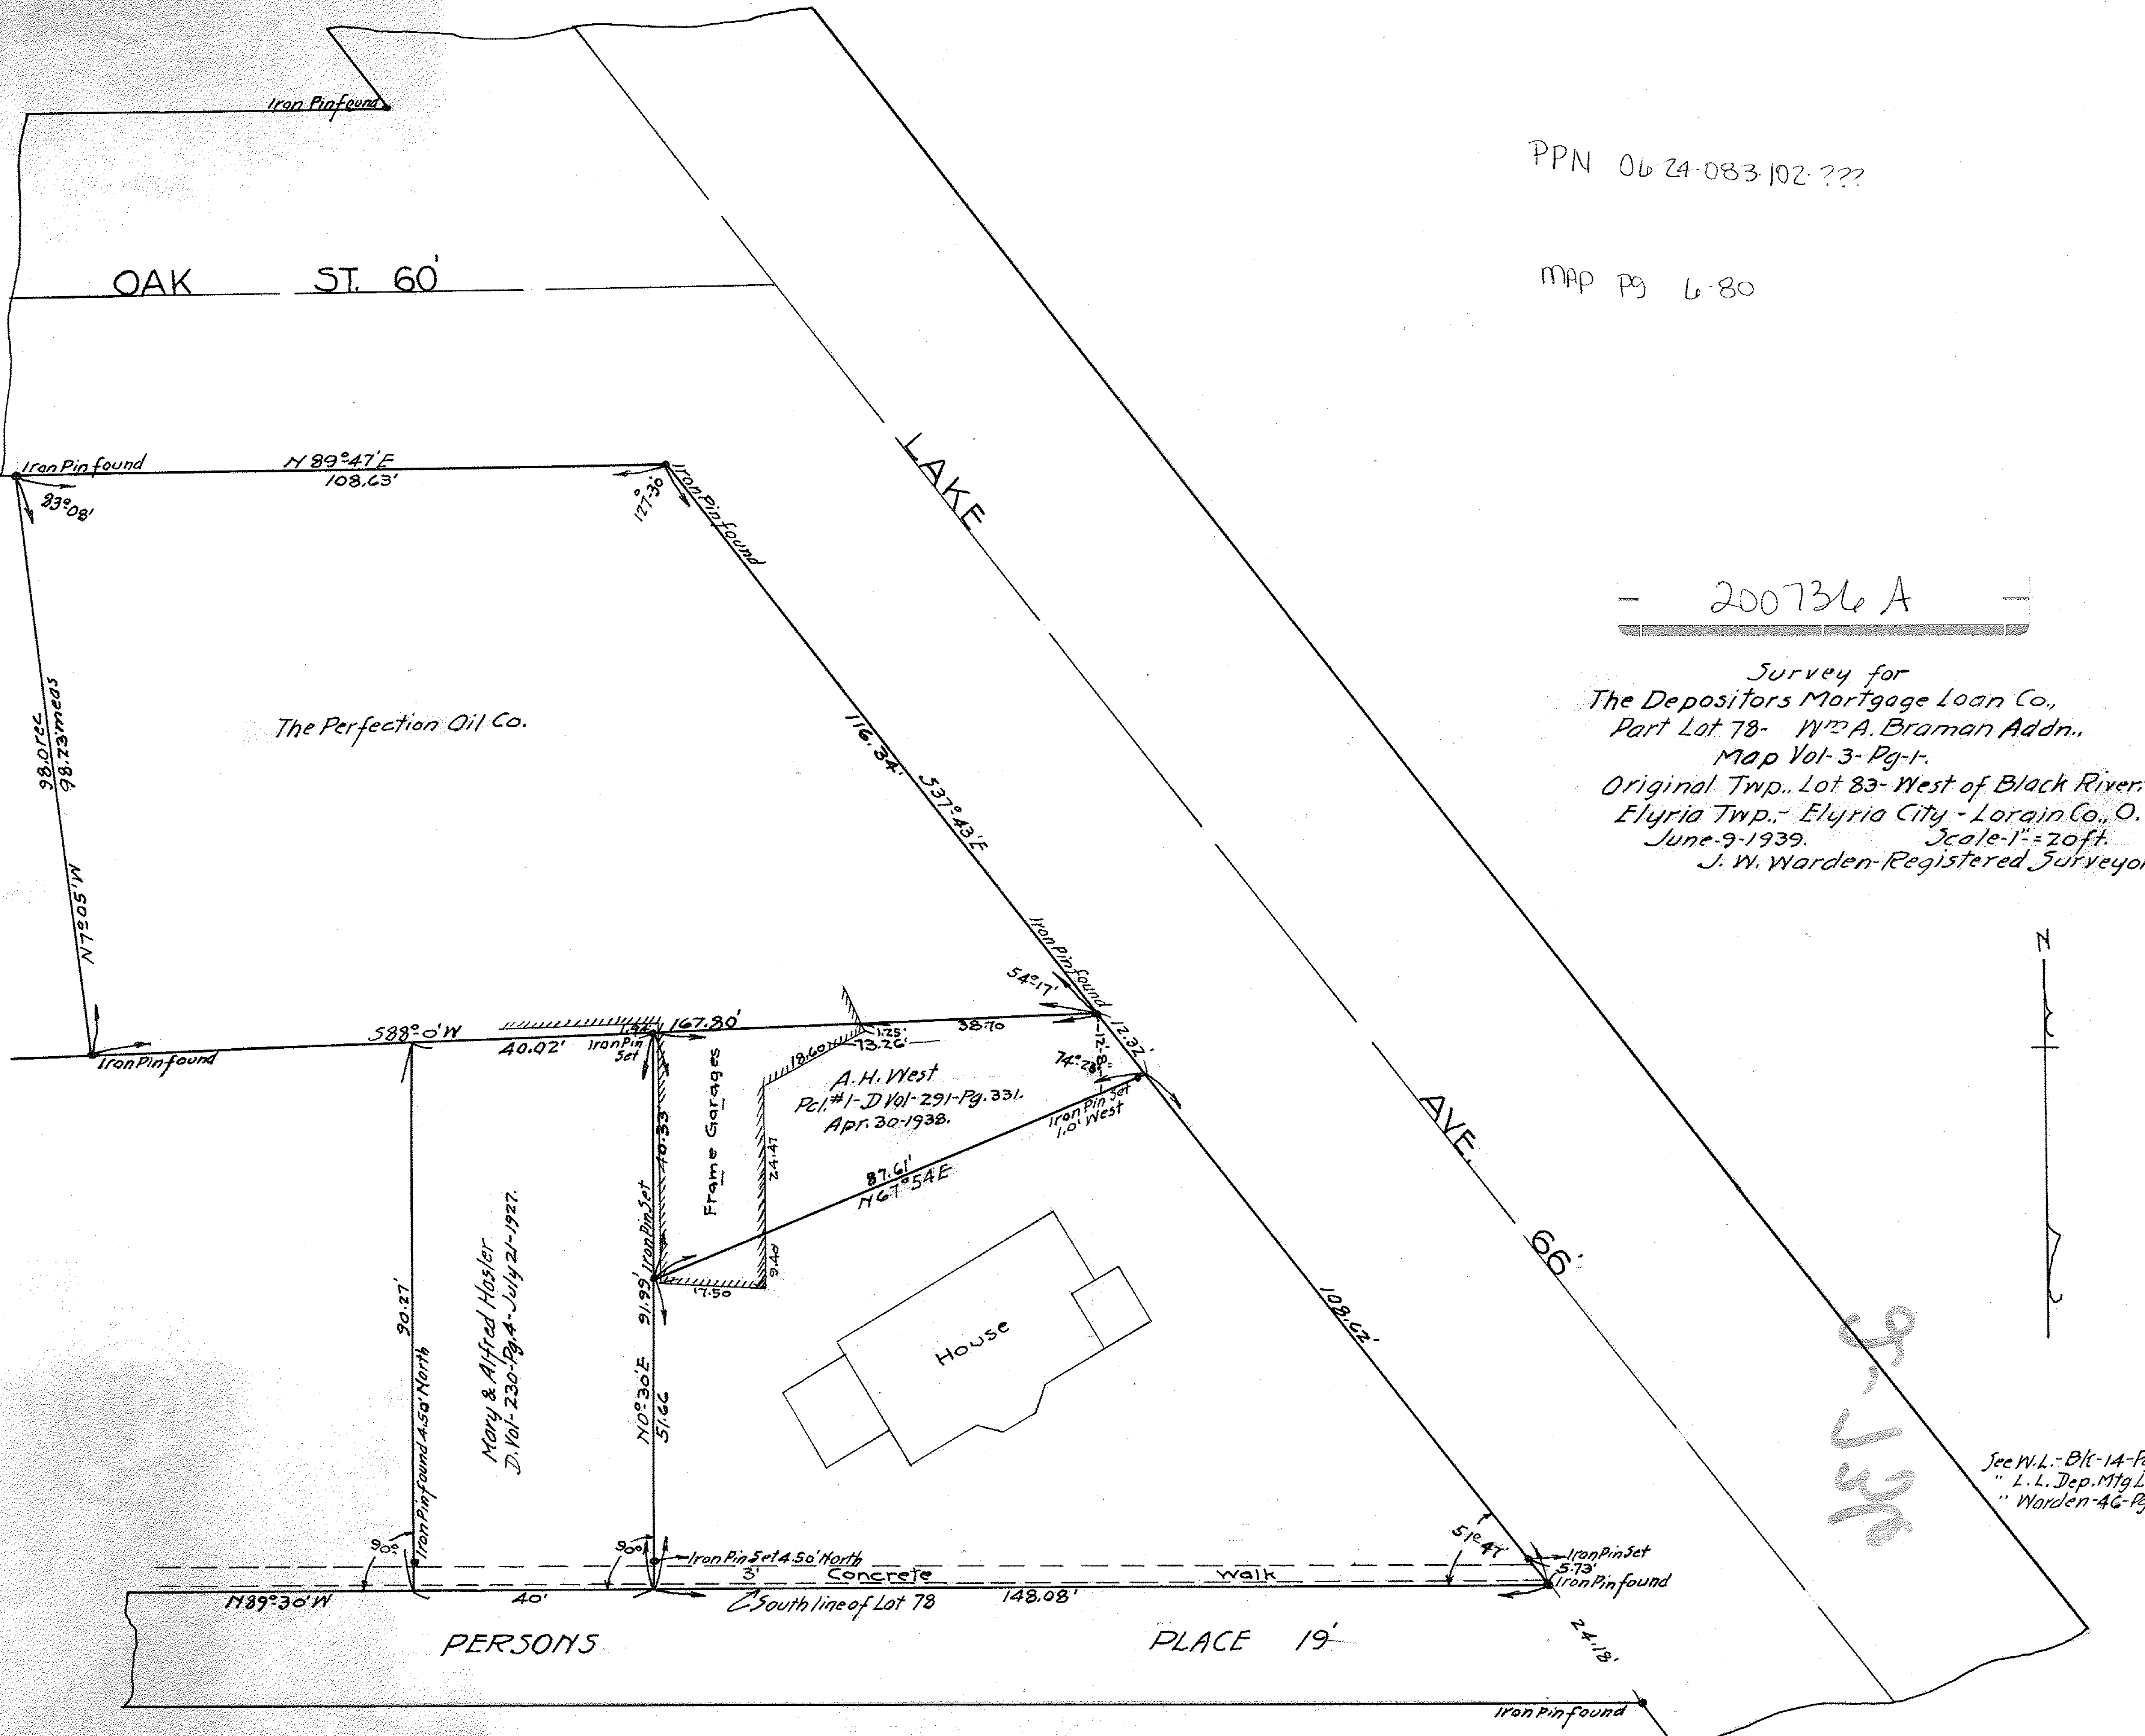

See W.L. - Blk-14-Pg 7A
" L.L. Dep. Mtg L. Co.
" Warden-46-Pg. 73

200736