SURVEY FOR

HAROLD DICKEN

LOTS 315 317 BLOCK 49

ORIG. VILLAGE PLAT MAP VOL. 3 PG. 14

ELYRIA CITY, LORAIN COUNTY, OHIO

SCALE 1" = 10' NOV. 10, 1953

J. W. WARDEN AND ASSOCIATES REG. SURVEYOR'S

200792 B

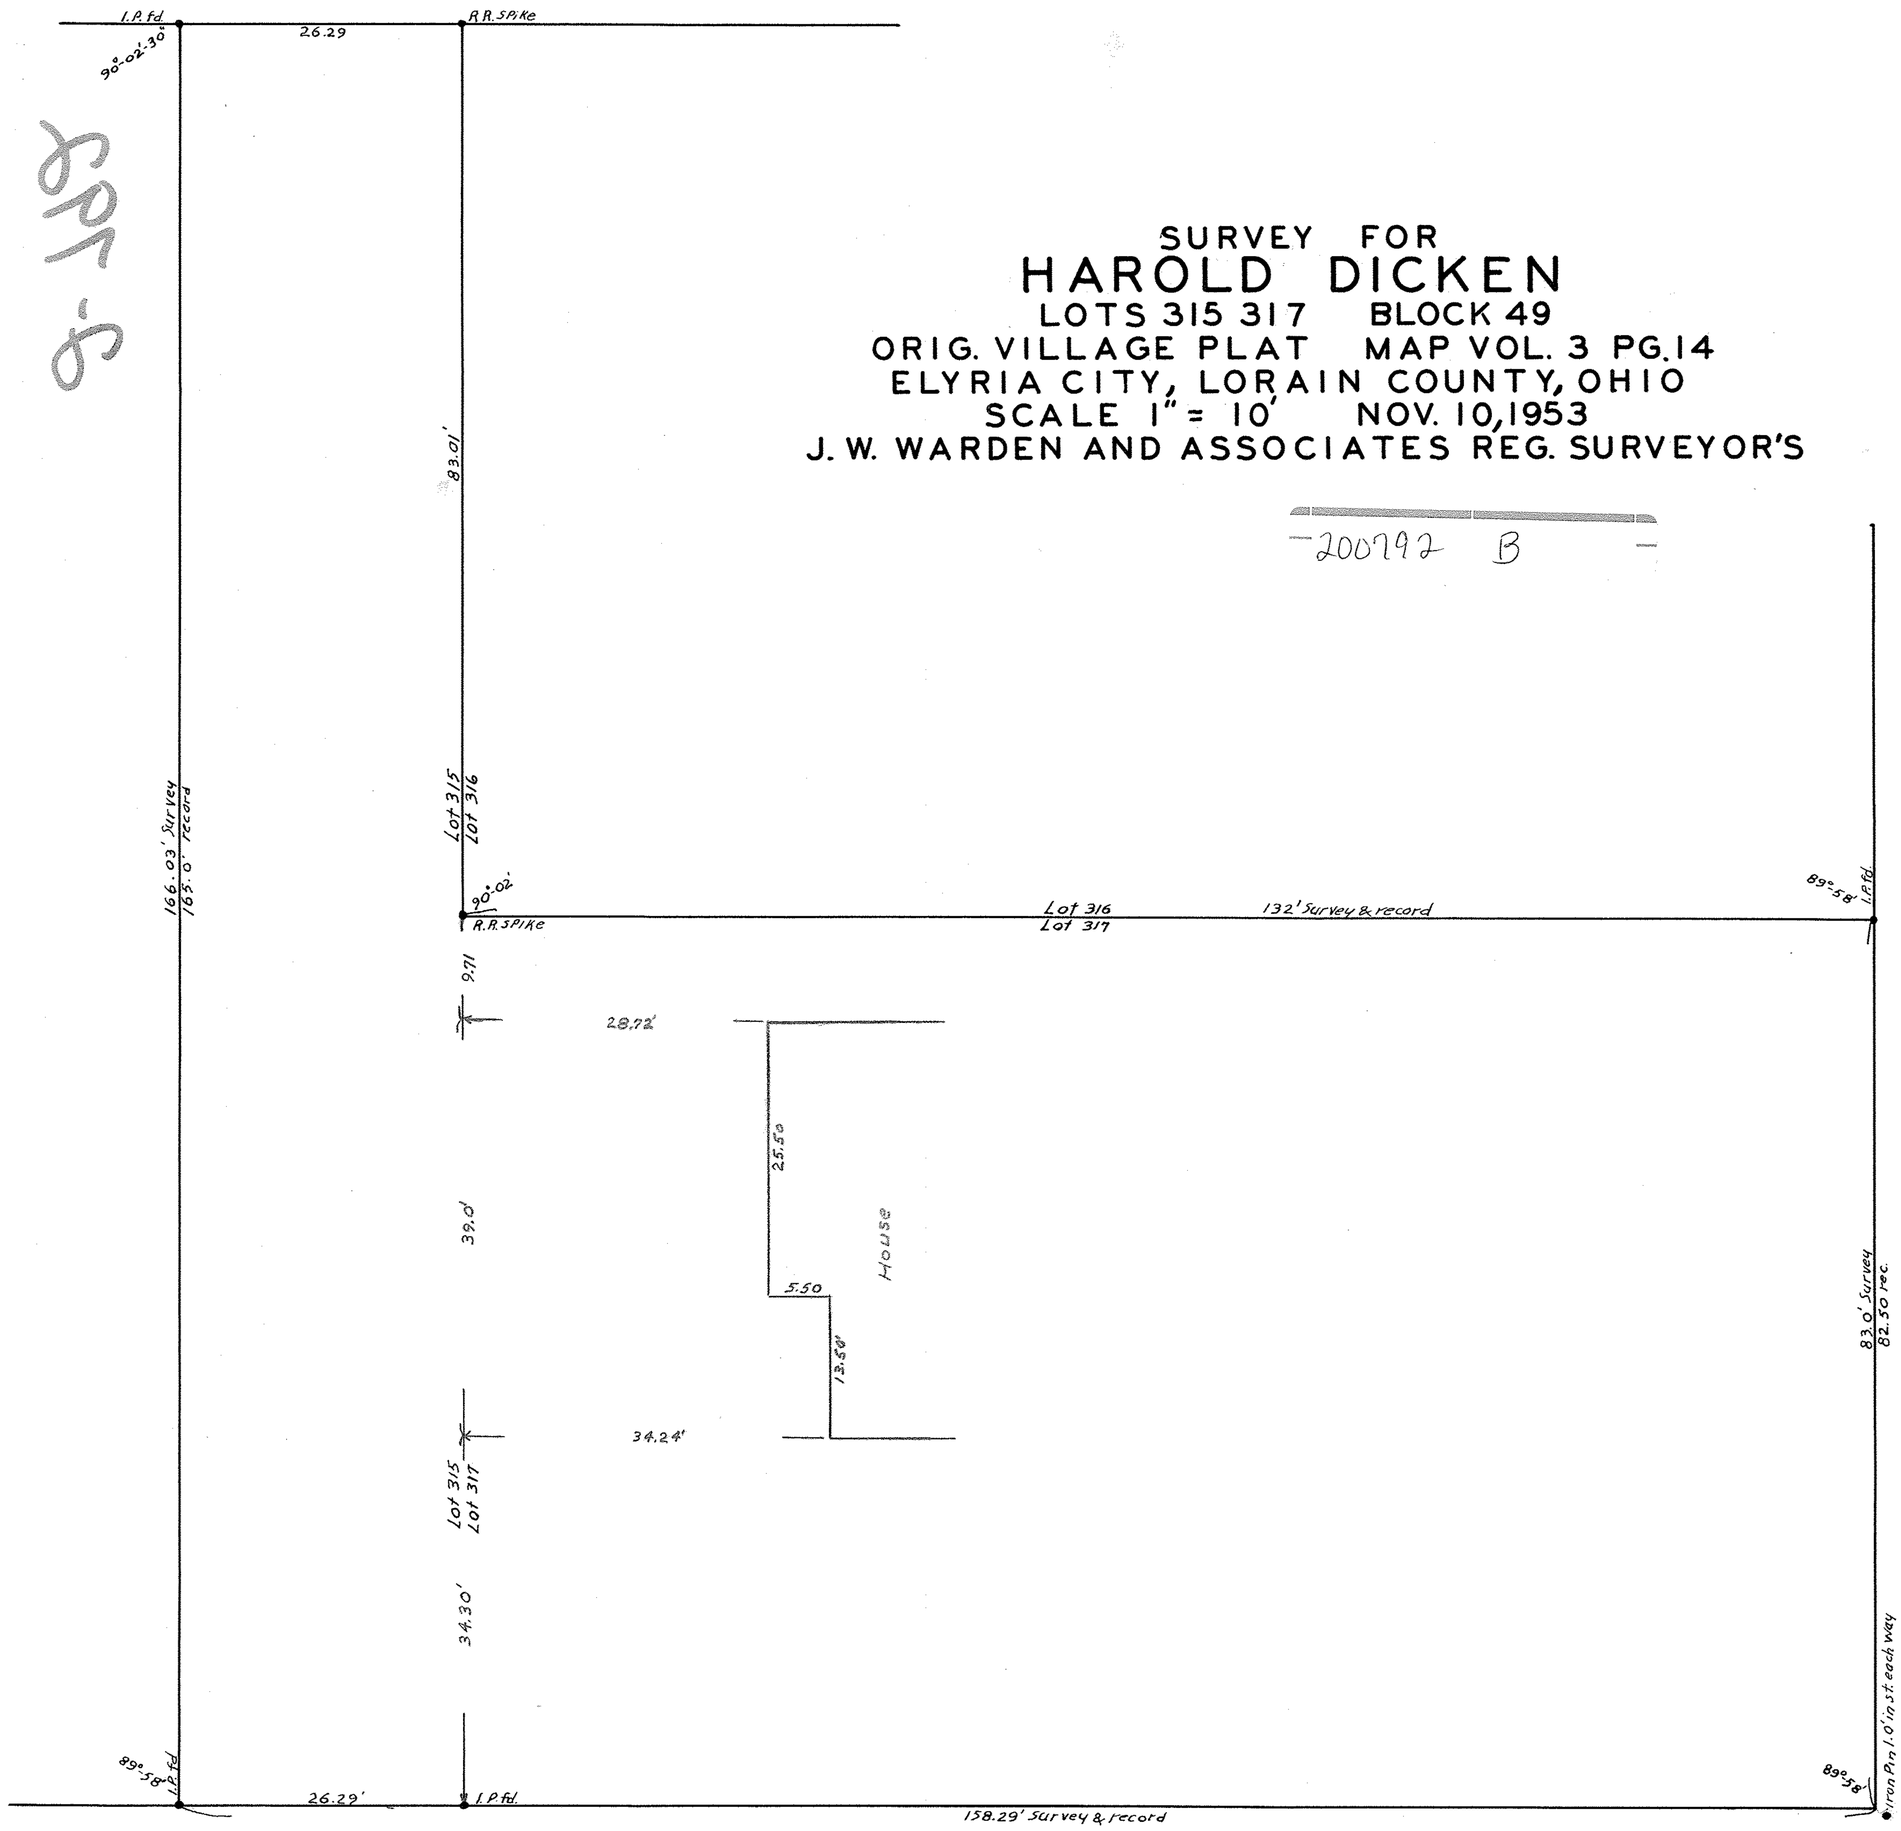

66'

MIDDLE AVE.

PPN 06-26-049-000-020
022
024

MAP PG 6-119

FOURTH STREET 66'