PPN 06-26-094-104-004.000
007
MAP PG 6-101.01

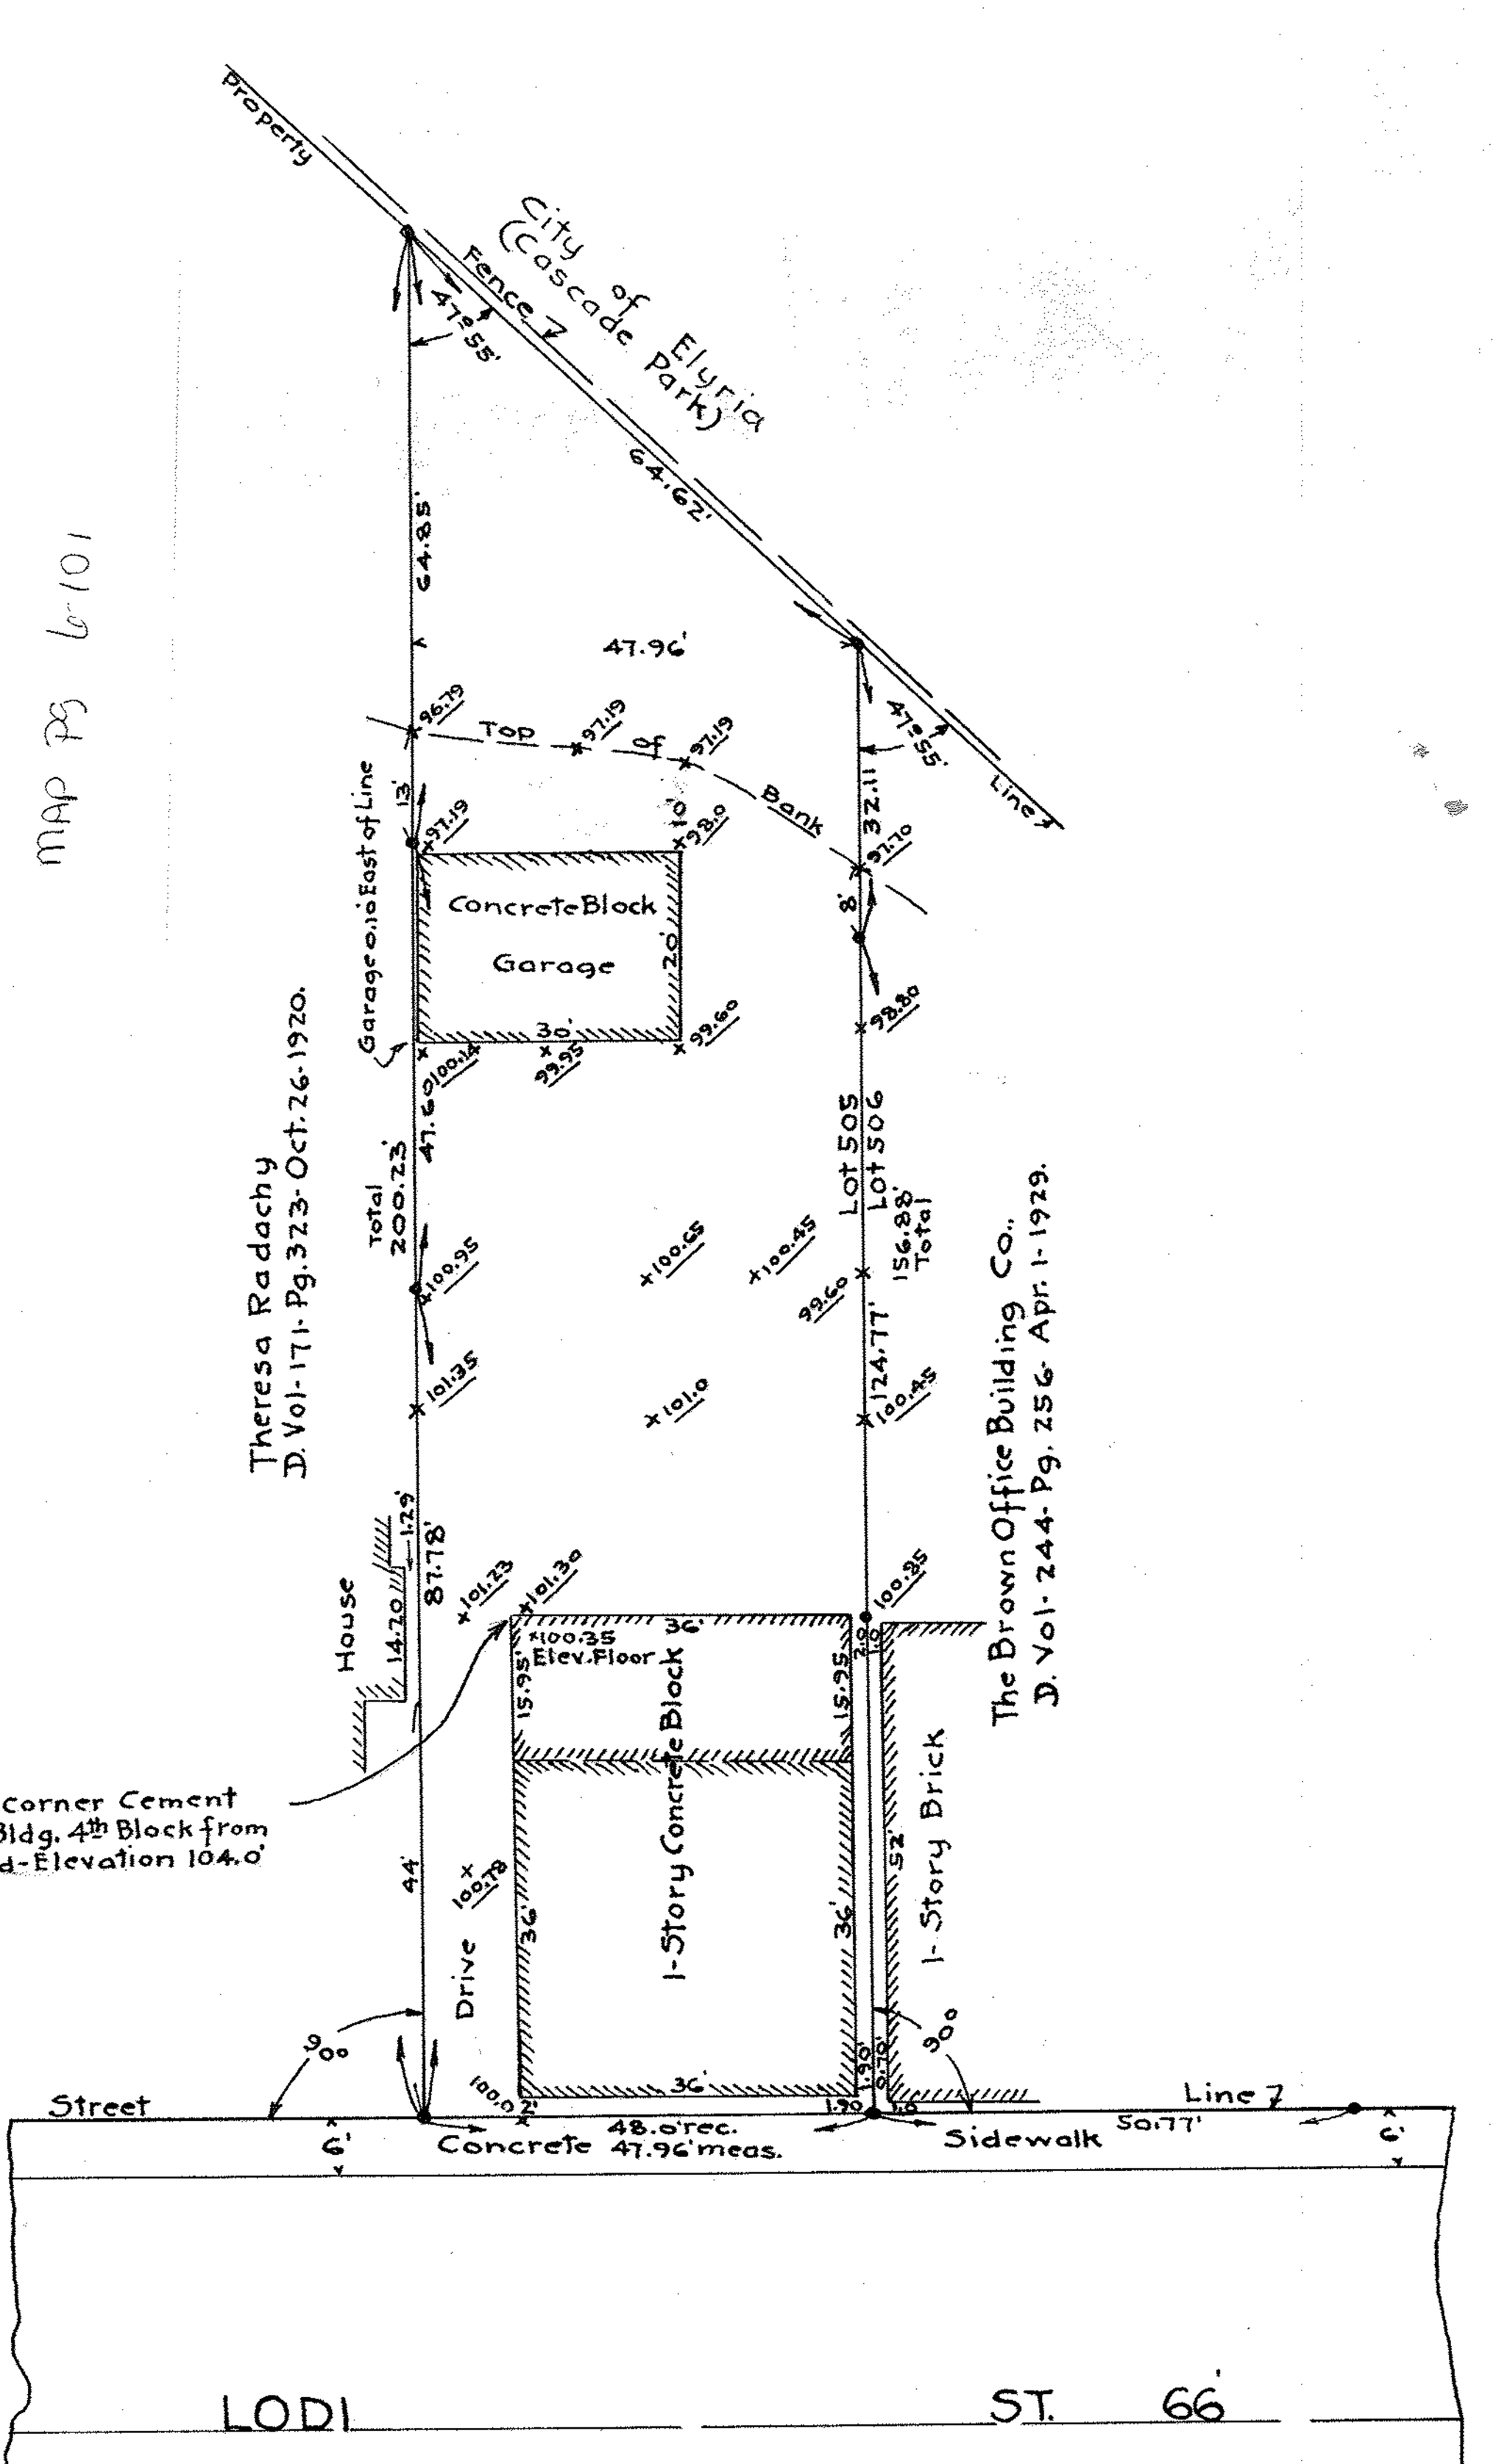

See War. Bk. 5-Pg. 28.
" L.L. Brown Co.

Note:- Iron Stakes found or set thus •
Elevations shown thus 100.0

Survey & Building Location
Andrew and Anna Wykrent.
Lot 505- W.A. Ely Subn.,
Map Vol-1- Pg. 21.
Elyria - Lorain Co., Ohio.
Jan. 31. 1929 Scale 1"= 20ft.
J.W. Warden- Registered Surveyor.

200779

9-16