Survey for
George H. & Lottie O. Long.
Lot 25. Ridgeville Twp.
Lorain Co., Ohio
Scale 1 inch = 200 ft.
Mar. 17, 1923. Warden & Saunders
Civil Engineers.

PPN 07-00-025-101-???

MAP P3 07-00-025-A
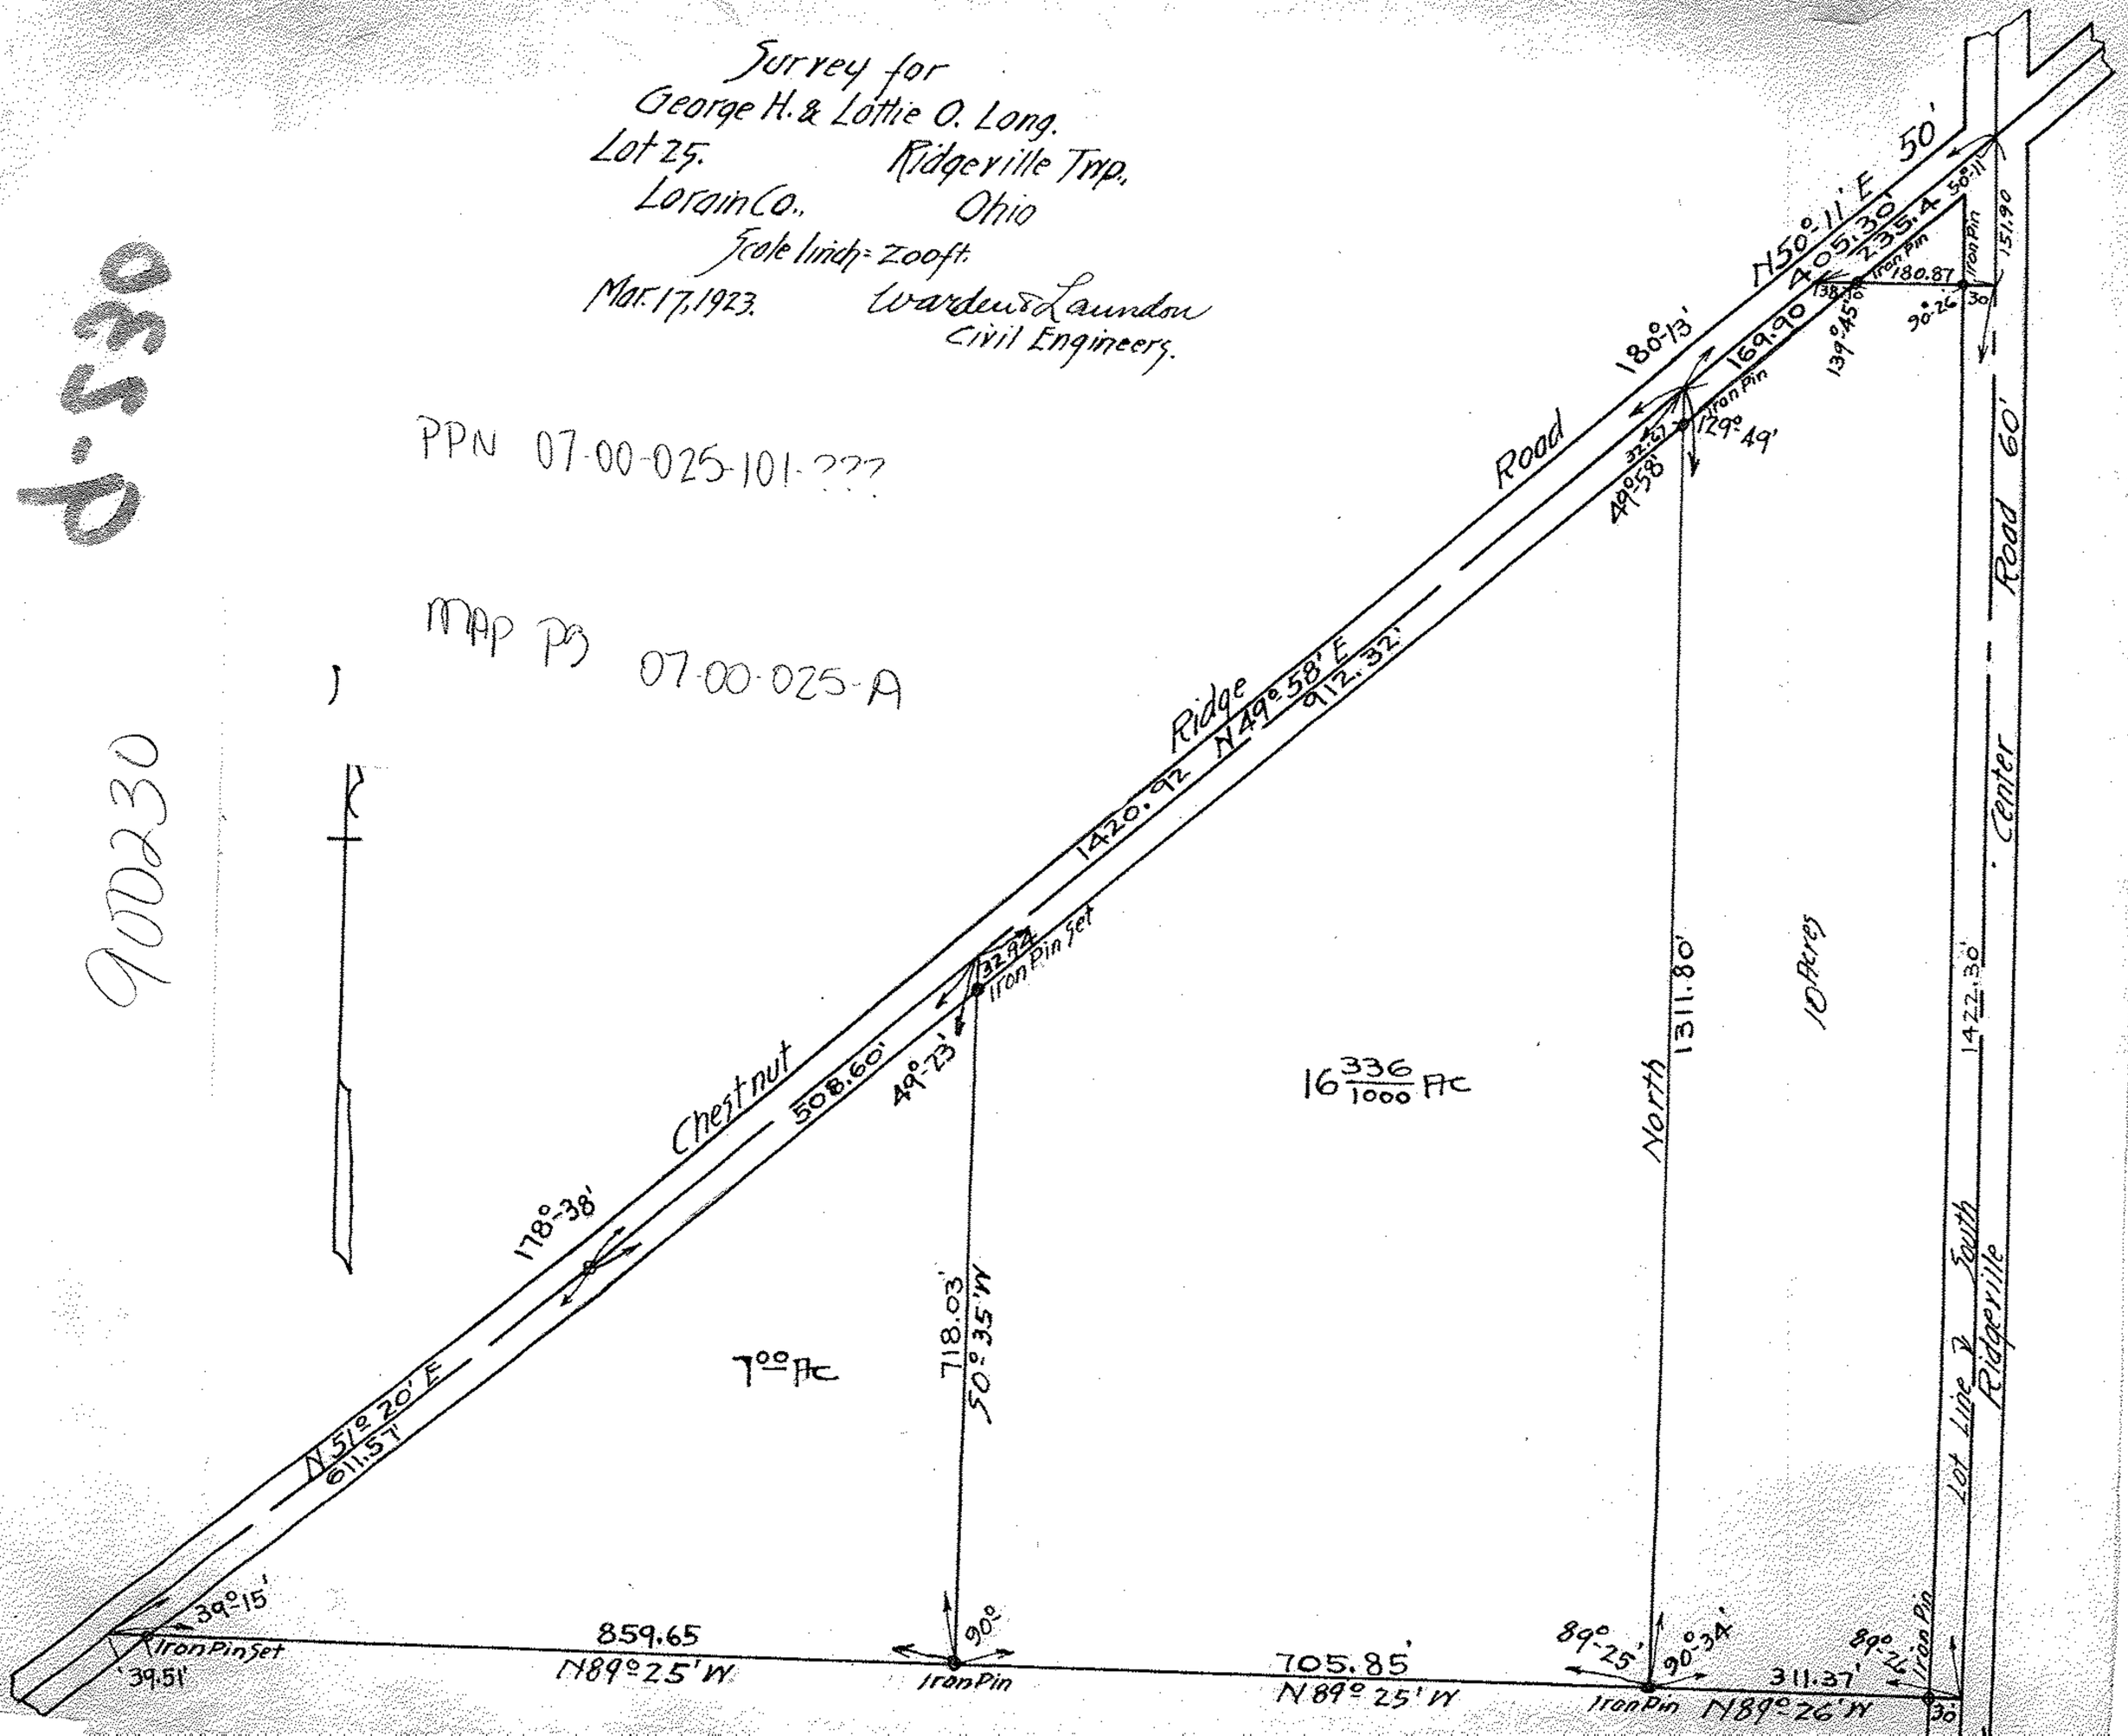
